

5999

328
184


4.52

497
420

77 AC

497
137

60

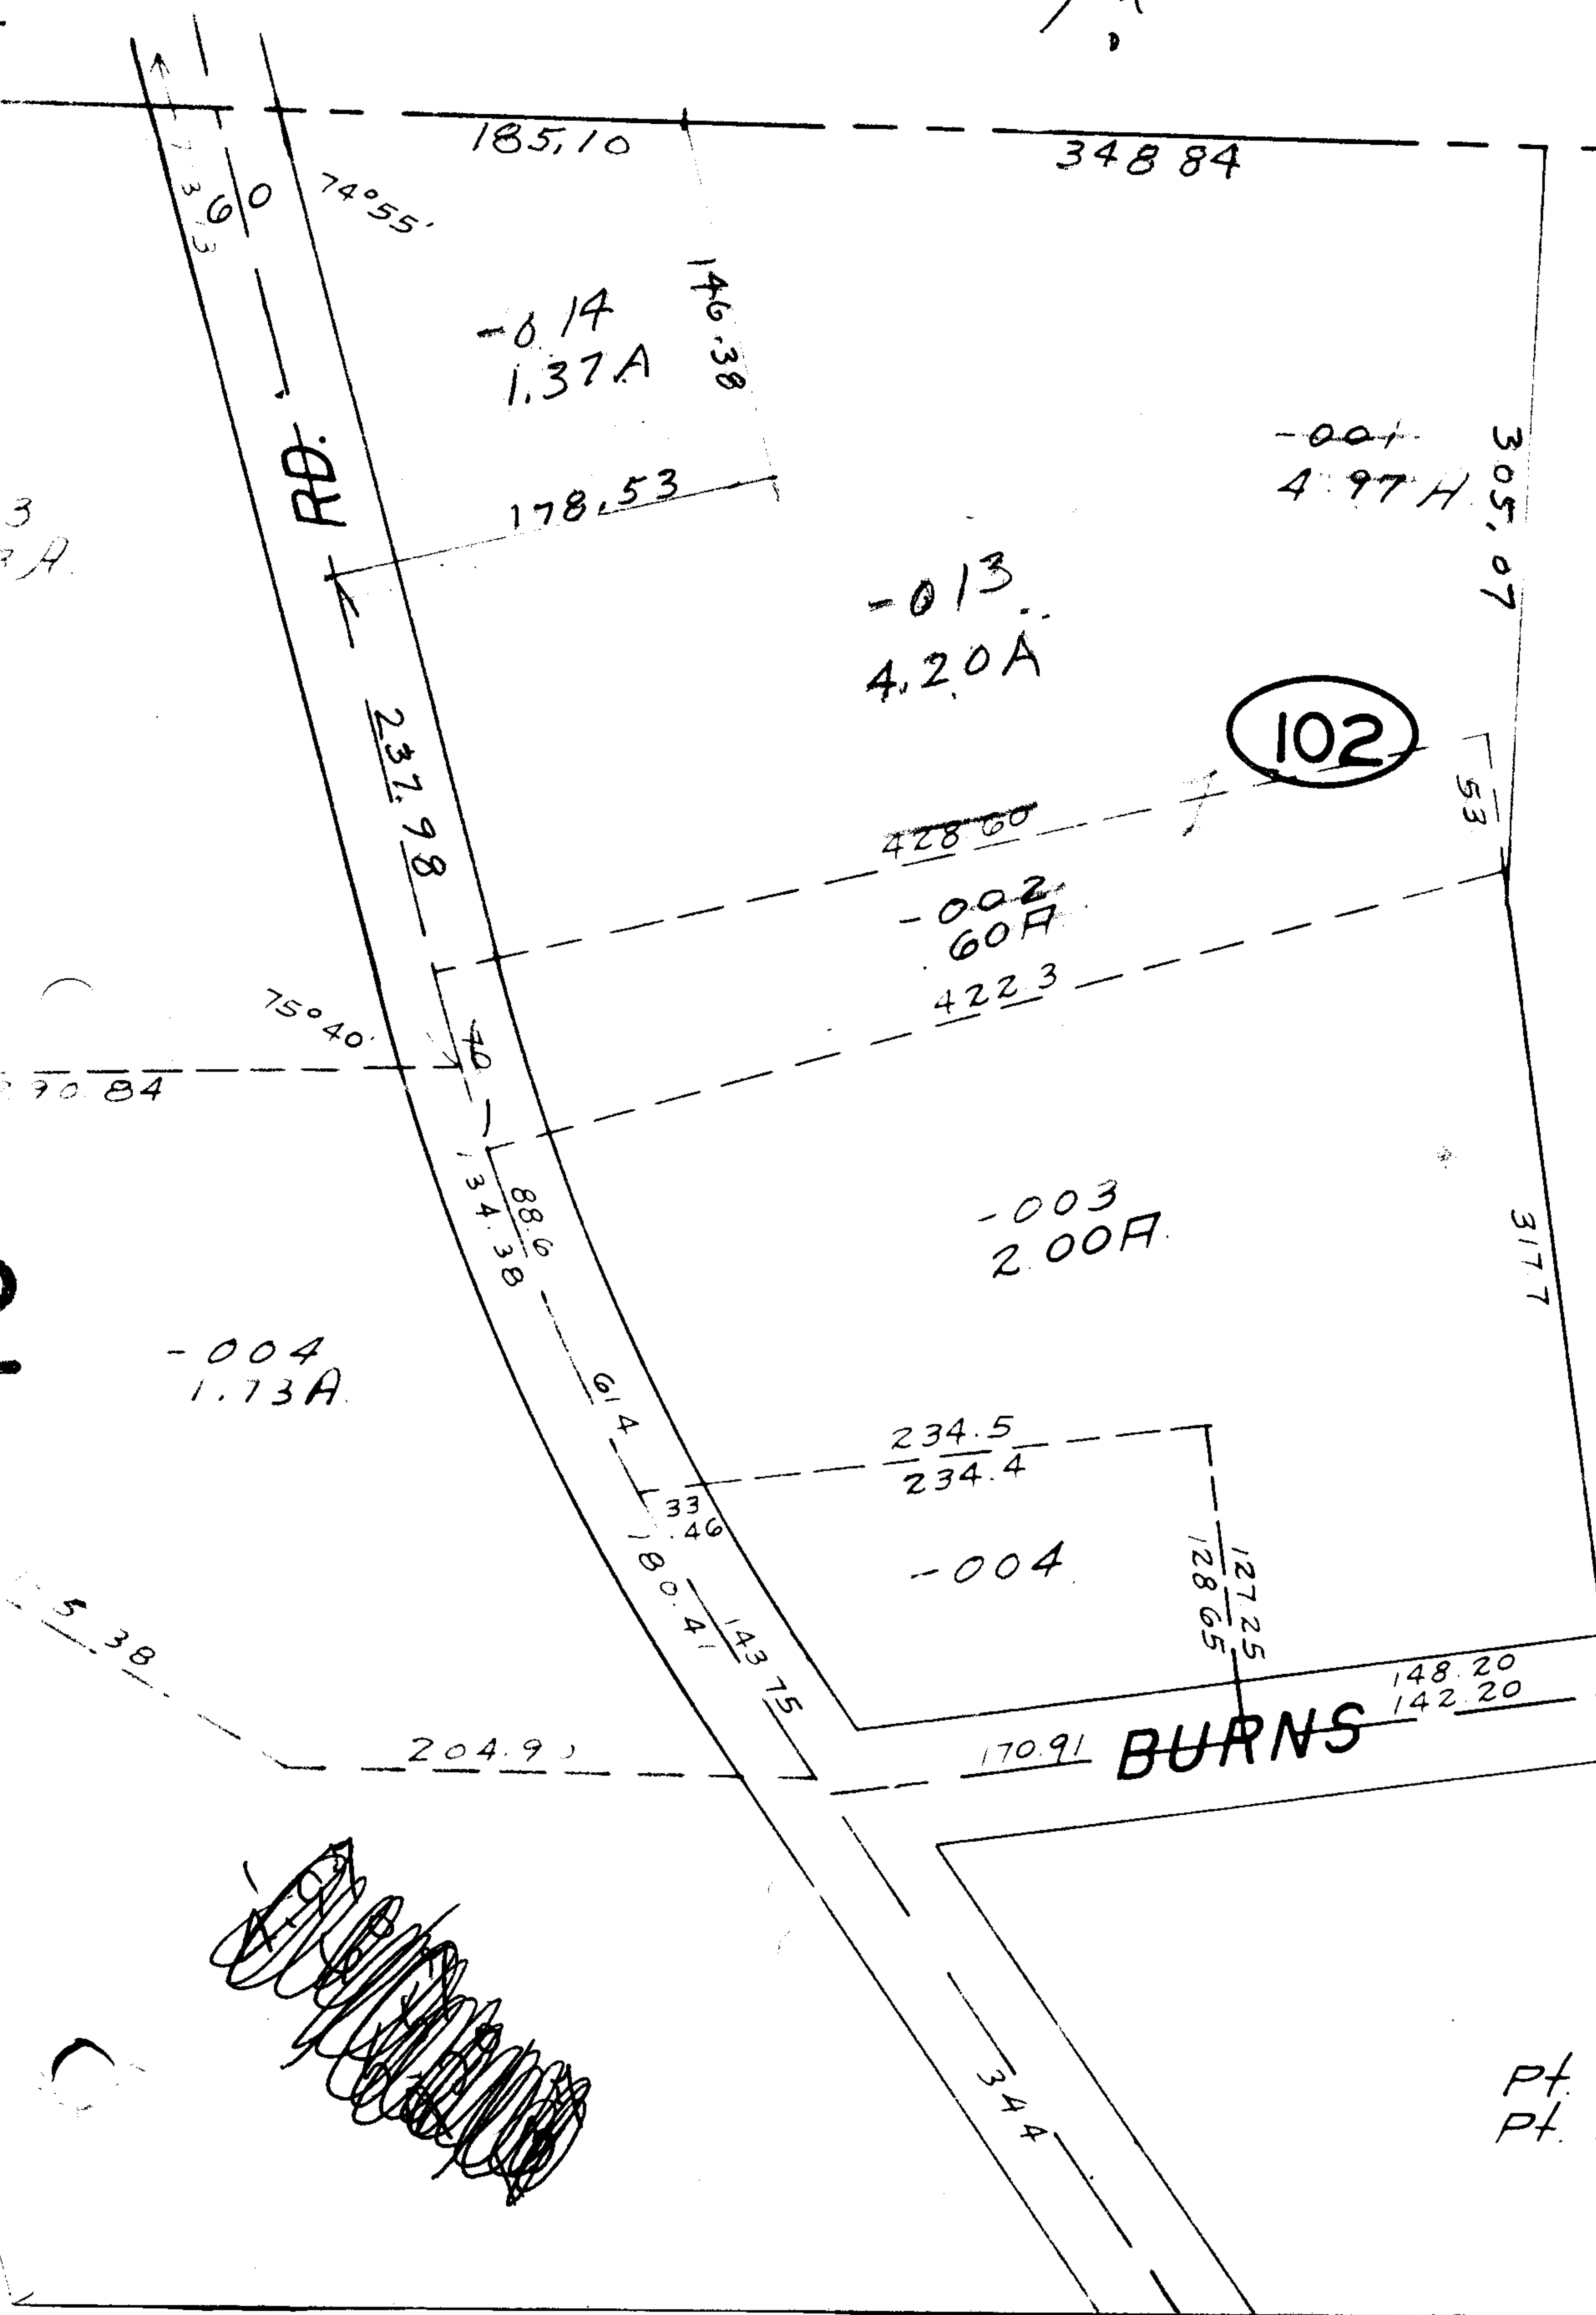

APPROVED
LORAIN CO.
MAP DEPT.
DATE 6/14/72
C-33
BY
R. J. Kelling

104

Pt. -001
Pt. 5.00F.