


6028

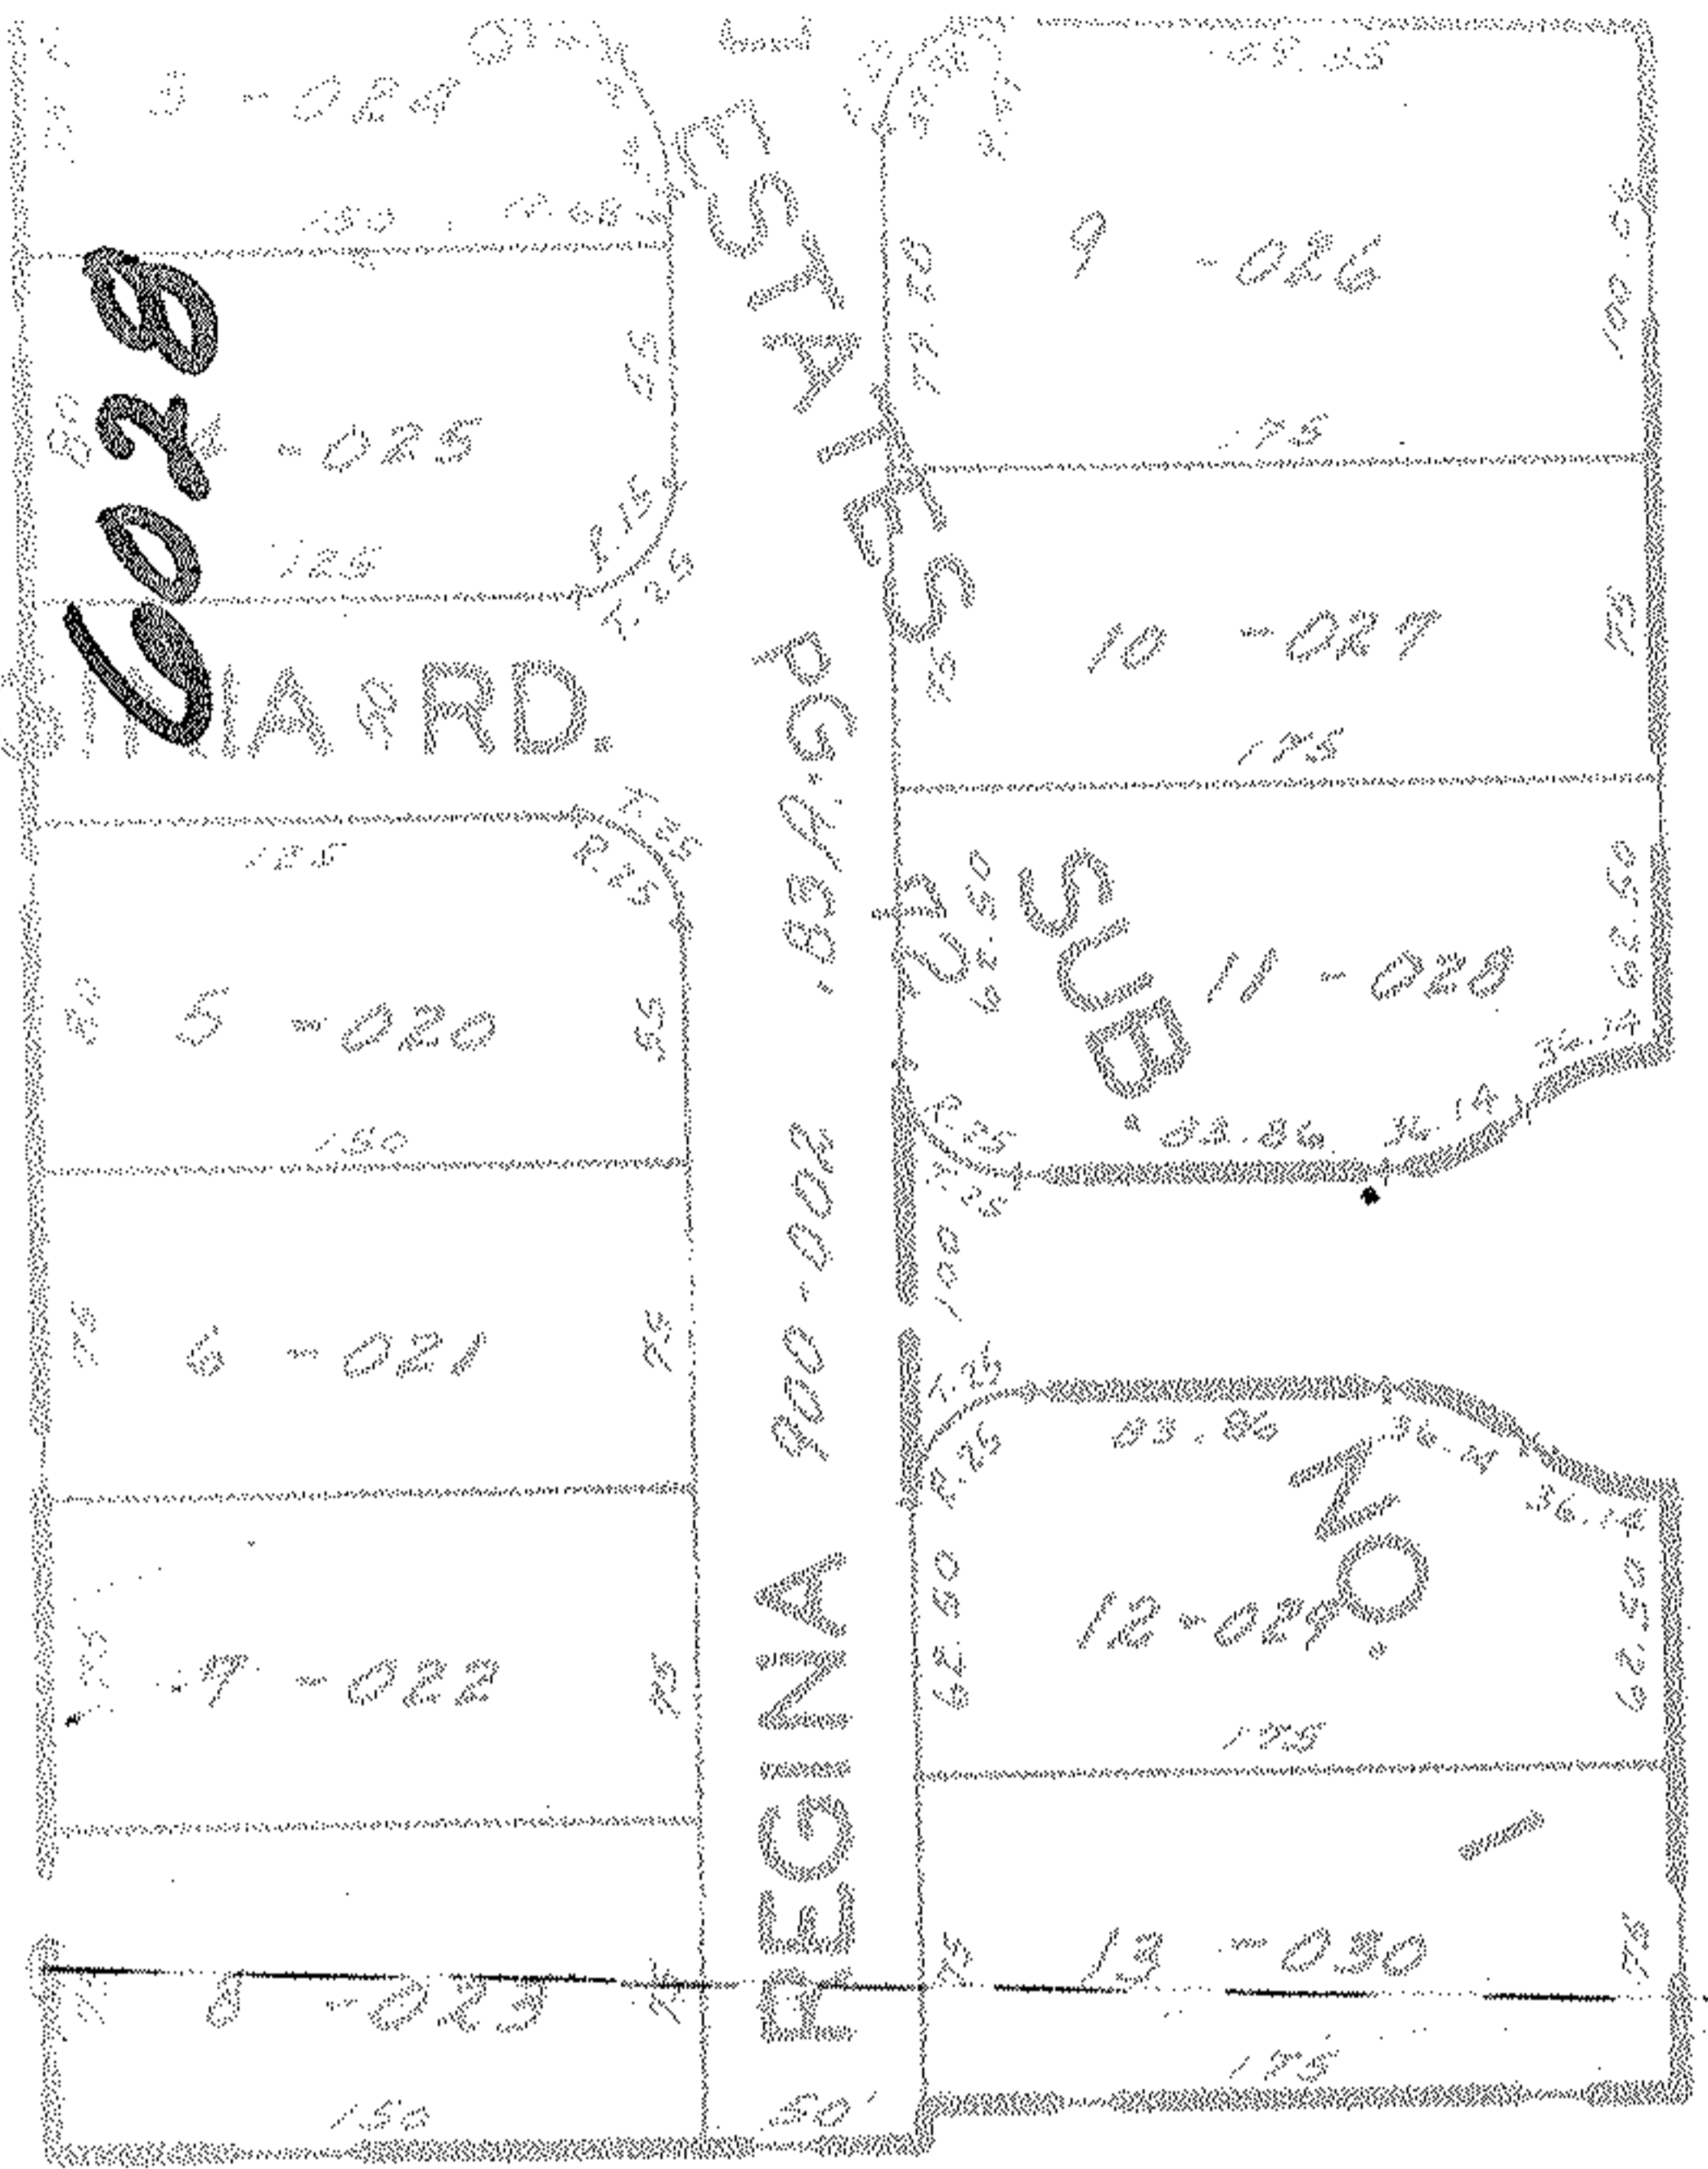

REGINA 900-002

SUB

6028


APPROVED
 LORAIN CO.
 MAP DEPT.
 DATE 6-23-72
 LCO-004-D
 BY [Signature]

-036 ✓
7.42 A.

~~034~~
8.06 A.

~~031~~
2.52 A.

-019
2.10 A.

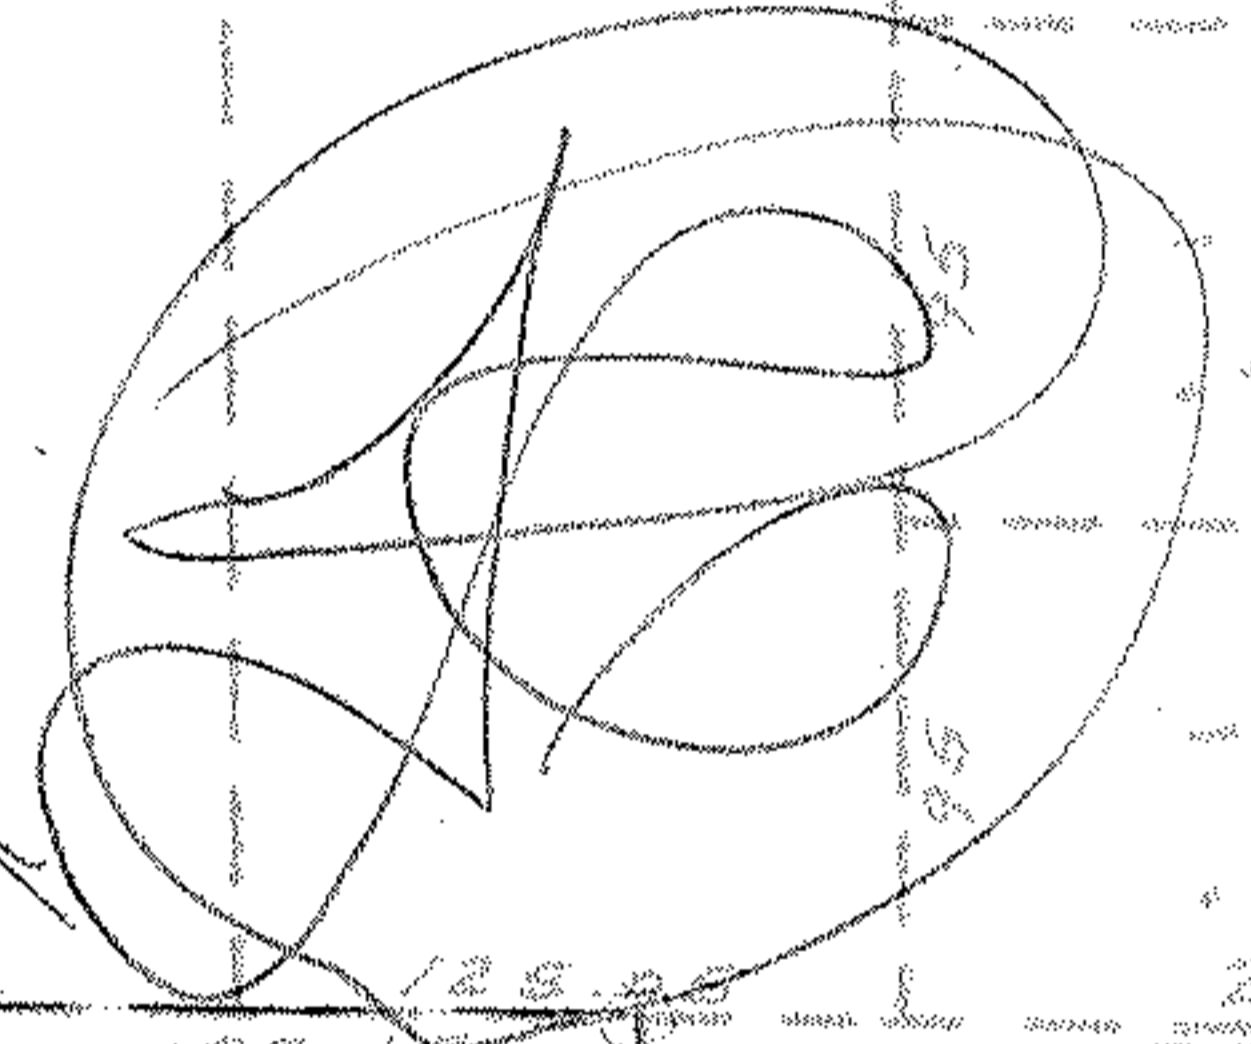

892.60

Trump
Sheet
checked
OK

-032 ✓
7.87 A.

-008
.52 A.
250

-035
8.64 A.

-033
1.06 A. ✓
230

346.57

909

130
SOUTH
110 94