

2580.60

112.45

133.12

192.77

6030

6030

APPROVED  
LORAIN CO.  
MAP DEPT.

DATE 6-26-72


7-00-025-B

BY *[Signature]*

101

Change Number &  
Acreage on Page  
7-00-025-A

-043  
Pt. ~~041~~  
Pt. ~~1851A~~  
17.82

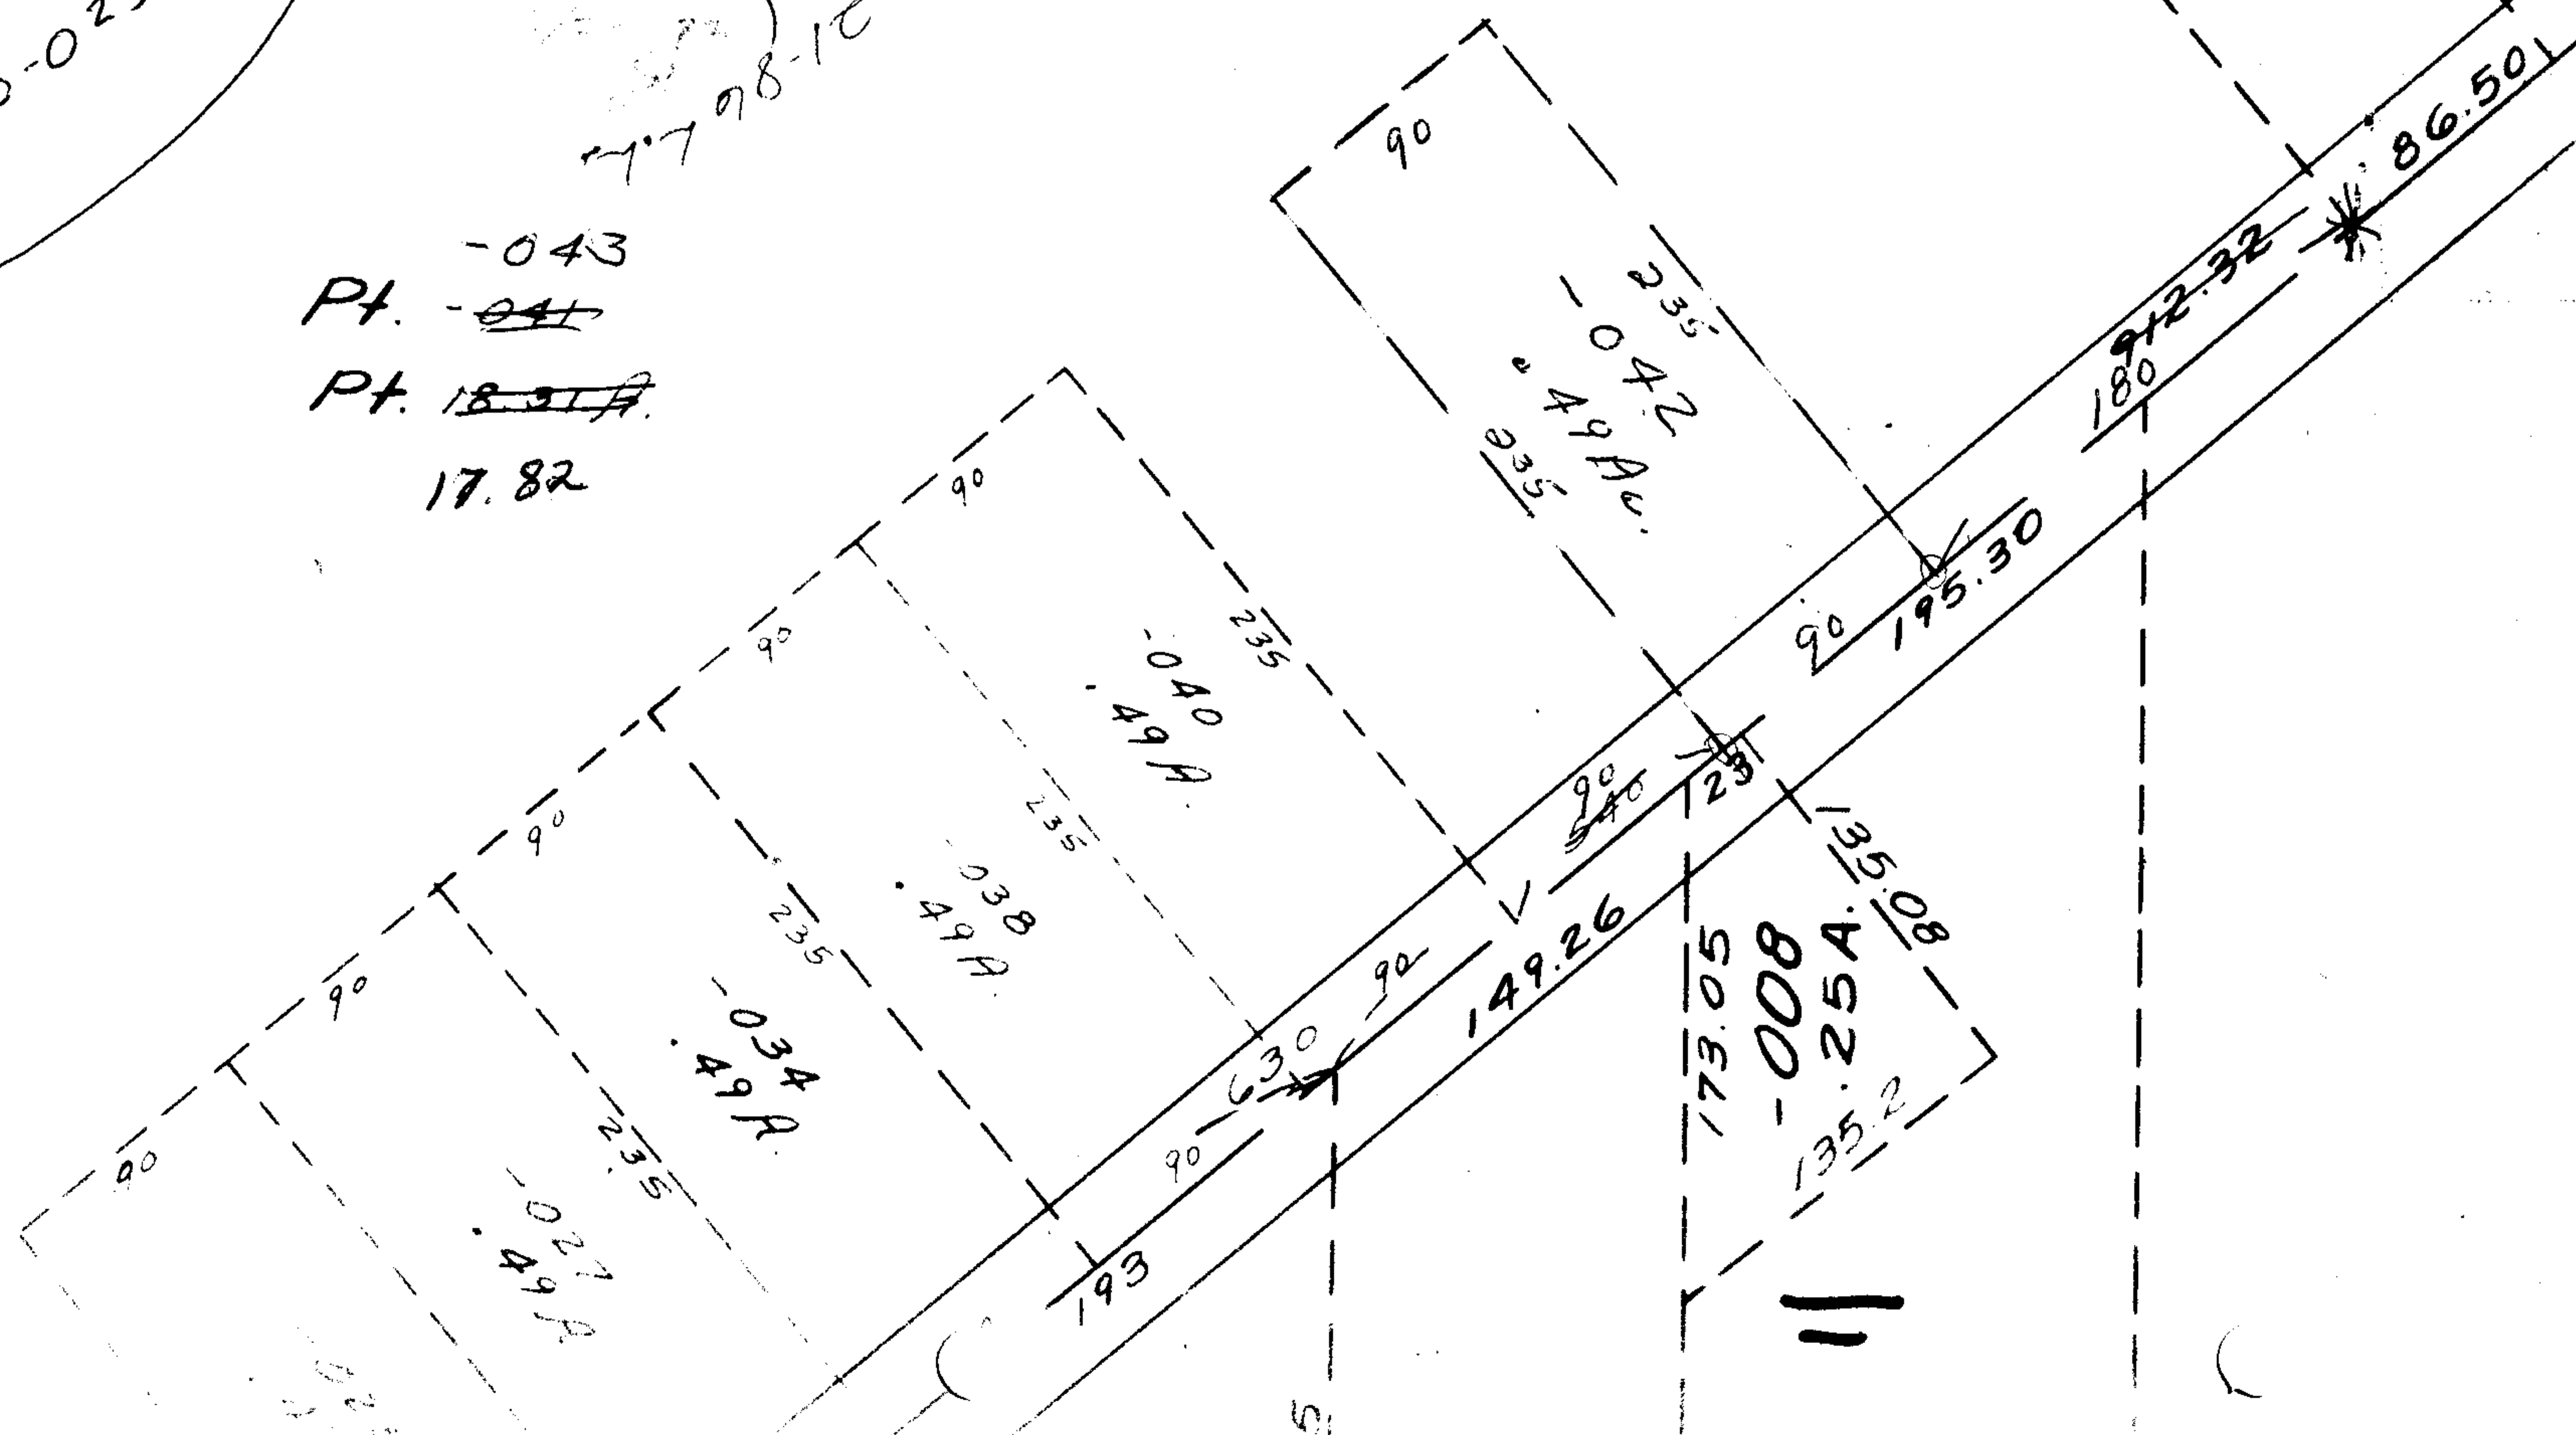

7-00-025-A

