

6032

Pt. -058
Pt. 35.97

6032

APPROVED
LORAIN CO.
MAR DEPT.

DATE 6-23-72


4-00-01-E

BY *Hubert*

7-21-81

4/15-72
JT

135.78
339.45
475.23

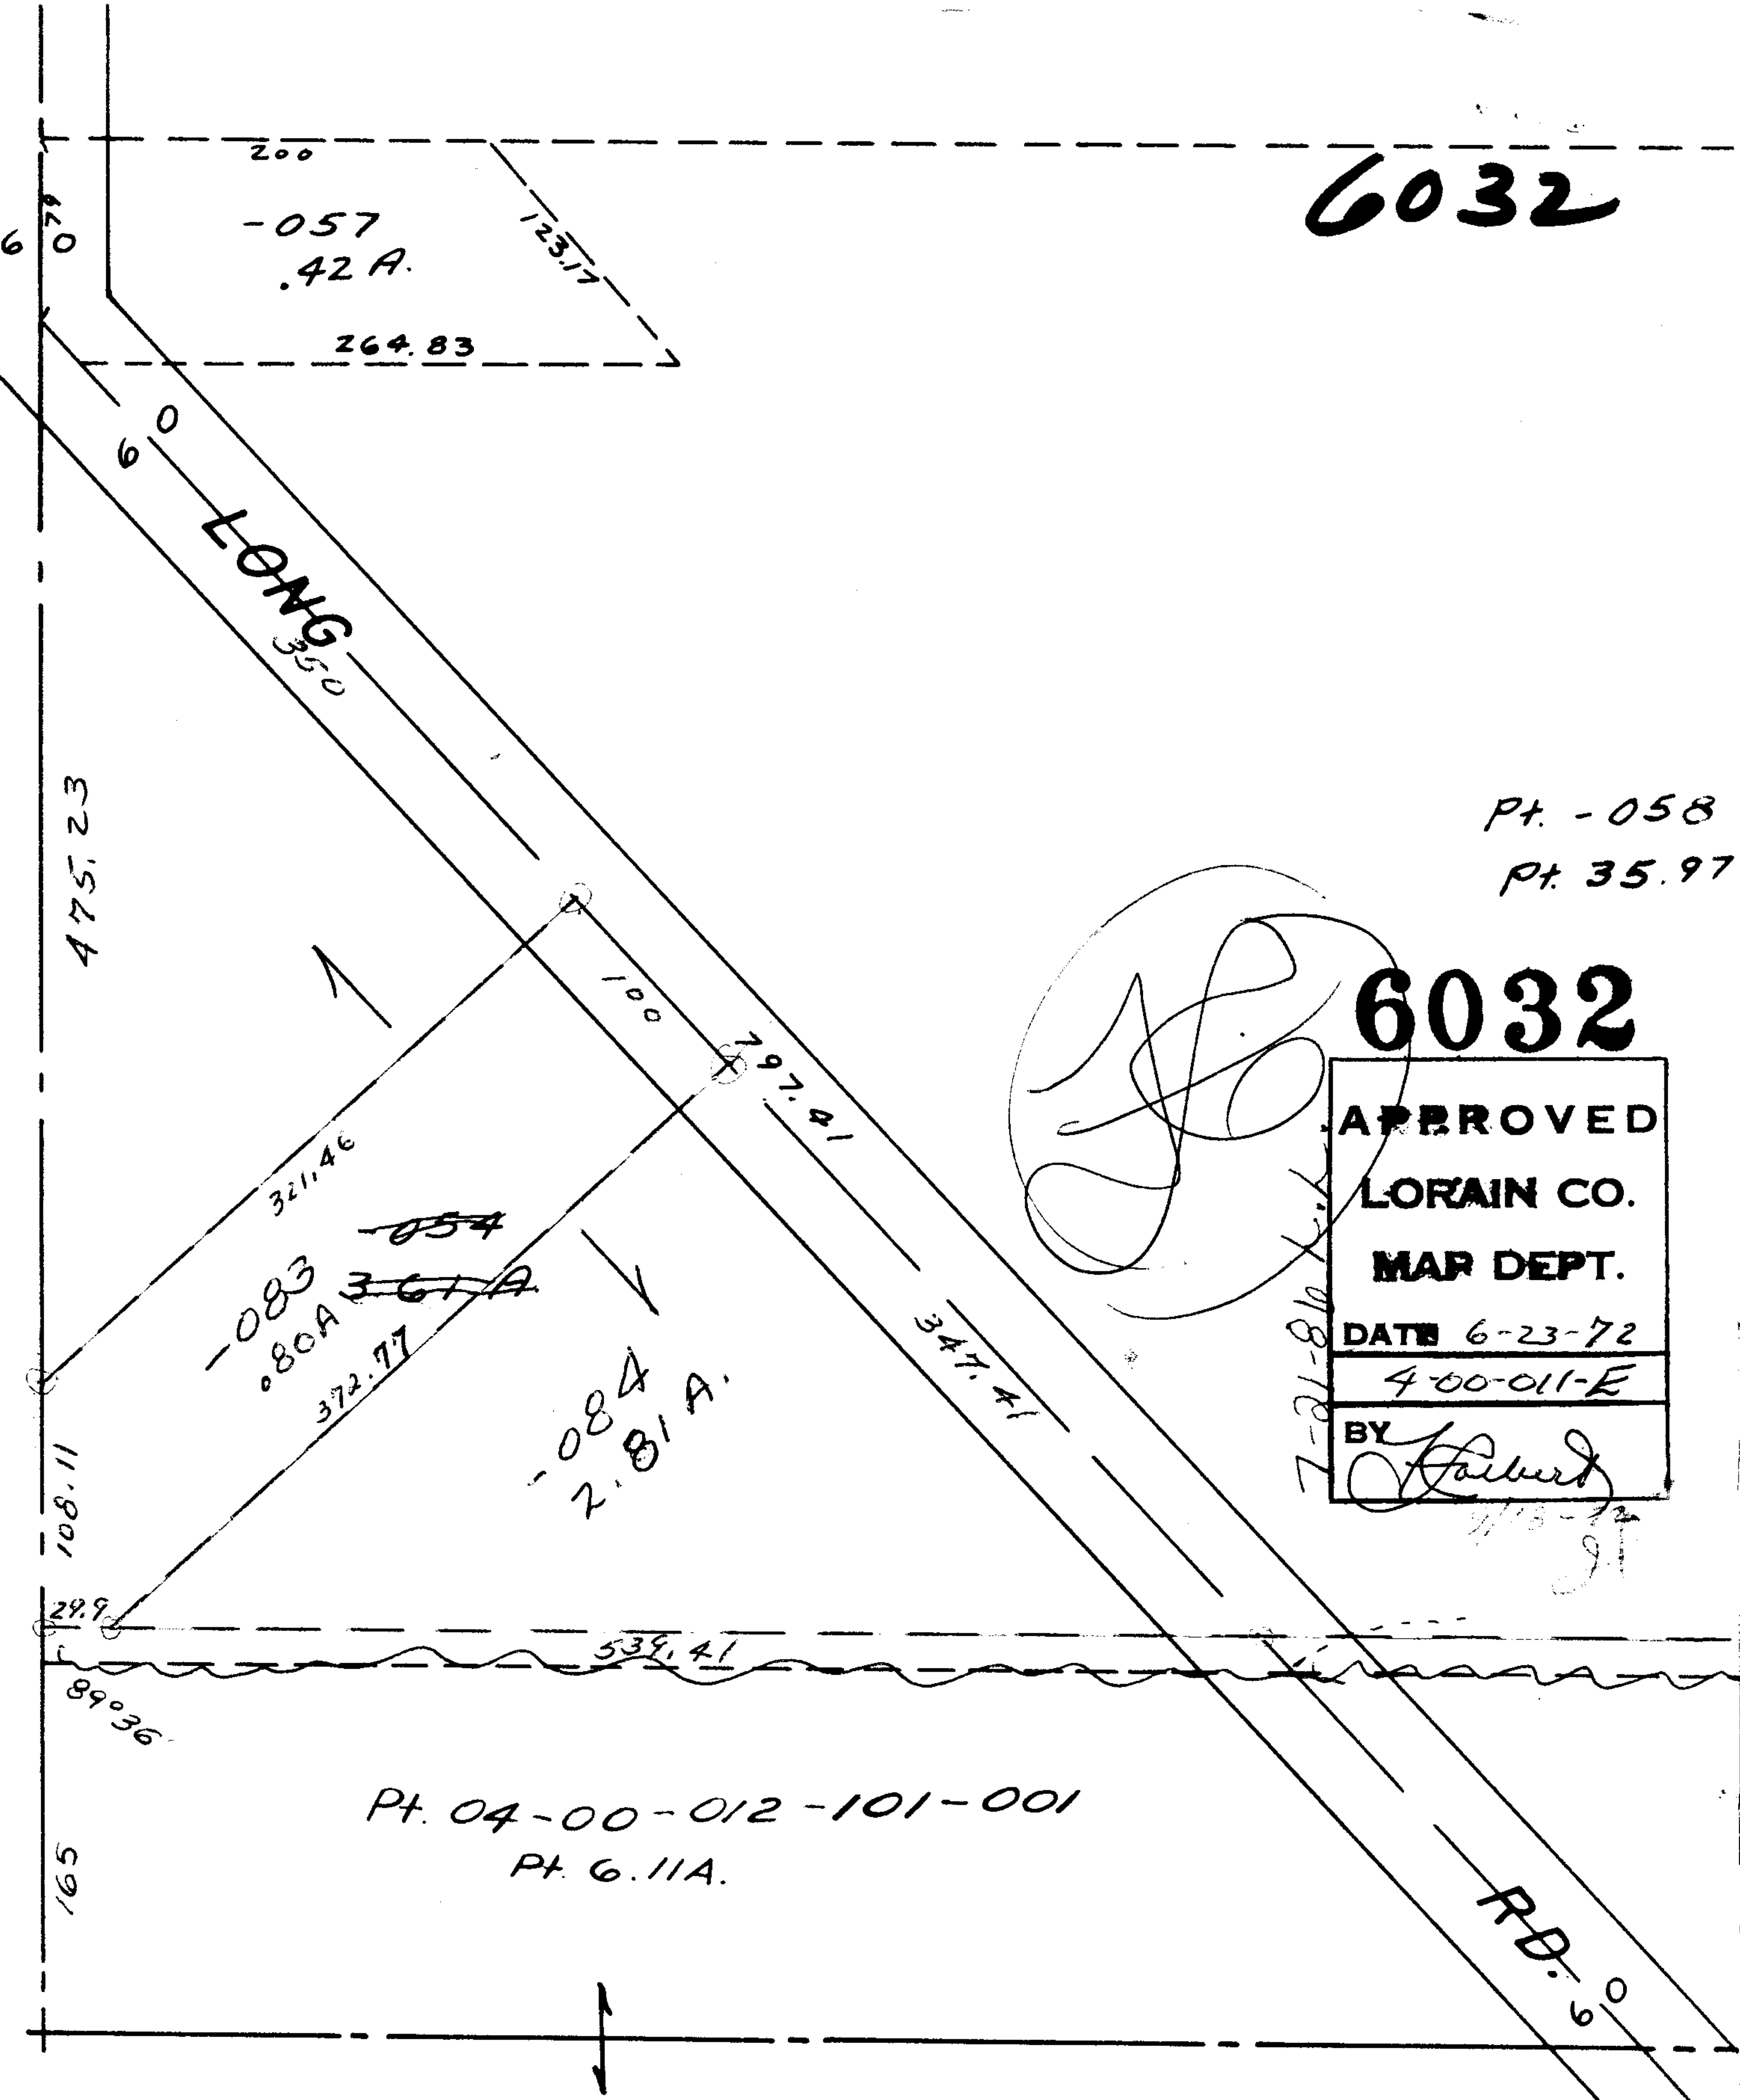

Pt. 04-00-012-101-001
Pt. 6.11A.

R.D. 60

SEE 4-00