


6059



6059

APPROVED  
LORAIN CO.  
MAP DEPT.  
DATE 7-3-72  
10-00-004 B  
BY *Lodner*

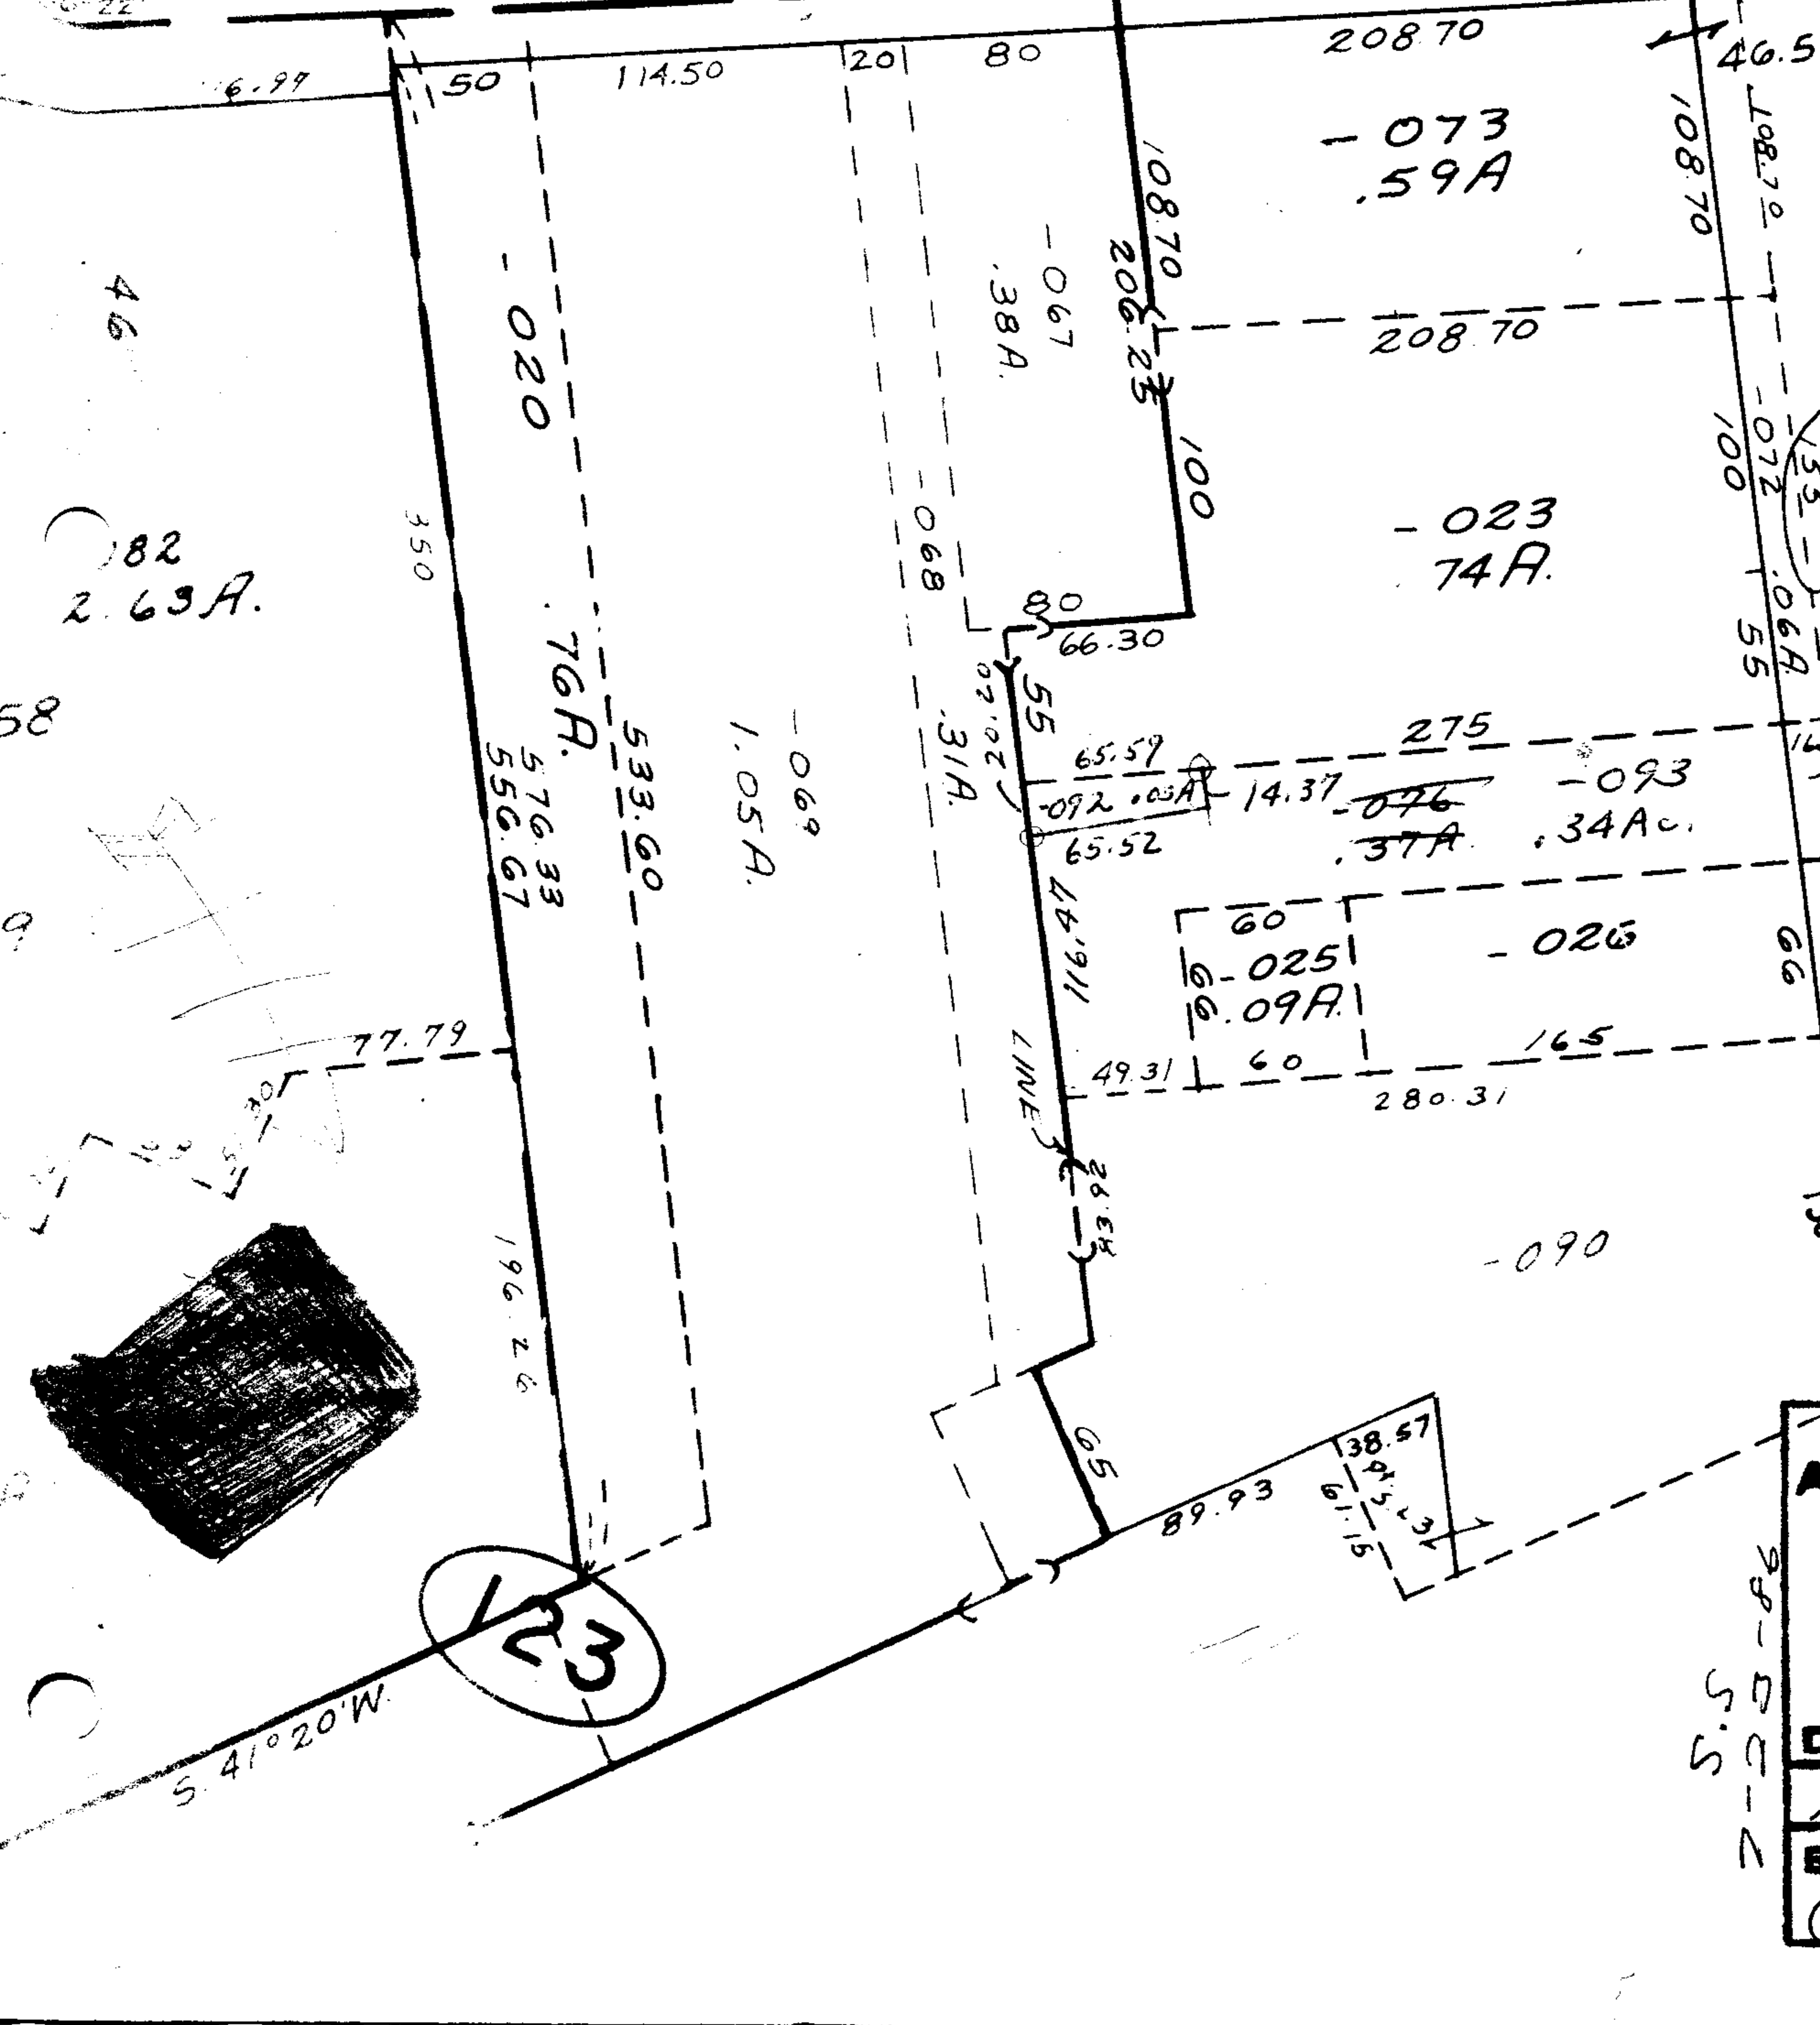