


SEE 7-00-014

EX 6

14.00
6061

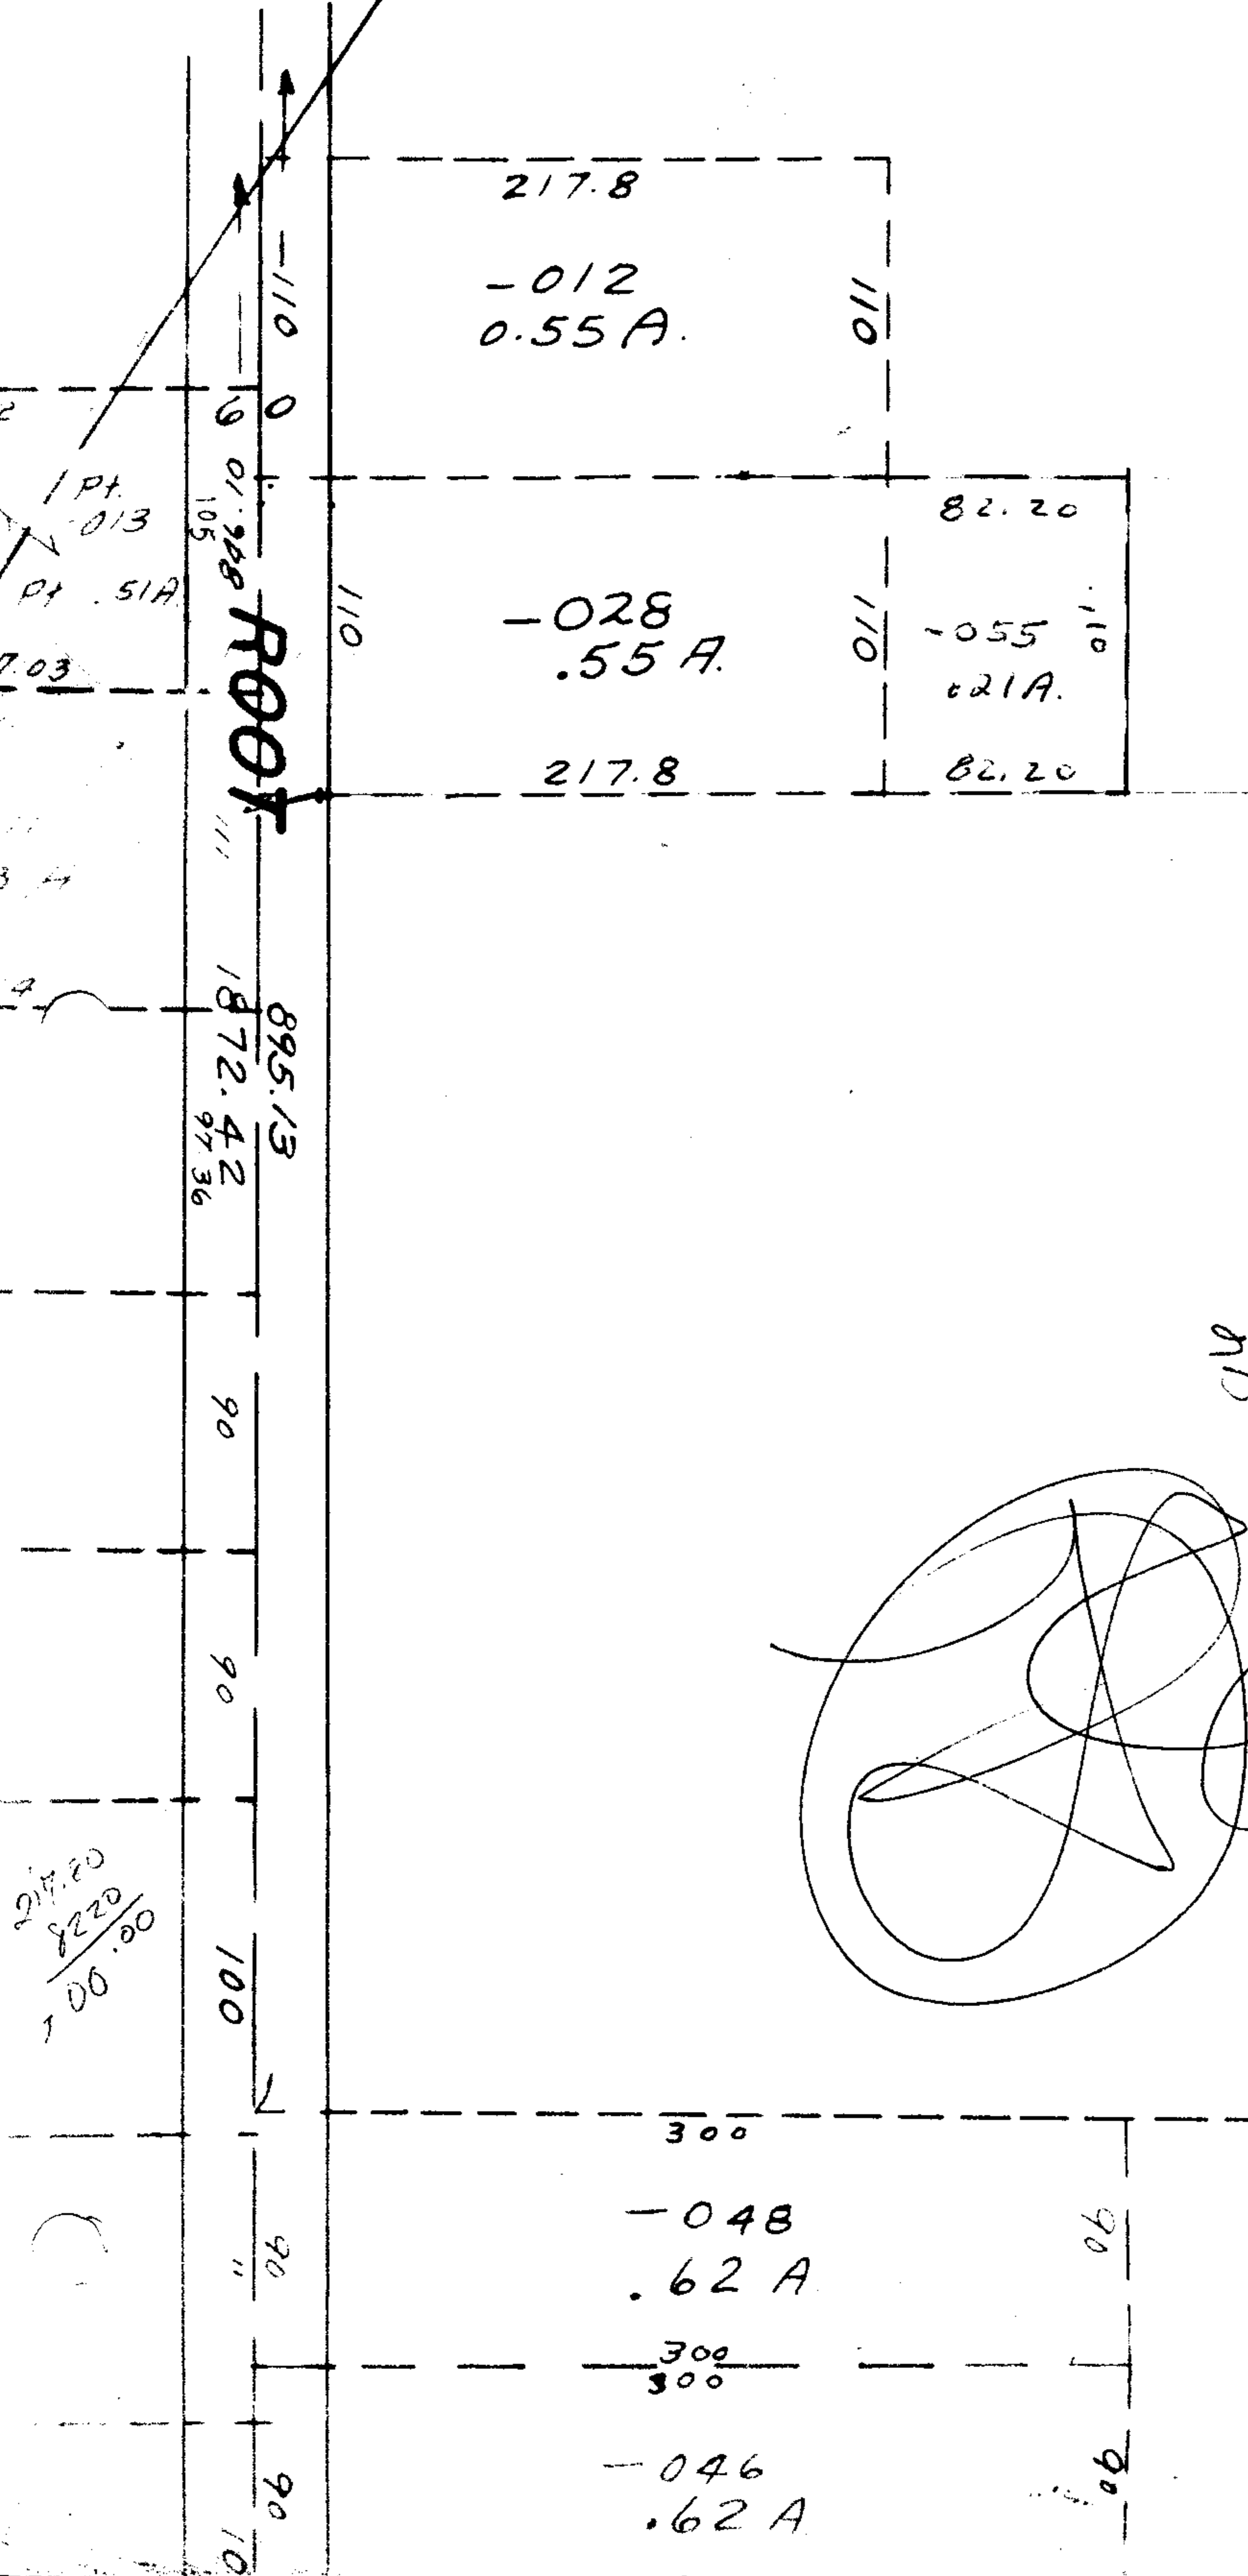

-056
~~2043~~
57.17 A.
56.96 A.

Change Acres
& No. on Page
7-00-011-A

6061

APPROVED
LORAIN CO.
MAP DEPT.
 DATE 6-7-3-72
 7-00-011-A4C
 BY *[Signature]*

[Handwritten scribble]

~~2043~~ 57.17
.21
56.96