


10684

-008  
76.77 A.

6063

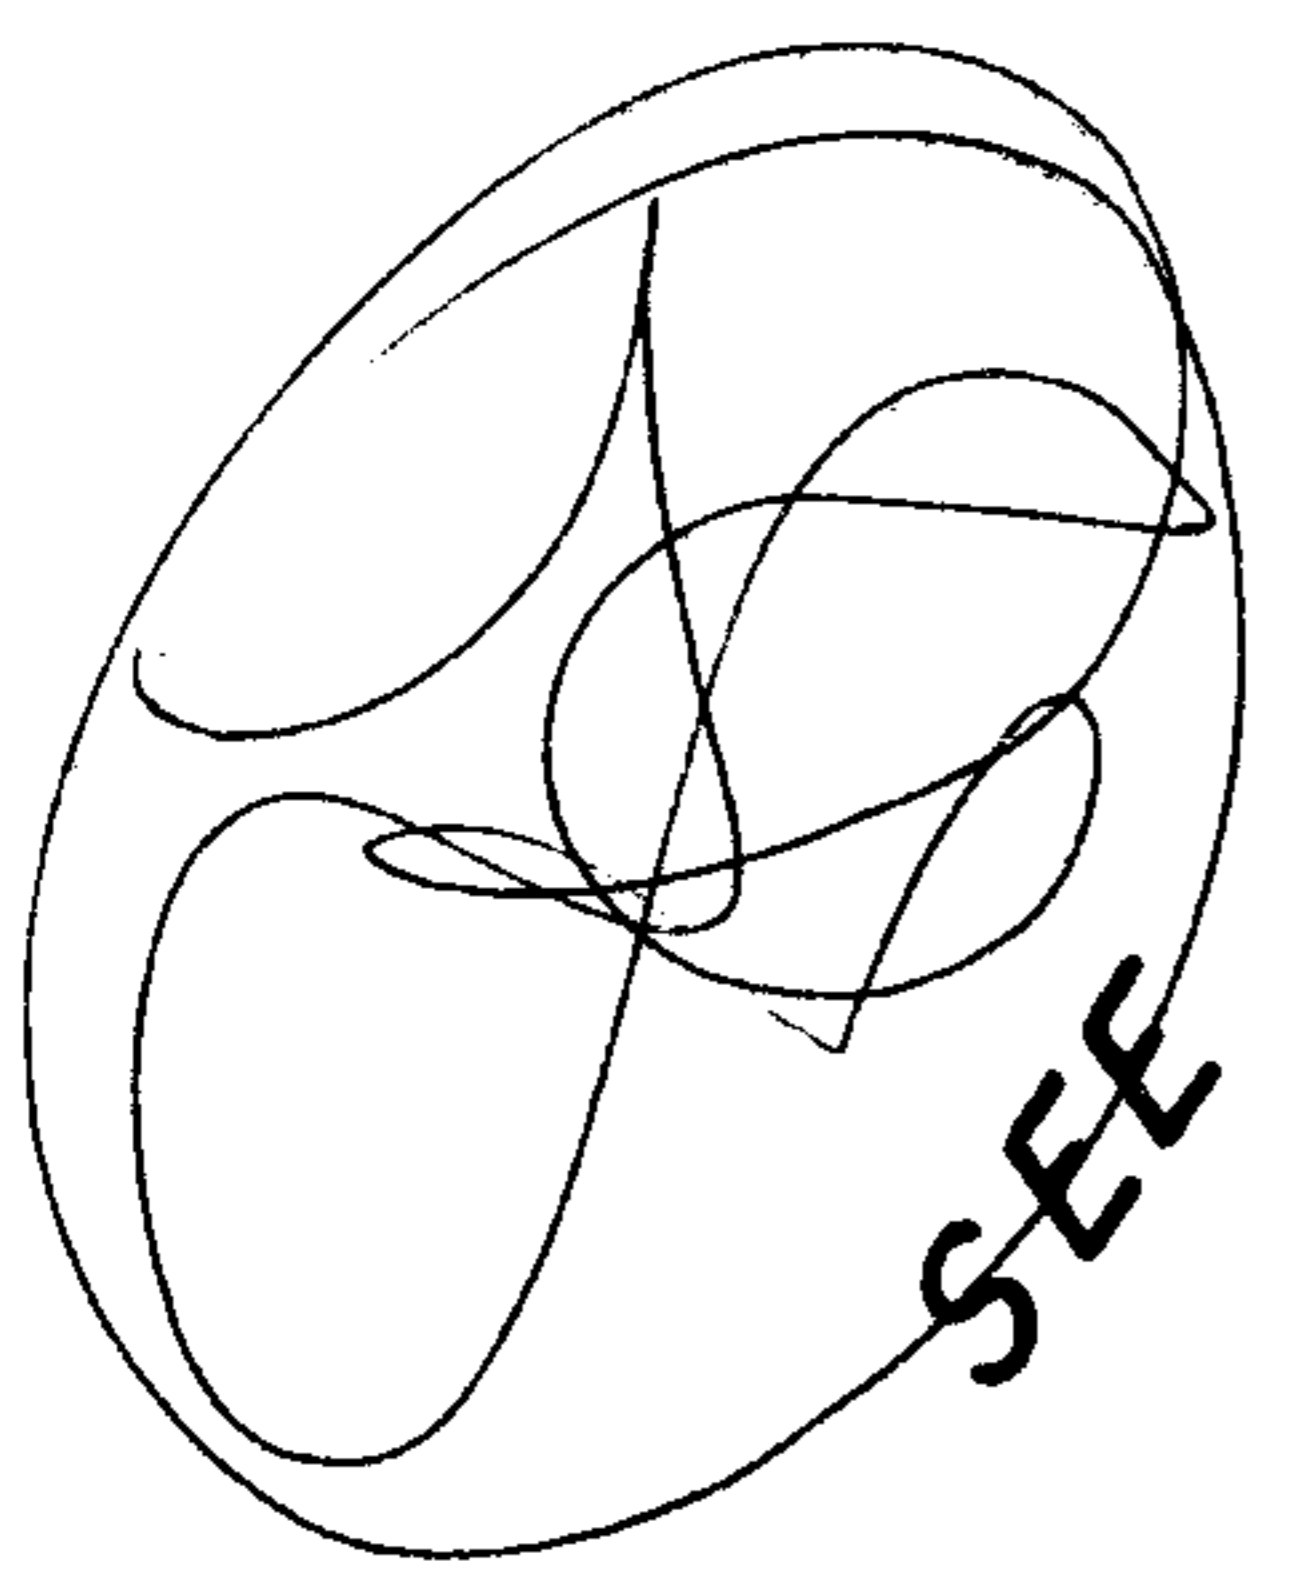

SEE 8-00-093-A

93  
6063

APPROVED  
LORAIN CO.  
MAP DEPT.  
DATE 7-3-72  
8-B  
BY *Folber*

7.00  
6.22  
-78

301.62

664.62

1168.92  
-004  
7.39 A.

1087.12

-006  
18.16 A.

507  
309.90  
197.10

1818.96  
1844

314.82

650  
-005  
4.70 A.

650  
521

562-023  
6.32 A.  
-007  
9.00 A  
81.60  
52.24  
308.90

111.76  
197.10  
47.68  
024

450.40  
644  
RD  
114  
666  
478.50

113

644  
450.40  
193.60

314.82

475.2

-019  
3.50 A.

285.78  
308.55

493.07  
436.92

-020  
10.61 A.

285.78

867.24

Pt. -002  
Pt. 21.89 A.

-003  
0.67 A.

-005  
12.82 A.

816  
817.08

-004  
0.22 A.

1634.16

1334

655.50  
656.70

270.50