

6065 RD.

(60) ST. 1374.73

1278.42

722.04

828.96

400

-001
40.00A.

1374.73
2510.64

6065

APPROVED
LORAIN CO.
MAP DEPT.
DATE 7-5-72
9-H
BY *[Signature]*

8-8-86
8-4-80
39.27A.

2033.46


-001
35.50A.

-002
715 A. Dup.

1255.98

58

-012
~~808~~
78.14A.
78.16A.

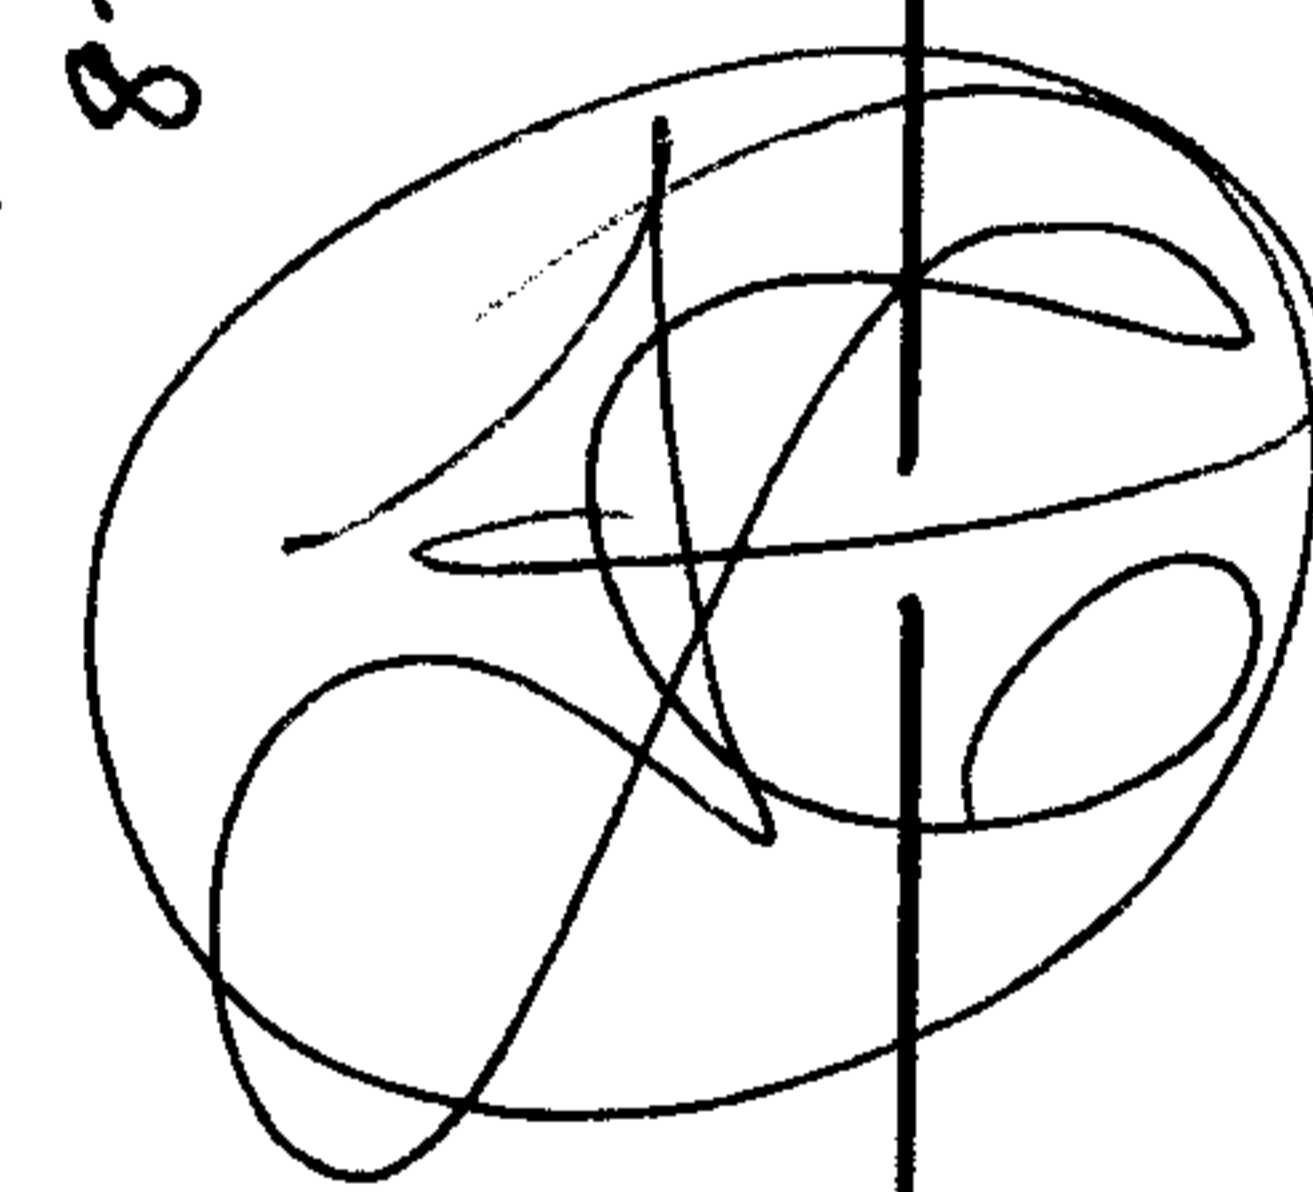

15'
226.22
11448.04
228.27
158.74
183.47
-011
28A.
347.60
371.08
508.20
718.08

BUTTERNUT RIDGE 775.5
-005
2.00A.
727.32

-006
17.62A.

200
1-0047
73A. 10 236
200

-007
4.00A.

-008
20.82A.-

78.44
28
78.16

86.08
13
371.08

(500)
-001
.27A.

-001
10.38 A.

1082.24

16