

34452

6091

OK

6091

APPROVED
LORAIN CO.
MAP DEPT.
DATE 7-12-72
188
BY LW Hall




- 006
29.48 F.

18-000-033-000-016

S.D.
2788-86

- 017
~~- 001~~
74.58 F.
72.58

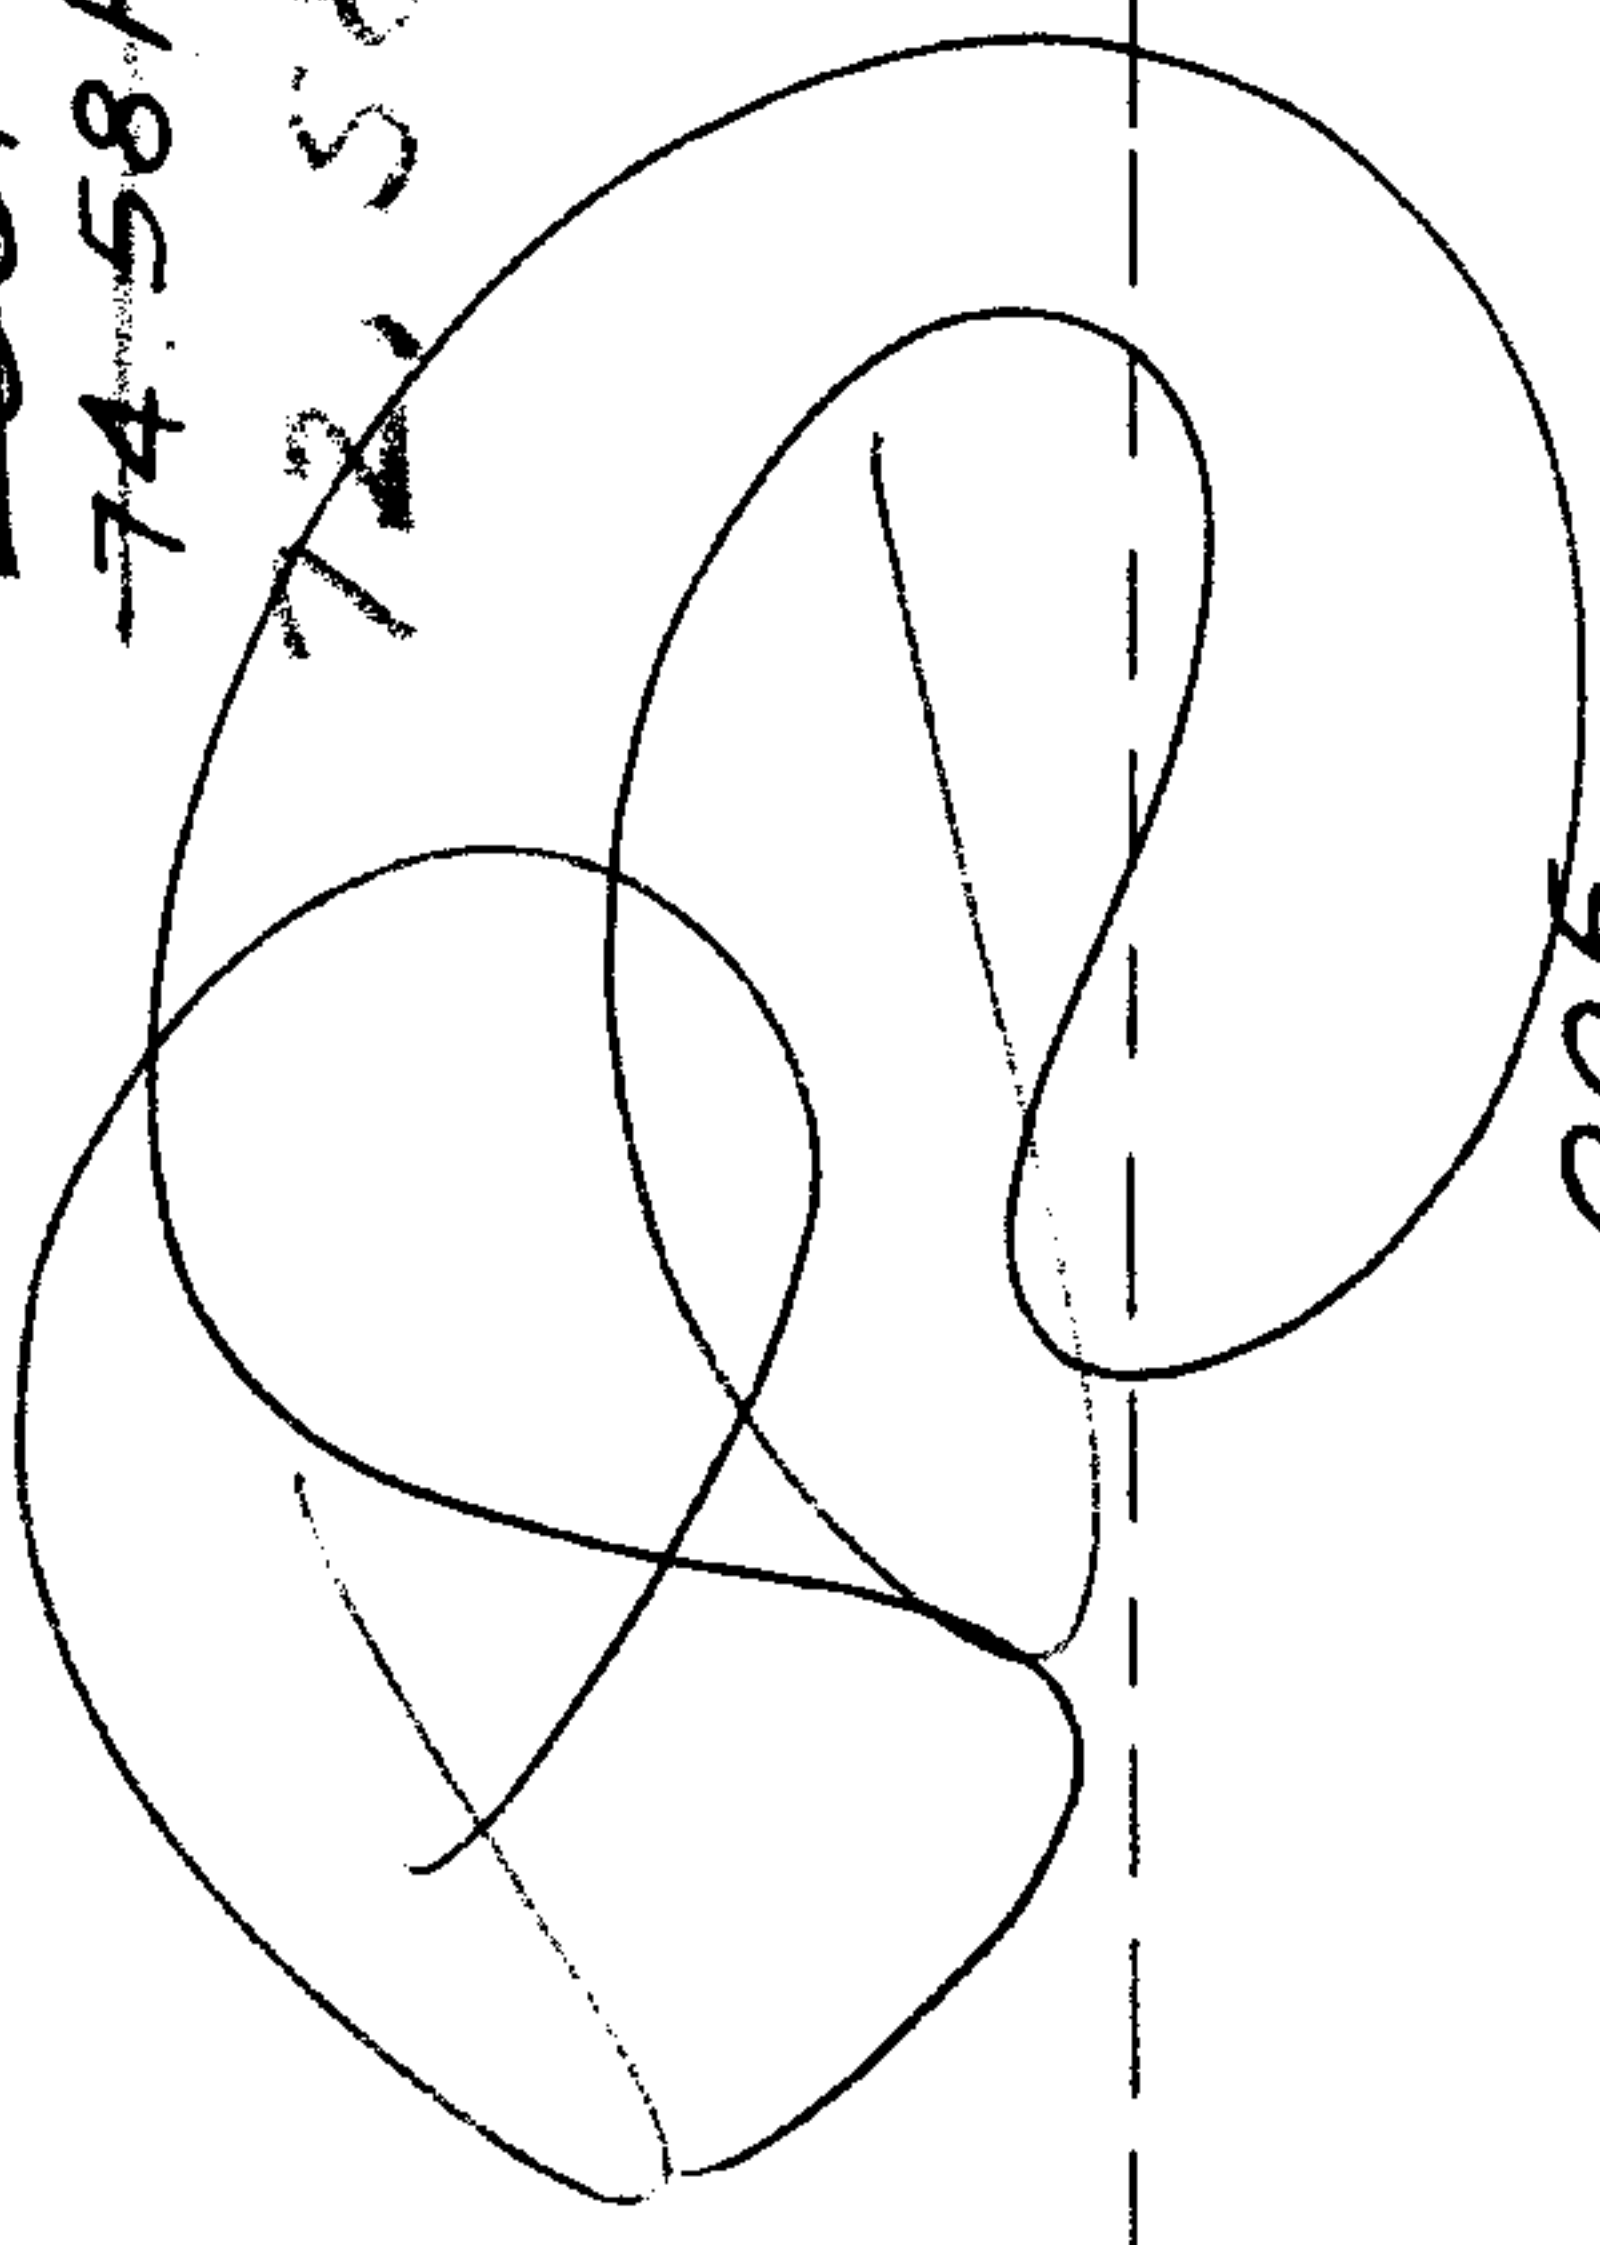

- 005
50.00 F.

- 014
36.66 F.

33

132.96
124.55

216.48 184.8
289.08 301.75
200 Ac
1016
342.65 263.80
330
330
168.30

PITTS 949.74

(60) 925.74
795.96
- 003
7.22 F.
358.38
85.08
800.58

- 004
12.50 F.

436.26 MEDINA - NORMALK

622 296.98

- 013
10.00 F.

749.69

- 009
15.00 F.

784.17
100

502

549.58 2677.92

18

PT 18-00-034-50
PT 13.69 F.