

6094

153.57
80
724
1141.80
-014
2.03A

RD.

RD.

-004
5.00A

700.5

-007
9.40A

-003
8.00A

403.85

325.50

396

396

396

748.35

1977.01

980.5

Note Map
Correction

-022

8.48A

750.00

0.00

51.01

-012 .80A

795.18

-016 2.13A

778.12

-014 2.19A

768.34

767.24

-011

6.36A

762.59

-010

6.36A

757.30

-009


6.36A

751.85

GORE ORPHANAGE

47

-004
45.00A

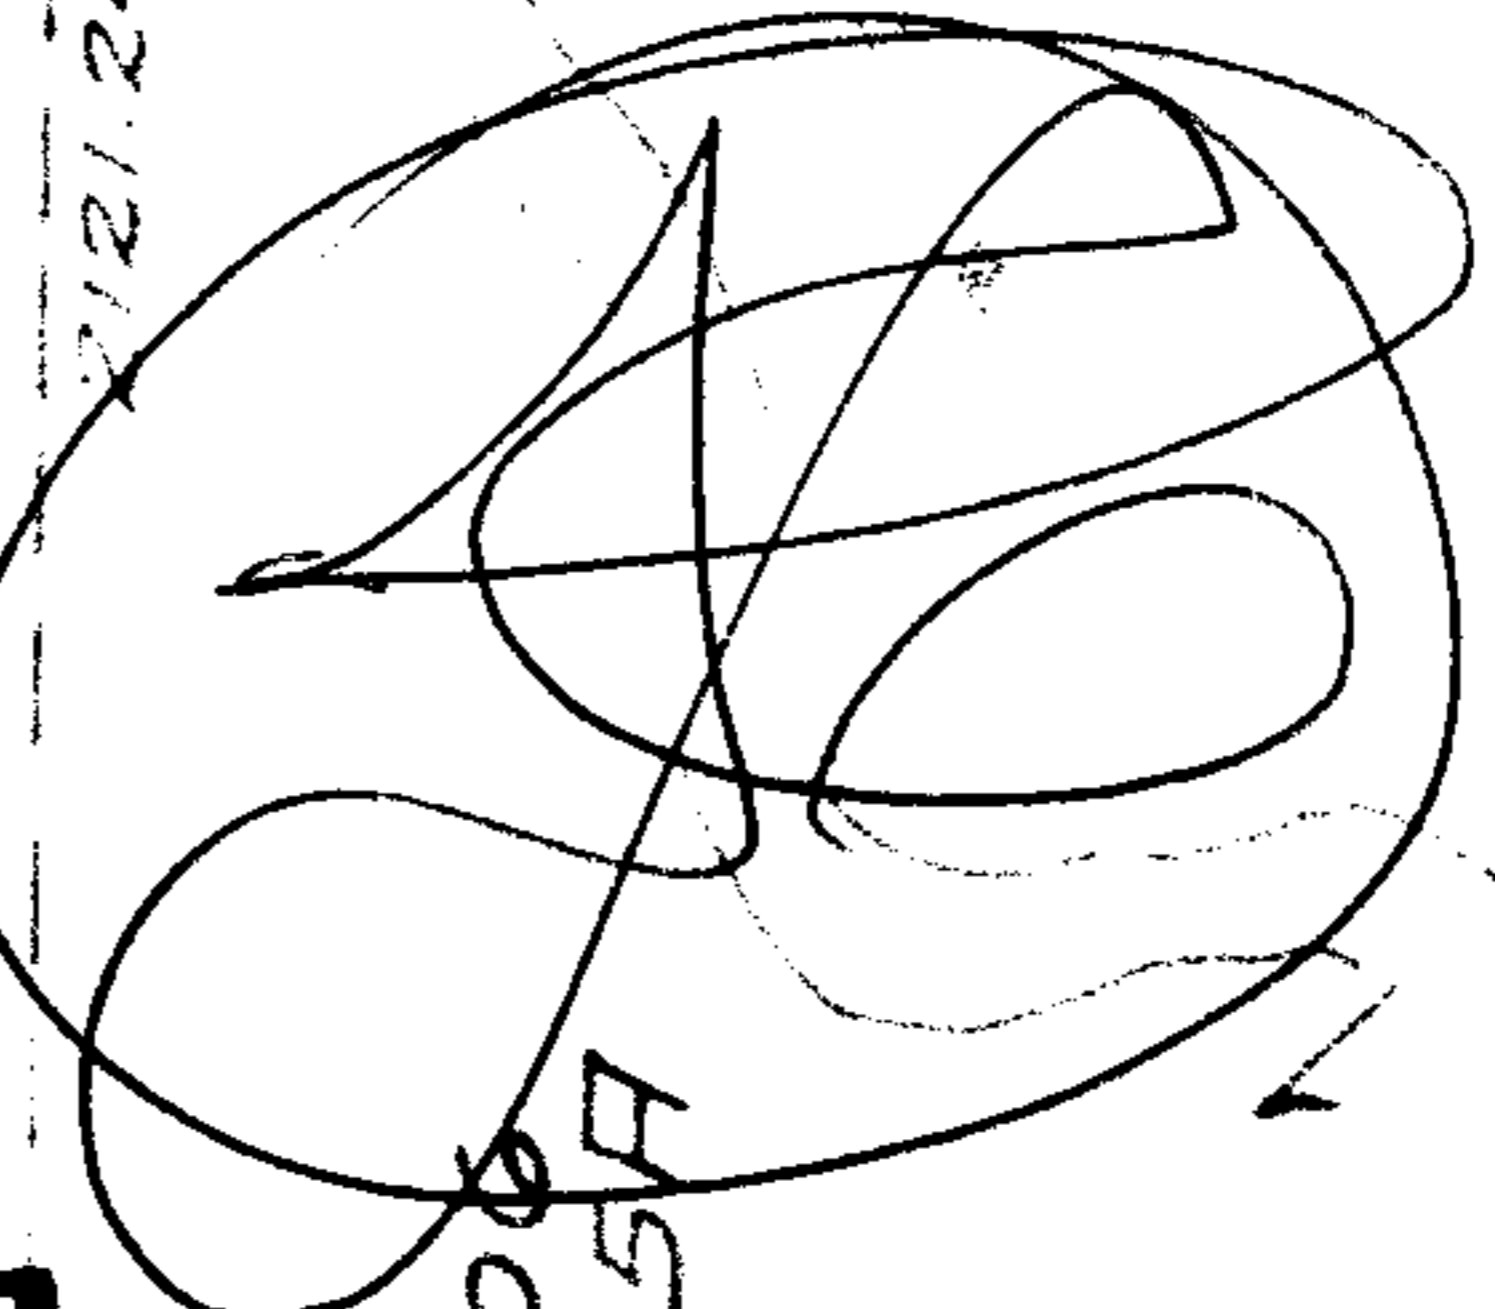

-008
33.15A

PT-005
PT.

APPROVED
LORAIN CO.
DEPT.
DATE 7/12/12
BY [Signature]

1054-114
849-186

S 17, 18, 31 THRU 34, 47, 48
GORE STRIP PT. LOT 27