

6100
OK




[Handwritten signature]

355

-086
10.51A.

7171.33
7182.90

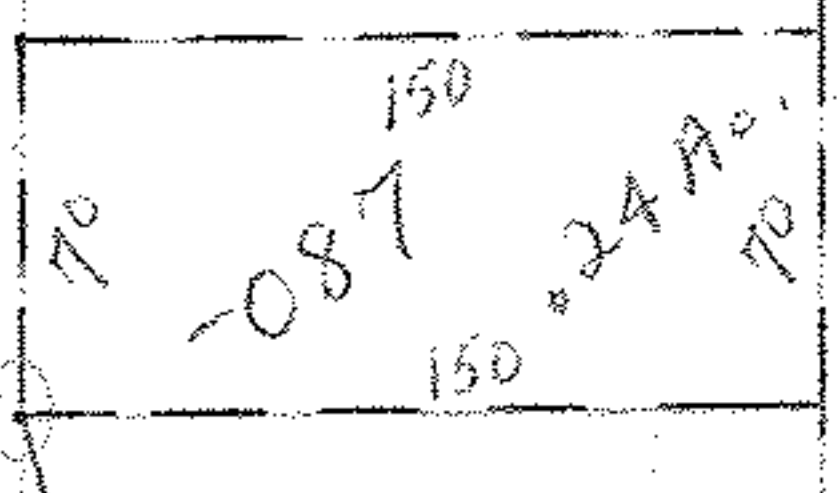

1325.90

SEE 18-00-028-A

6100

APPROVED
LORAIN CO.
MAP DEPT.
DATE 7-14-12
18-00-028-ABC
BY <i>[Signature]</i>

18-80-L
8.8

47.79

150

180

166.66

262.21

307.21

292

797

Change Acres
of # on Next
Pages

pt. -088
pt. ~~27.90A~~
26.51Ac.

509.09