


MASTINGS

6105

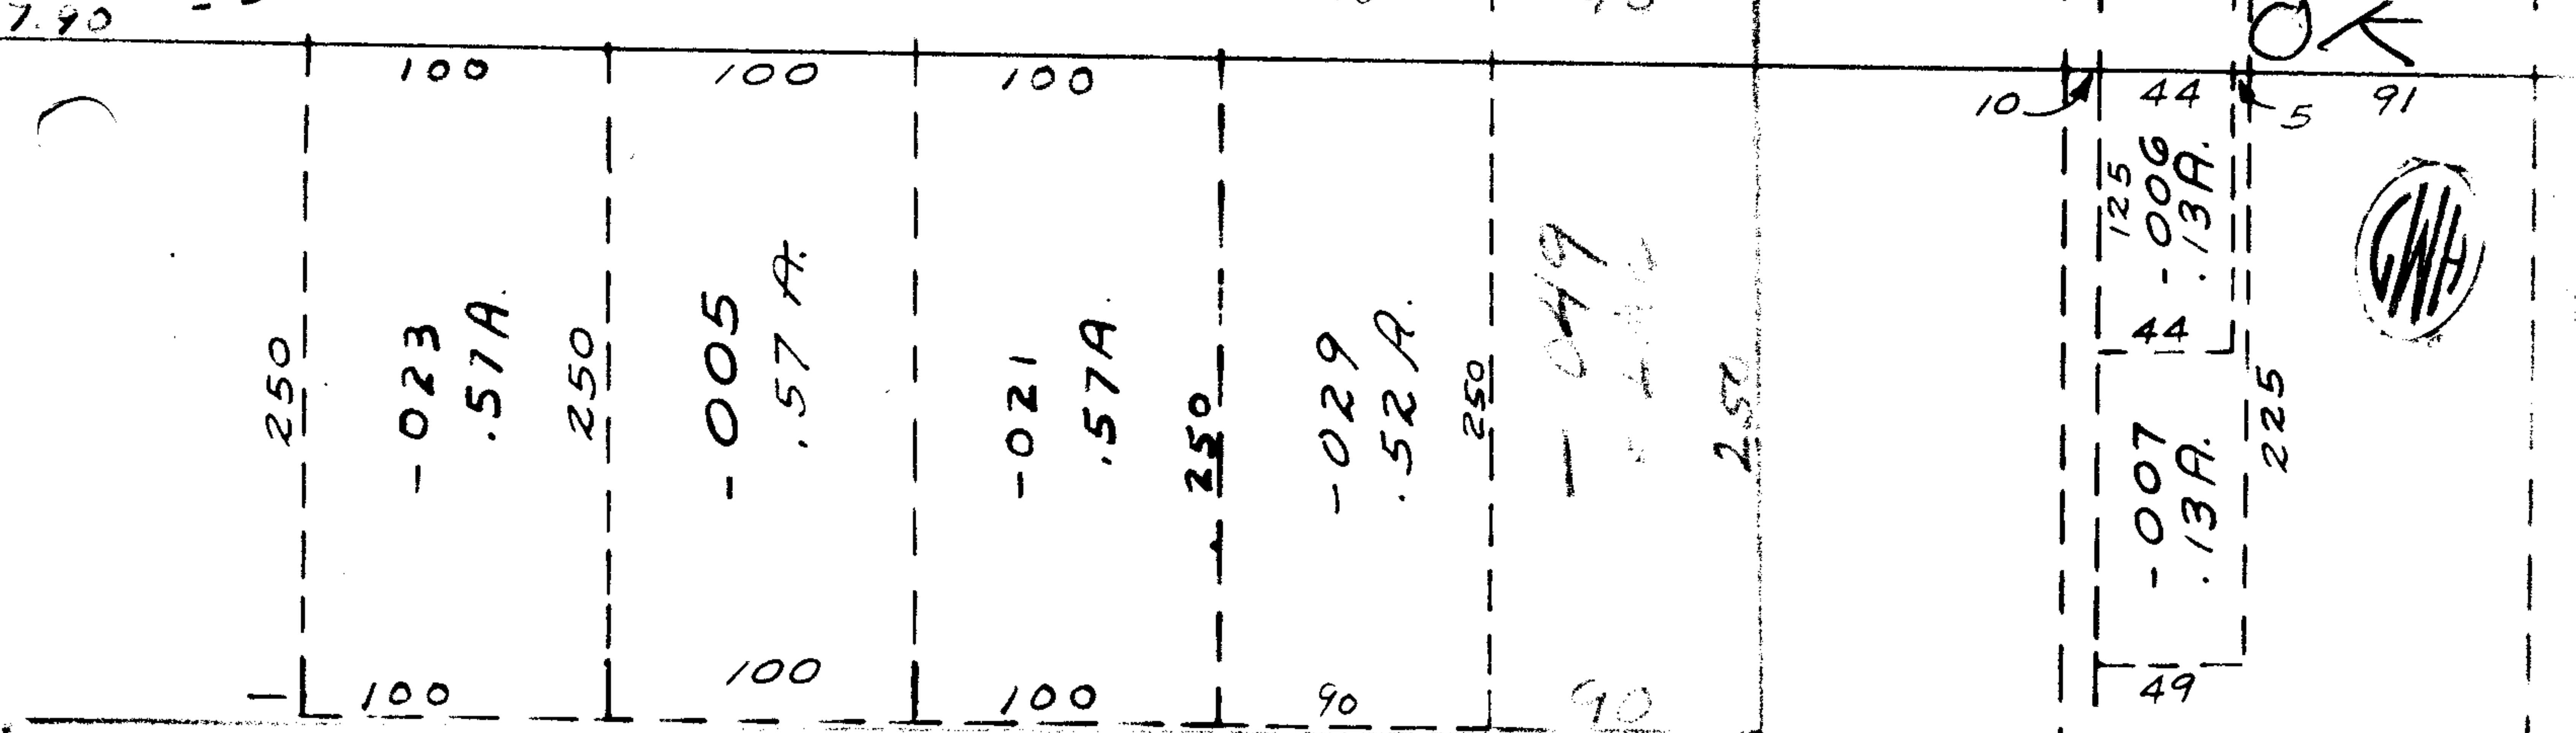

SEE 10-00-020-E

~~050~~
~~043~~
~~5.84A~~
~~5.2A~~
 5.02 A

650.70

6105

APPROVED
LORAIN CO.
MAP DEPT.
DATE 7-14-72
10-00-020-E
BY [Signature]

D.S.
 7-23
 1050

Pt. -040
 Pt. 53.76?

10-00-020-E