


6125
OK

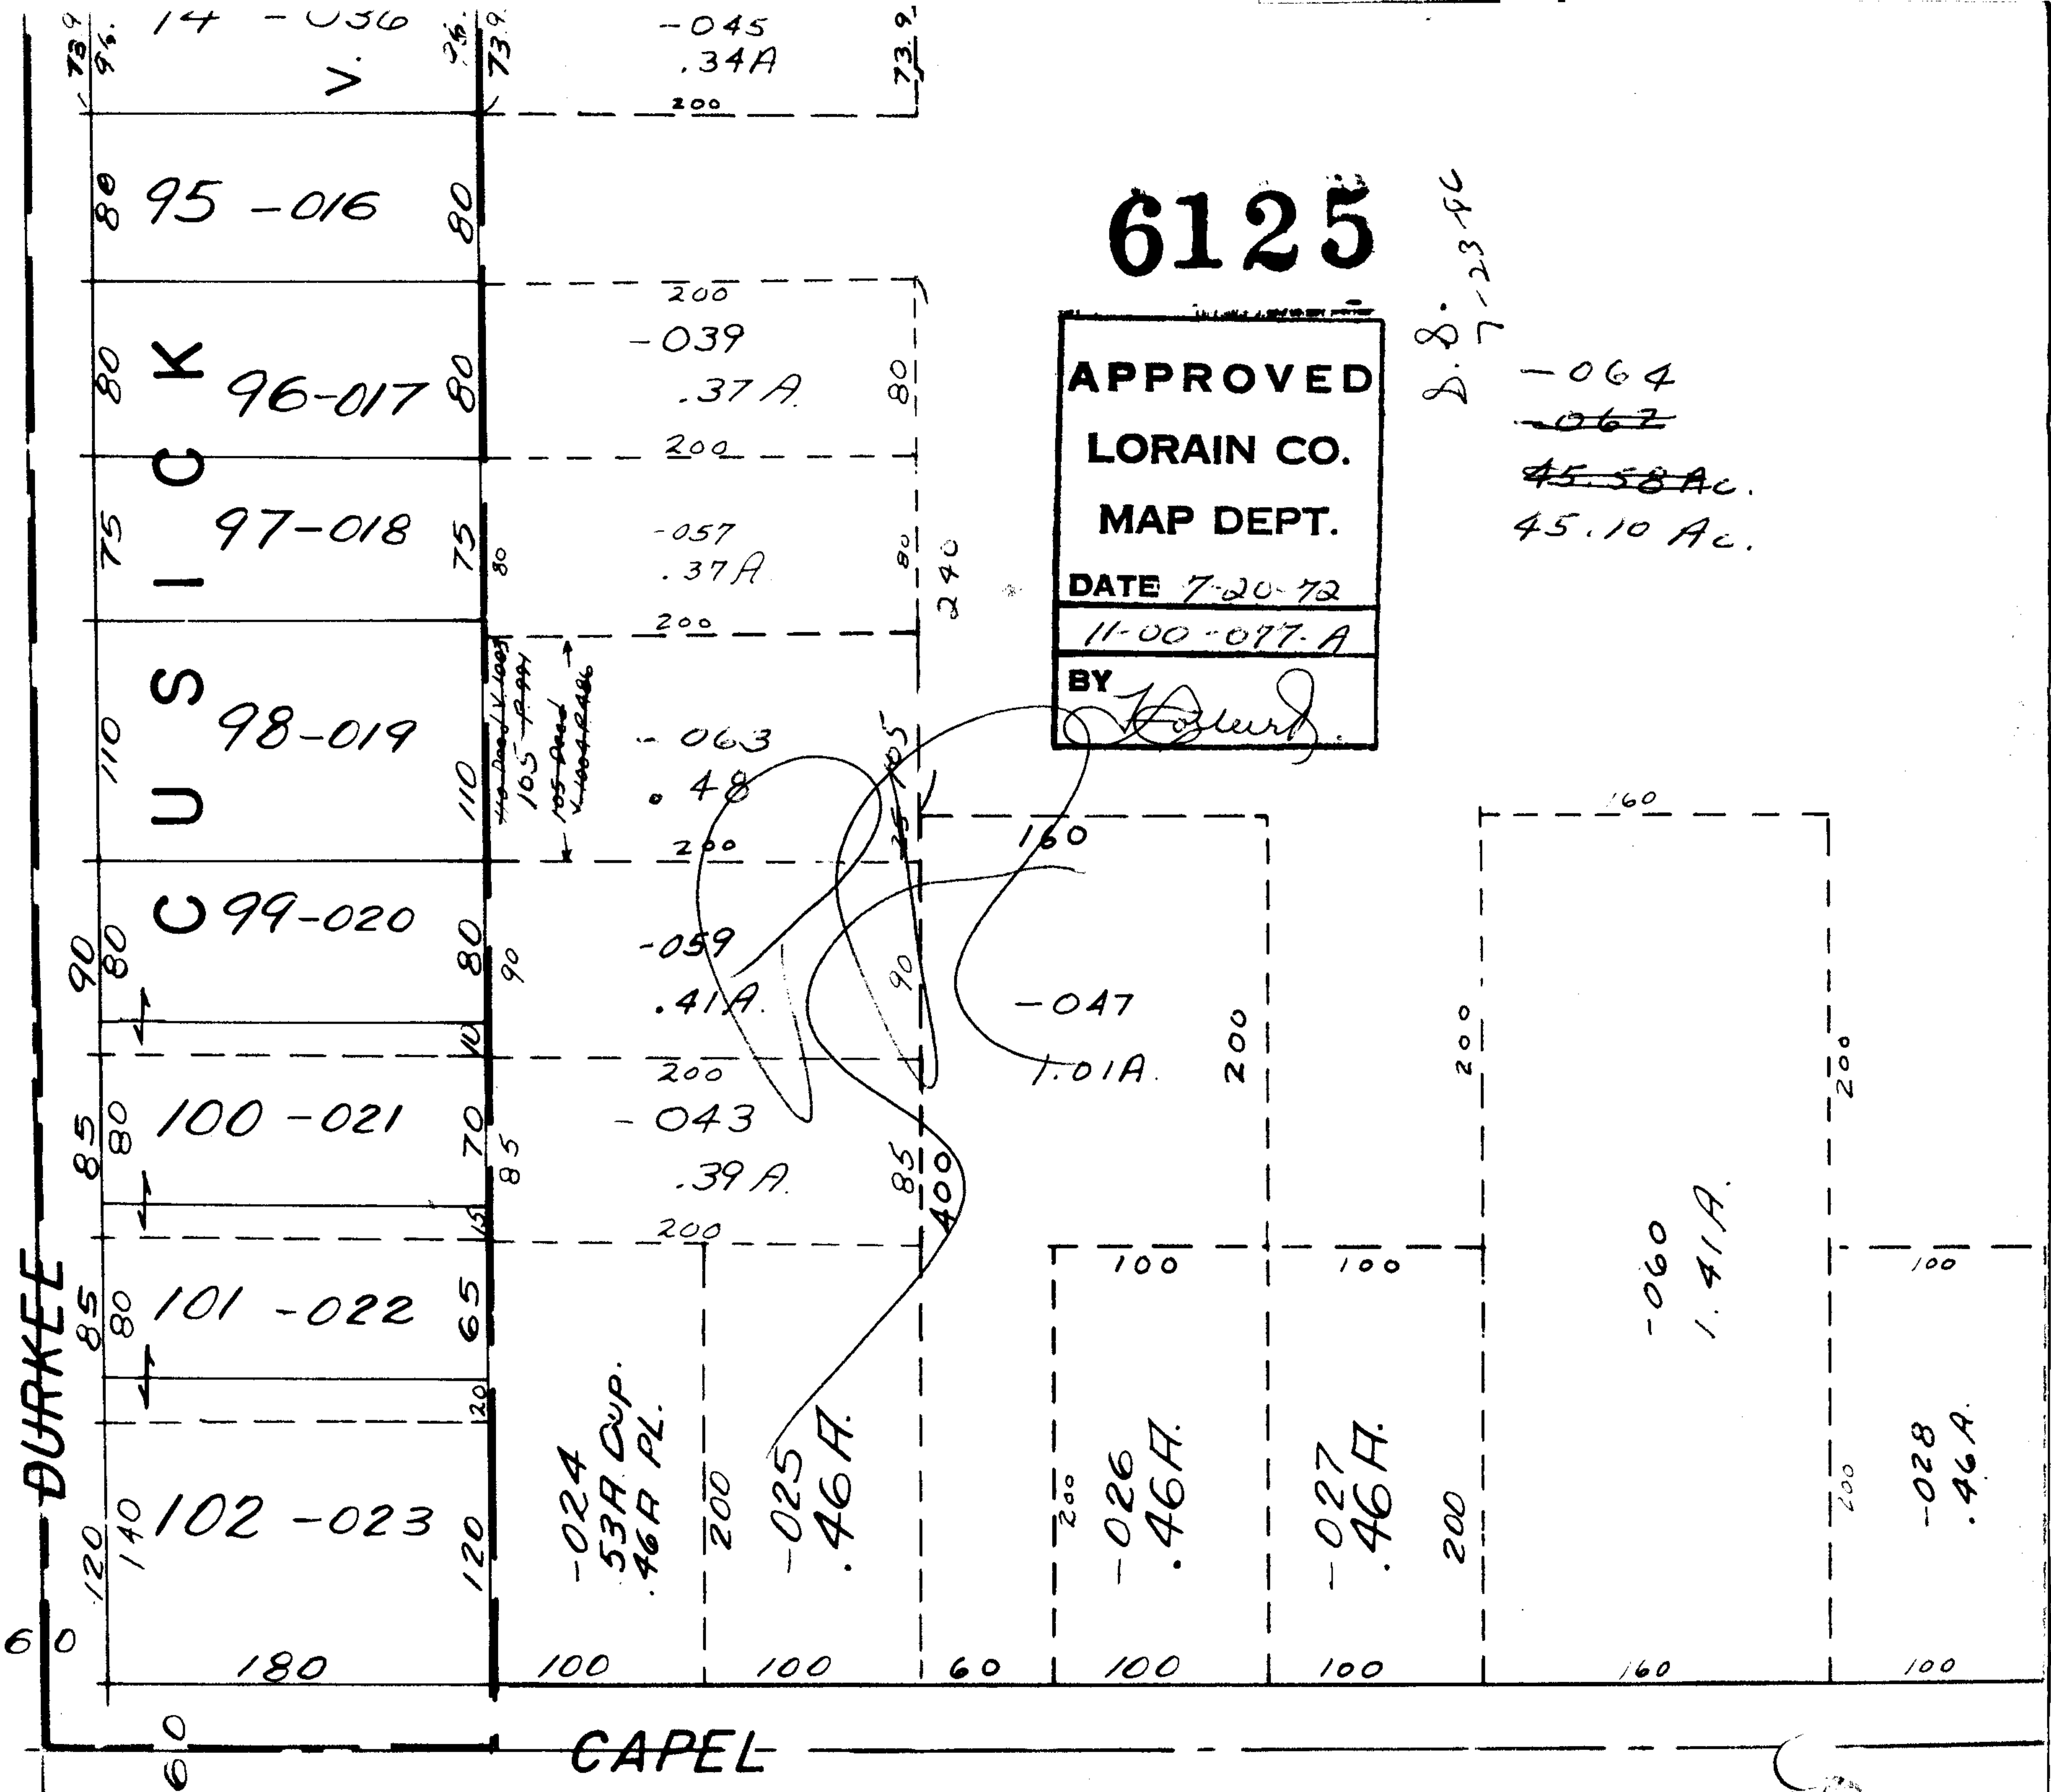

6125

APPROVED
 LORAIN CO.
 MAP DEPT.
 DATE 7-20-72
 11-00-077-A
 BY [Signature]

D.S. 7-23-76

-064
-067
~~45.58 AC.~~
45.10 AC.

-060
1.41A.

-028
.46A.

SEE