

36.33 A.

923.34

6132



OK

904.20

168.96


747.76

6132
APPROVED
LORAIN CO.
MAP DEPT.
DATE 7-21-72
 19A
BY LWH Hall

1830.18

-002
37.83 A.

1830.18

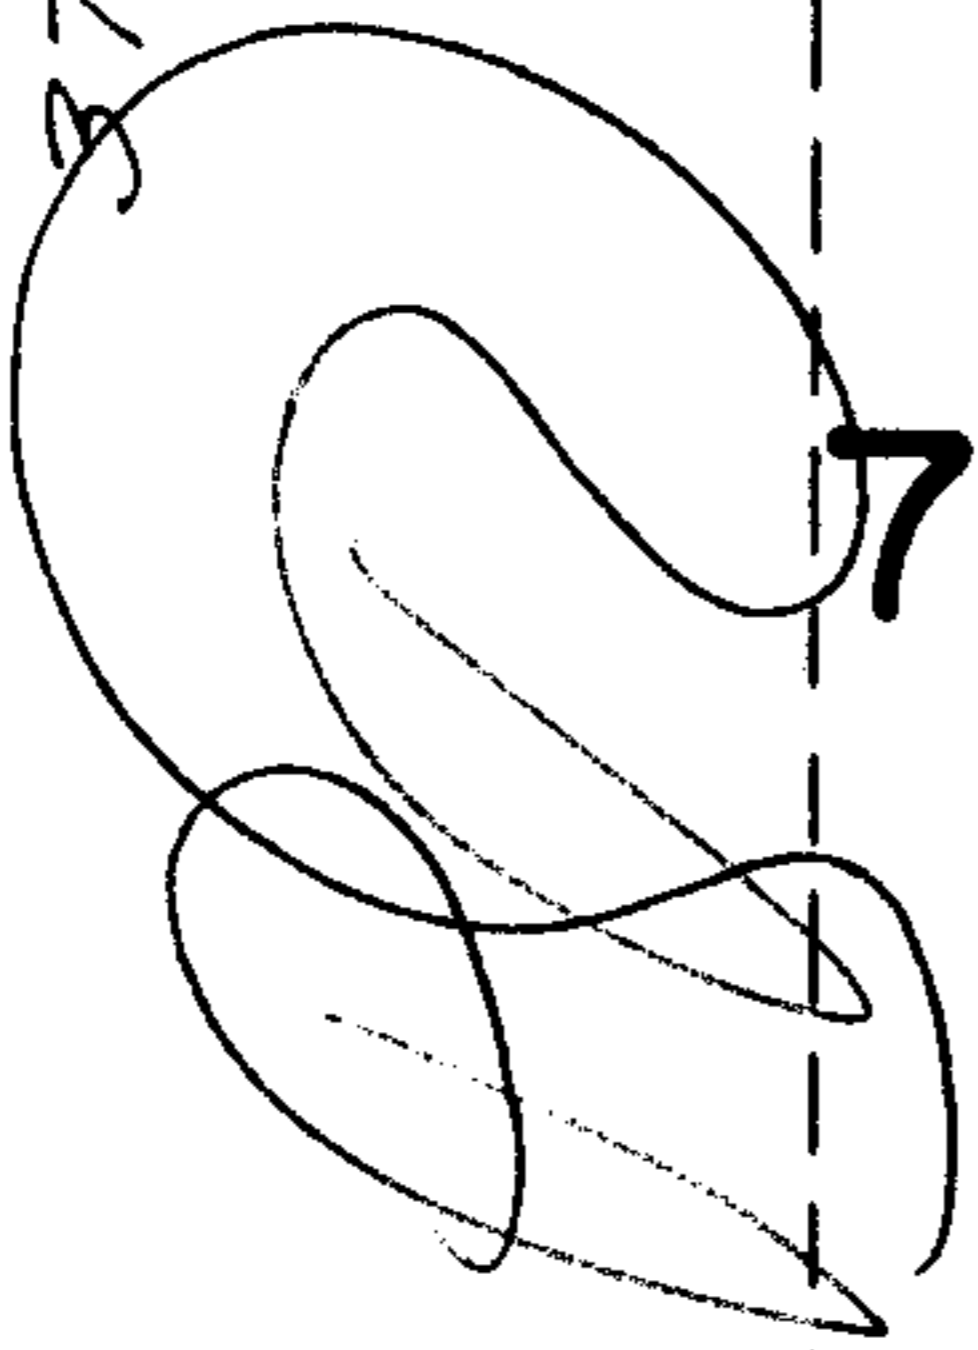

-001
100.00 A.
6

S.S.
8-4-86

900.24

~~-008~~
~~=006~~
~~70.00 A.~~
63.00 A.

WEST 1545.72

(60)

-003
31.33 A.

1545.72

R

A

383.67

614.64

-007
7.00 A.

767.9

247.28

137.54

214.5

132

100 A

61 A

132

005 A

15 A

27.

876.94

428.63

217.50

137.94

200

MEDINA - NORWALK

PENFIELD TWP

SCALE: 1" = 400'

Copyright 1962

19-A