
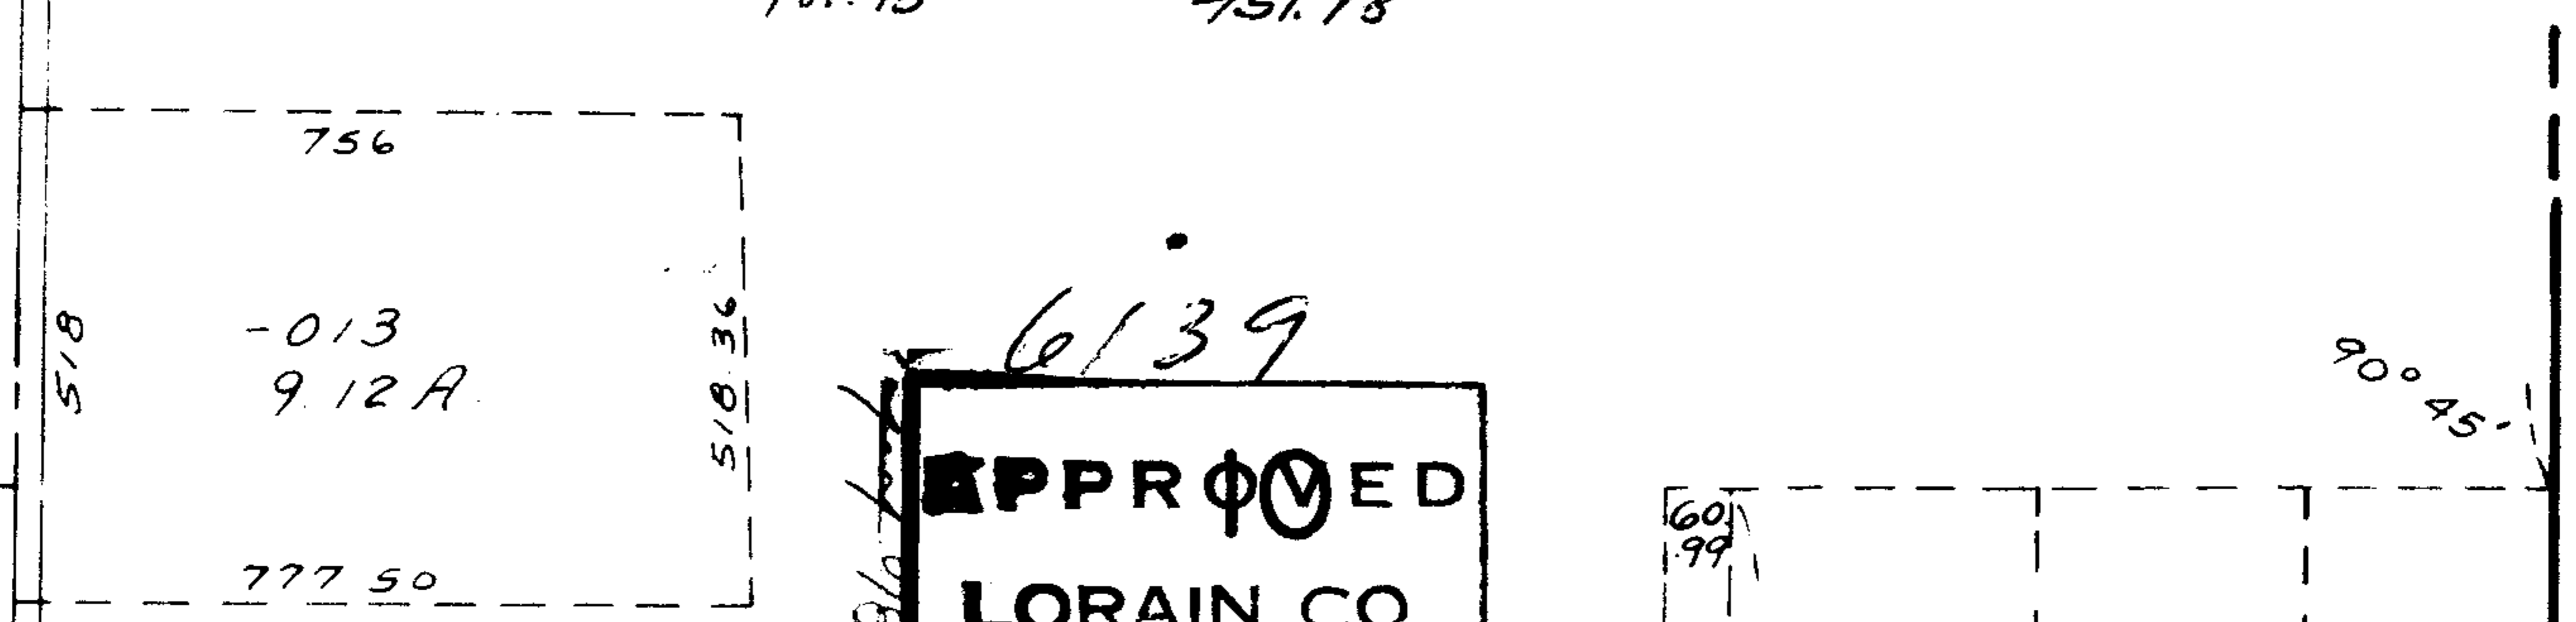


1088.70
CROCKER

RD. 6139

RD.

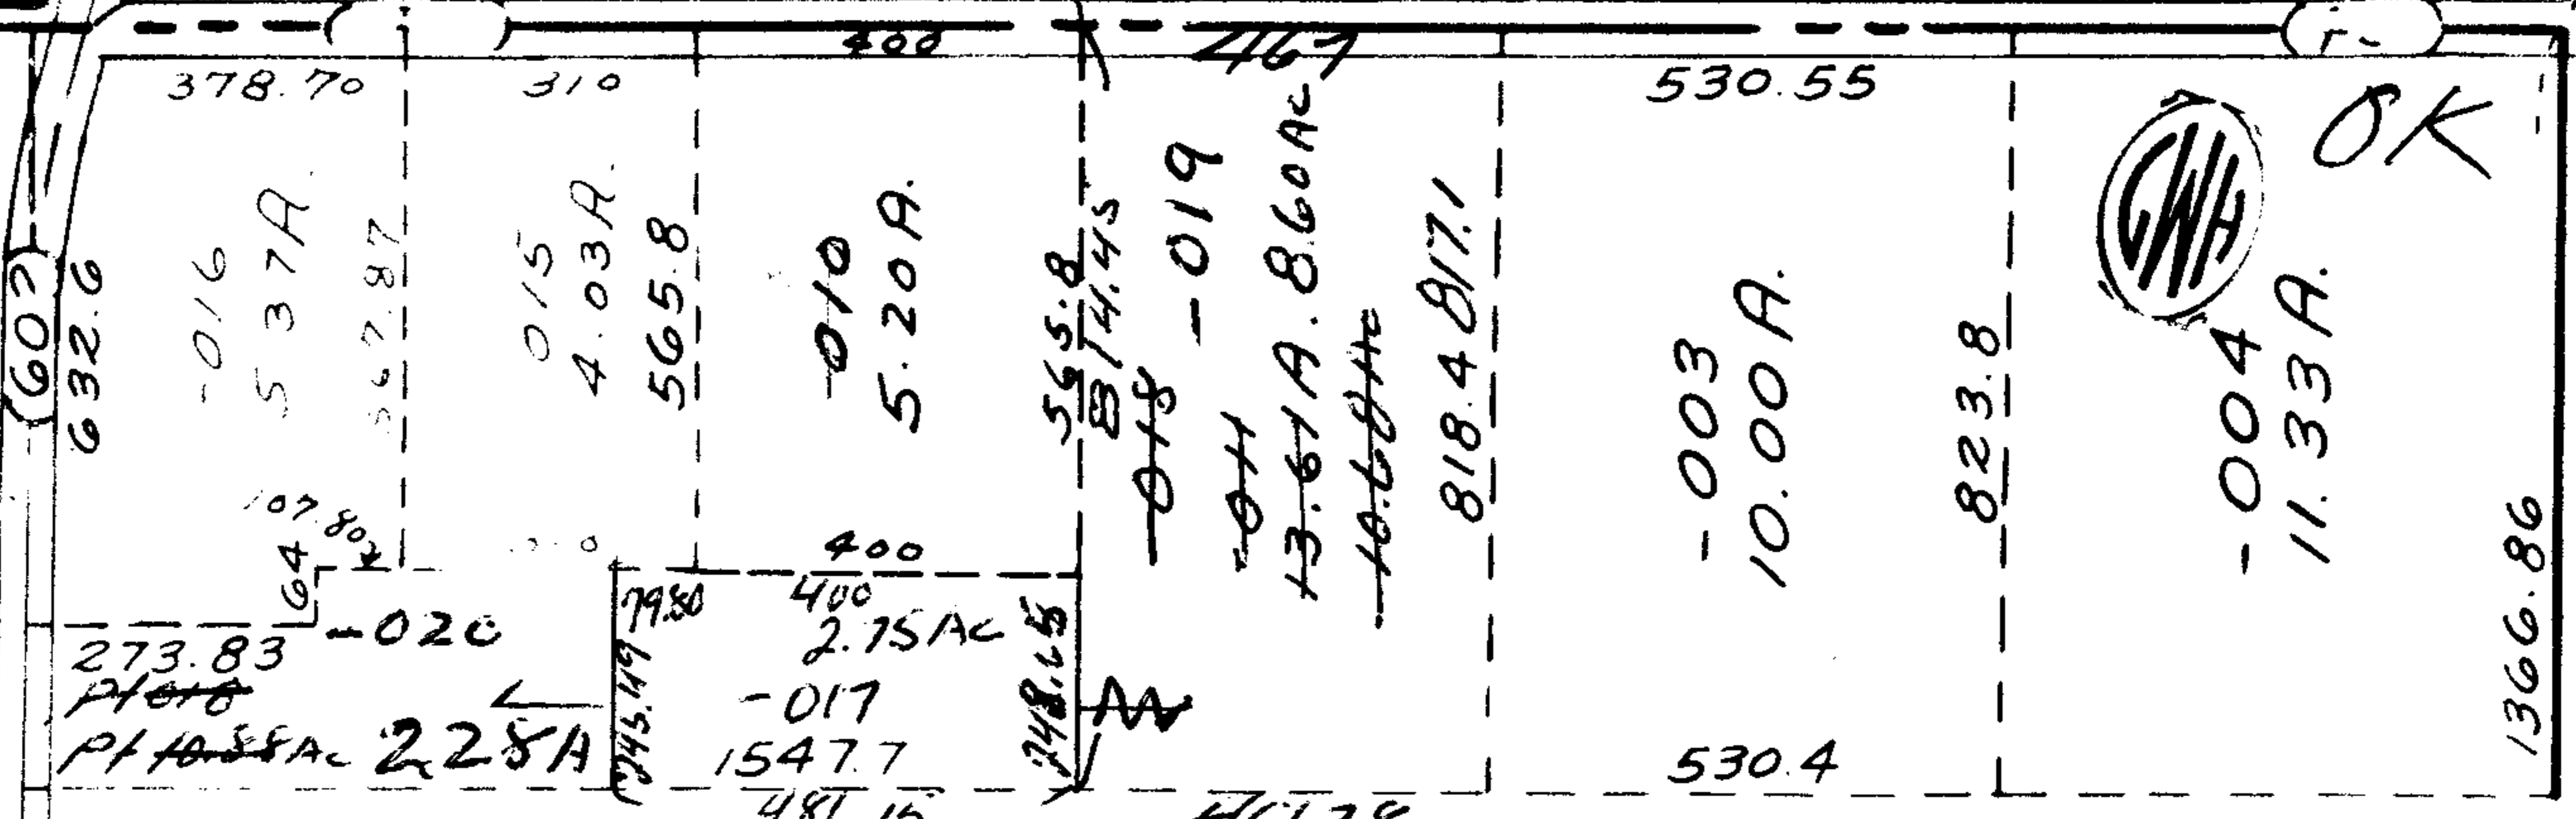

6139

APPROVED



LORAIN CO.

MAY 4 1972

DATE 7-25-72

160

BY L W Hall

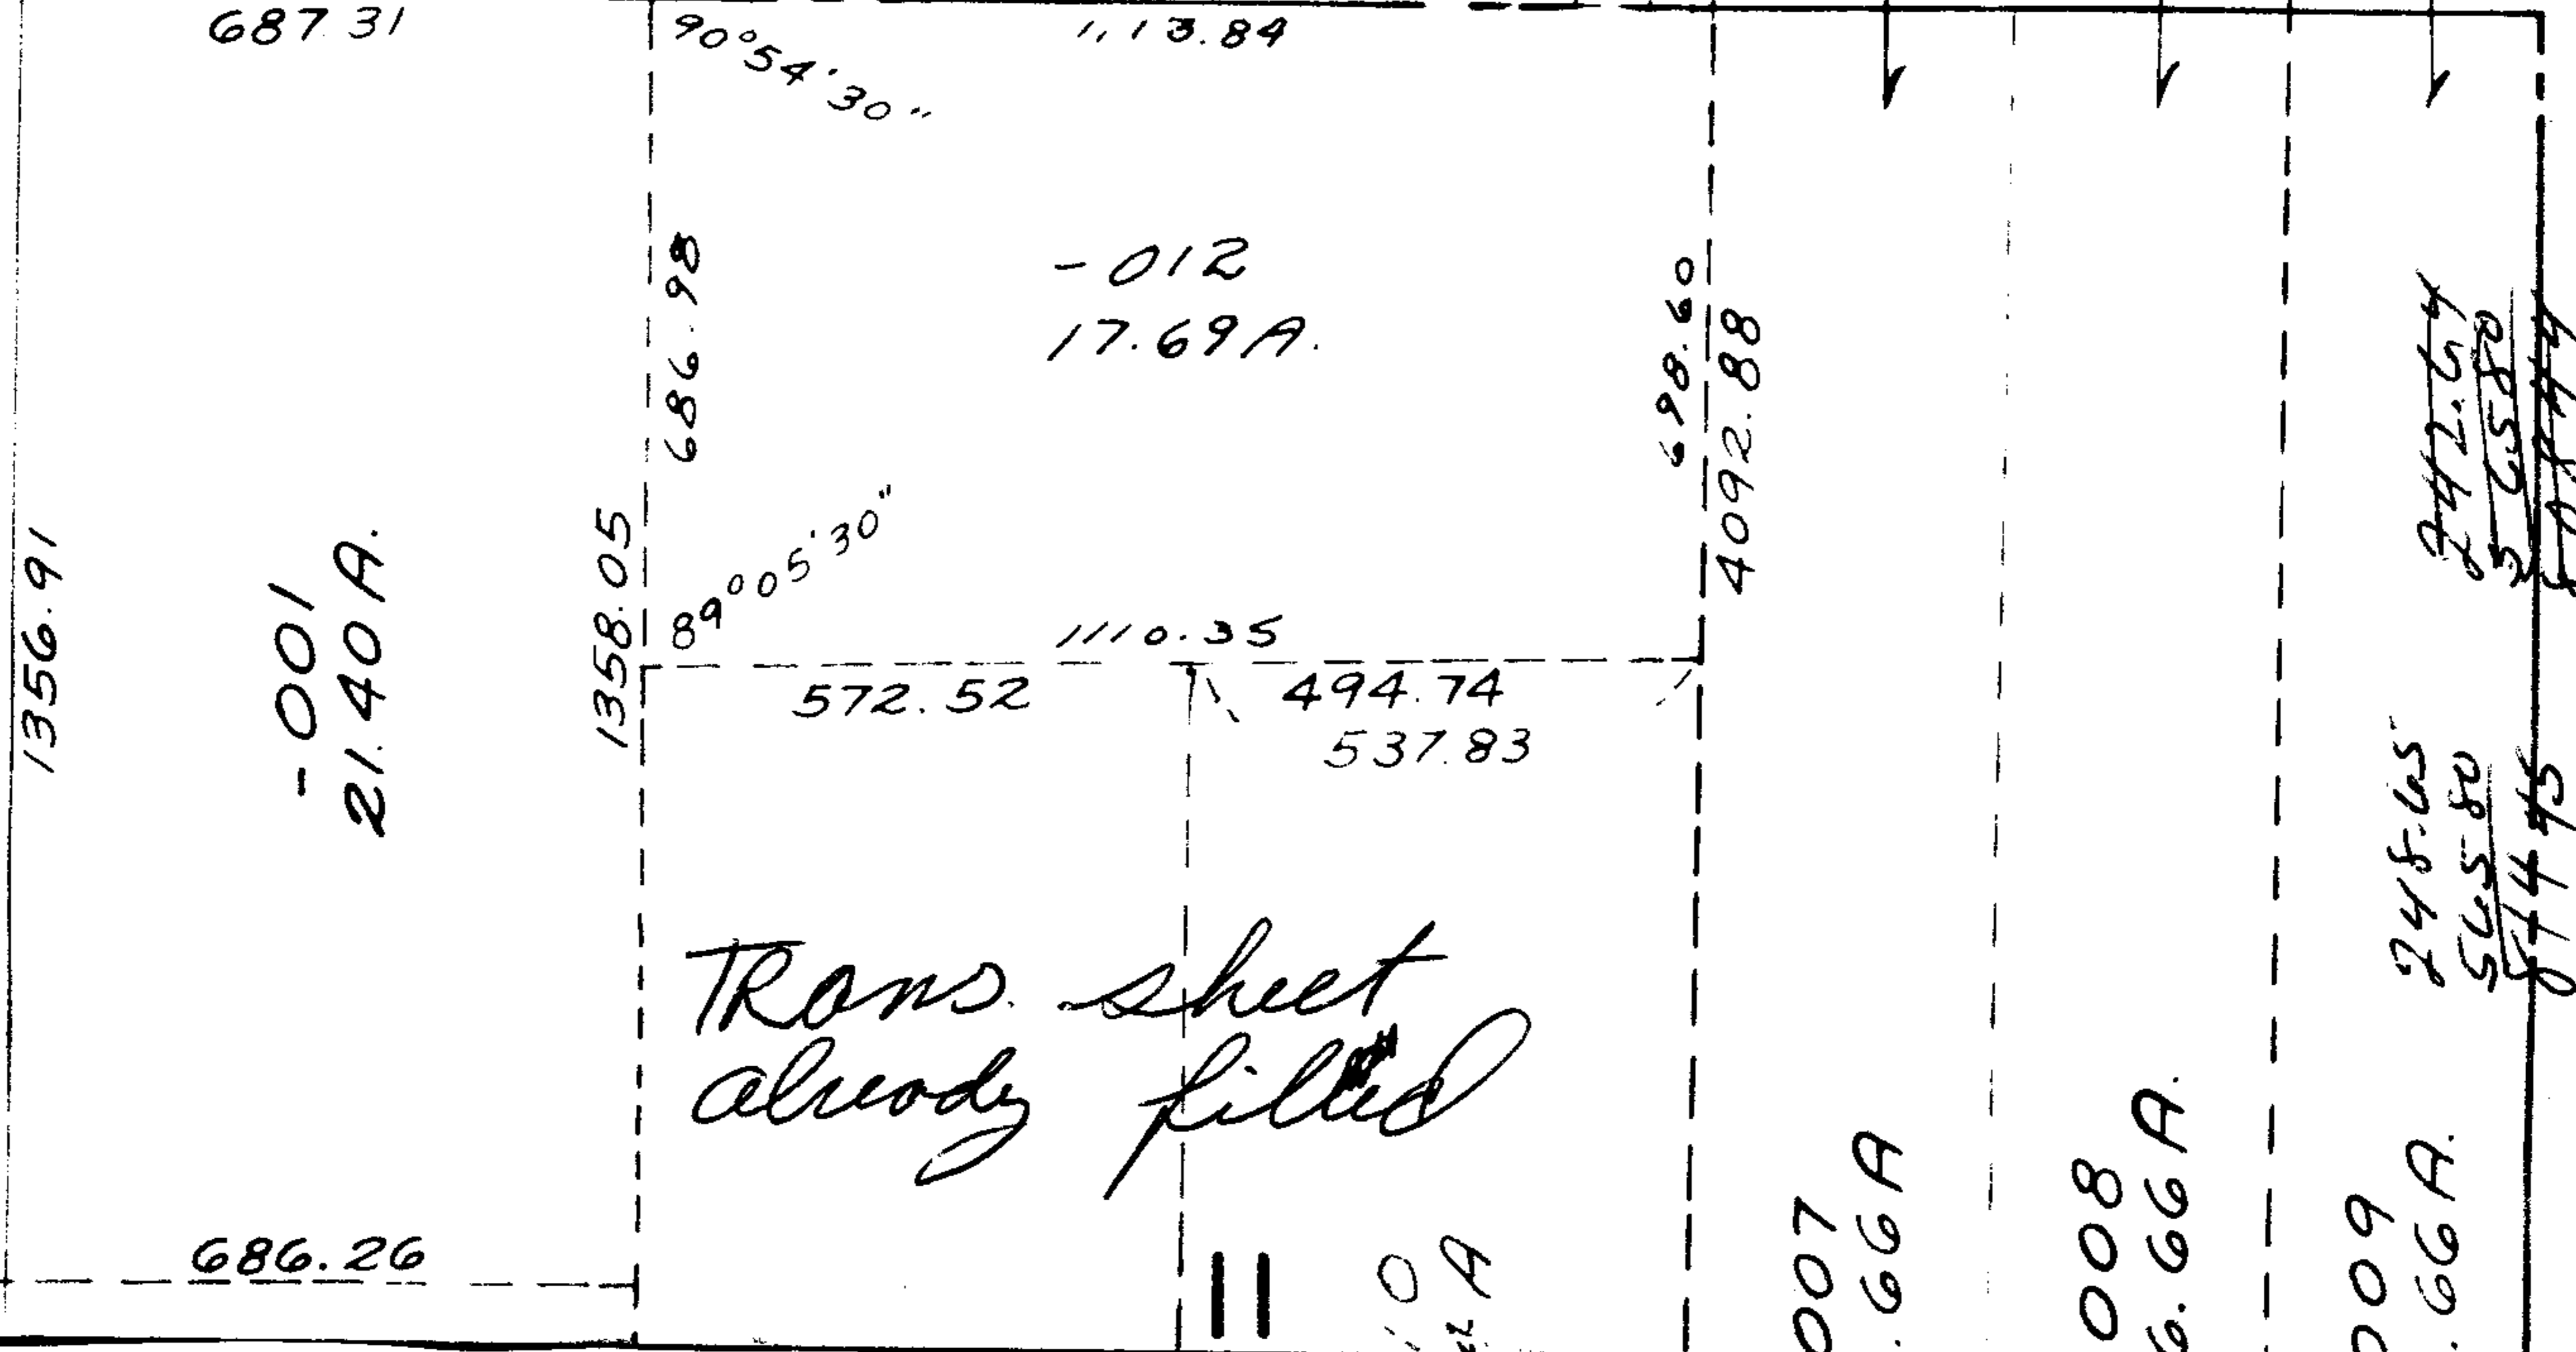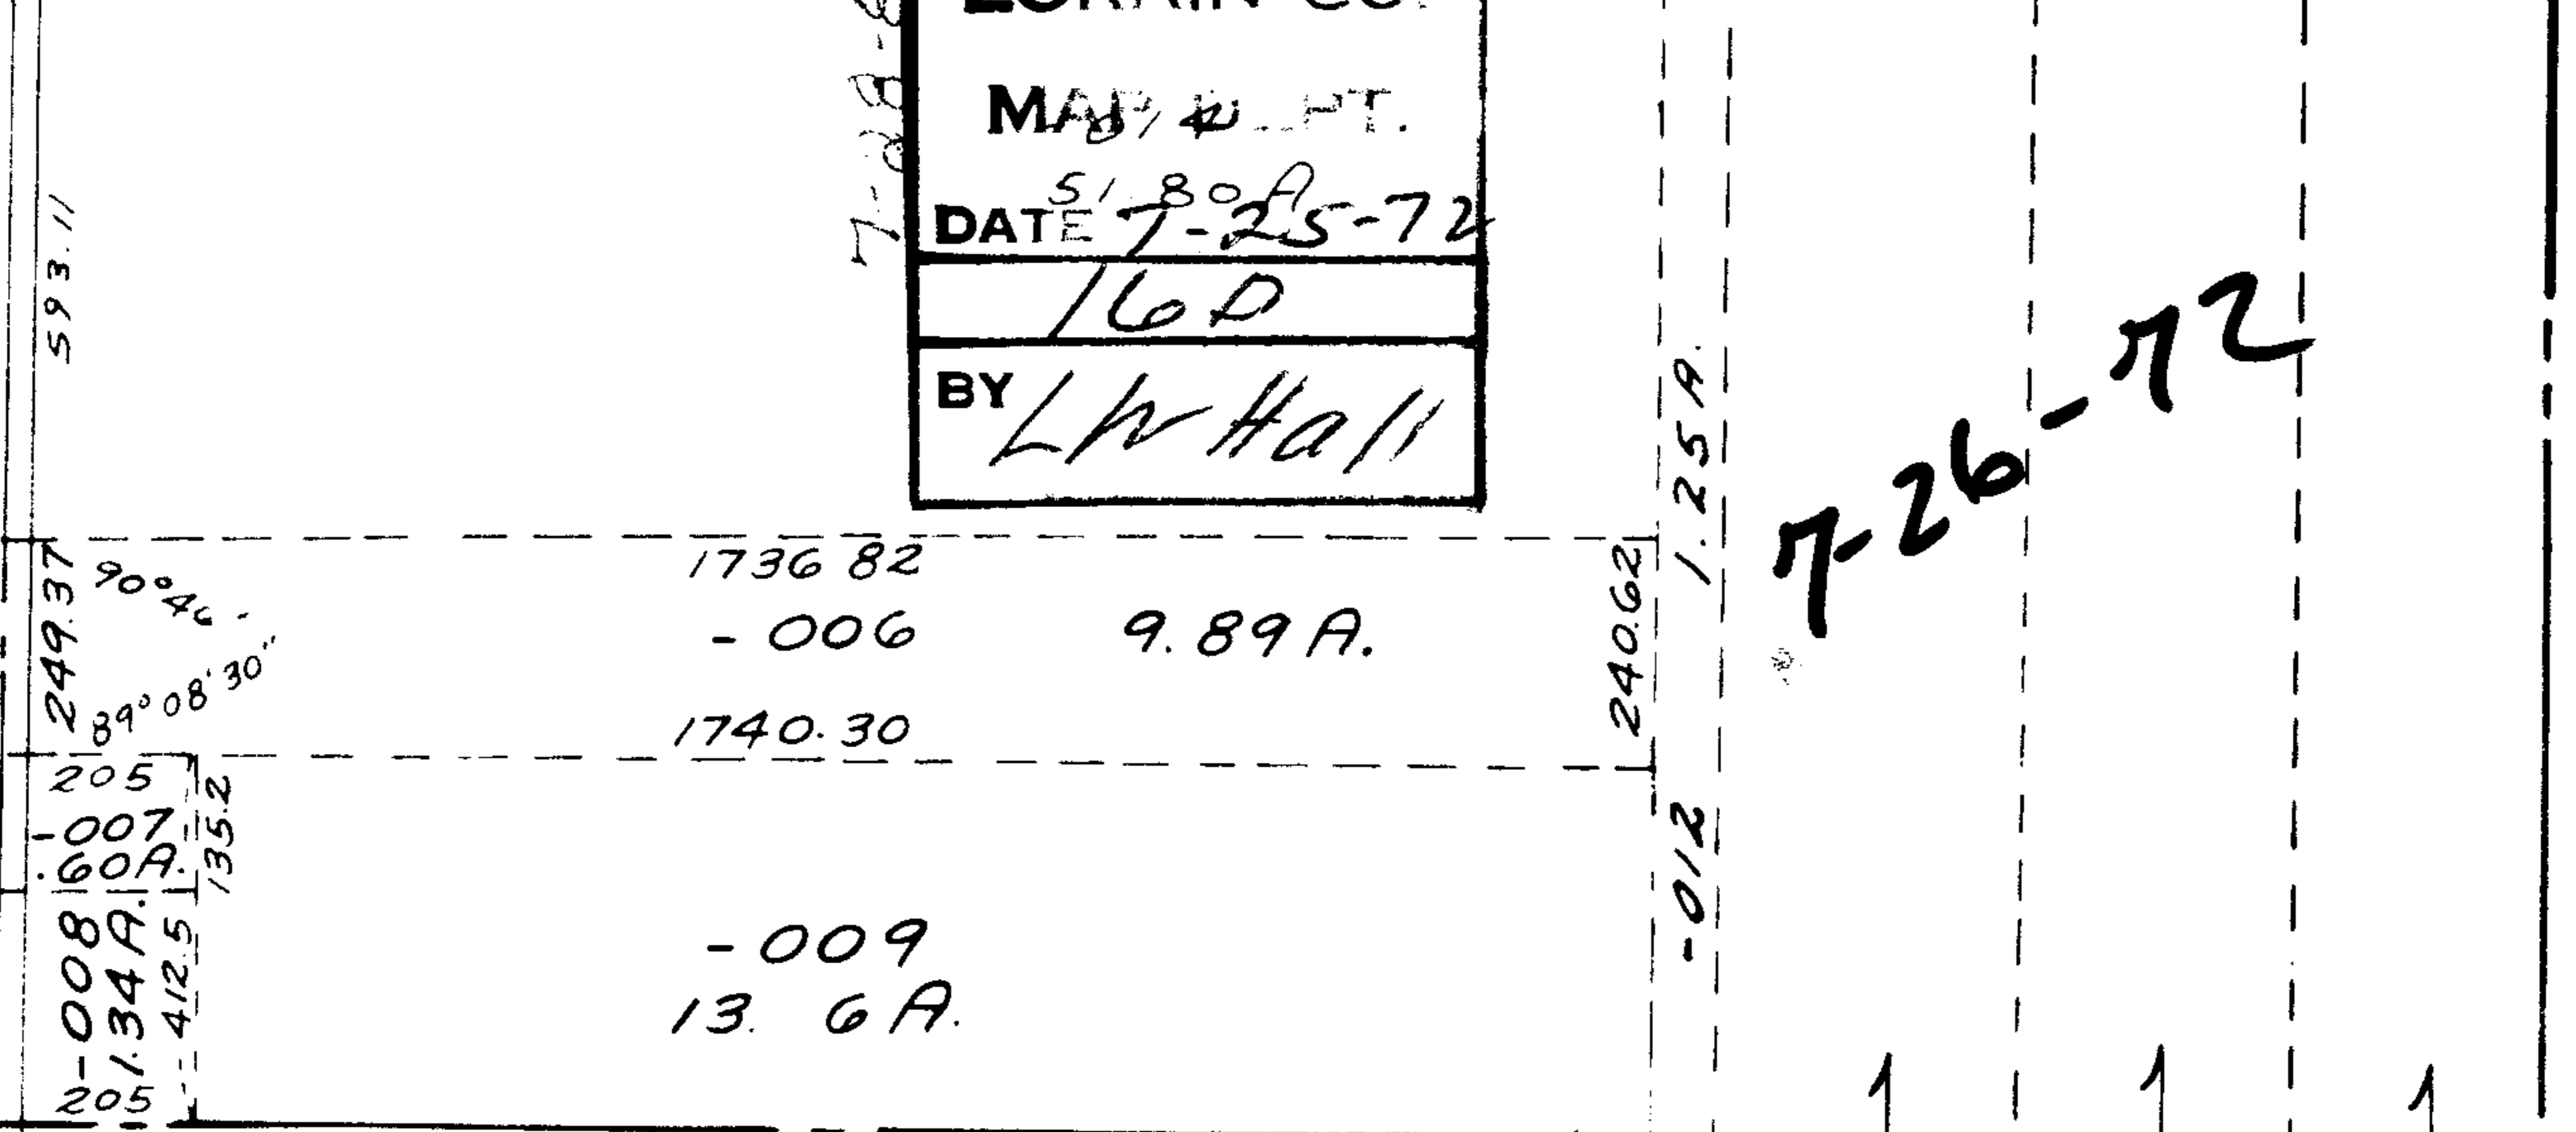

Trans. sheet
already filed

7-26-72

EWH
OK

007
008
009