

Pt. 4.50

Pt. -

6141


6141

APPROVED
LORAIN CO.
MAP D
DATE 7-26-72
6-29+6-30
BY L W Hall

20

Pt. -013
Pt. 26.39 A.

see 6-30
→

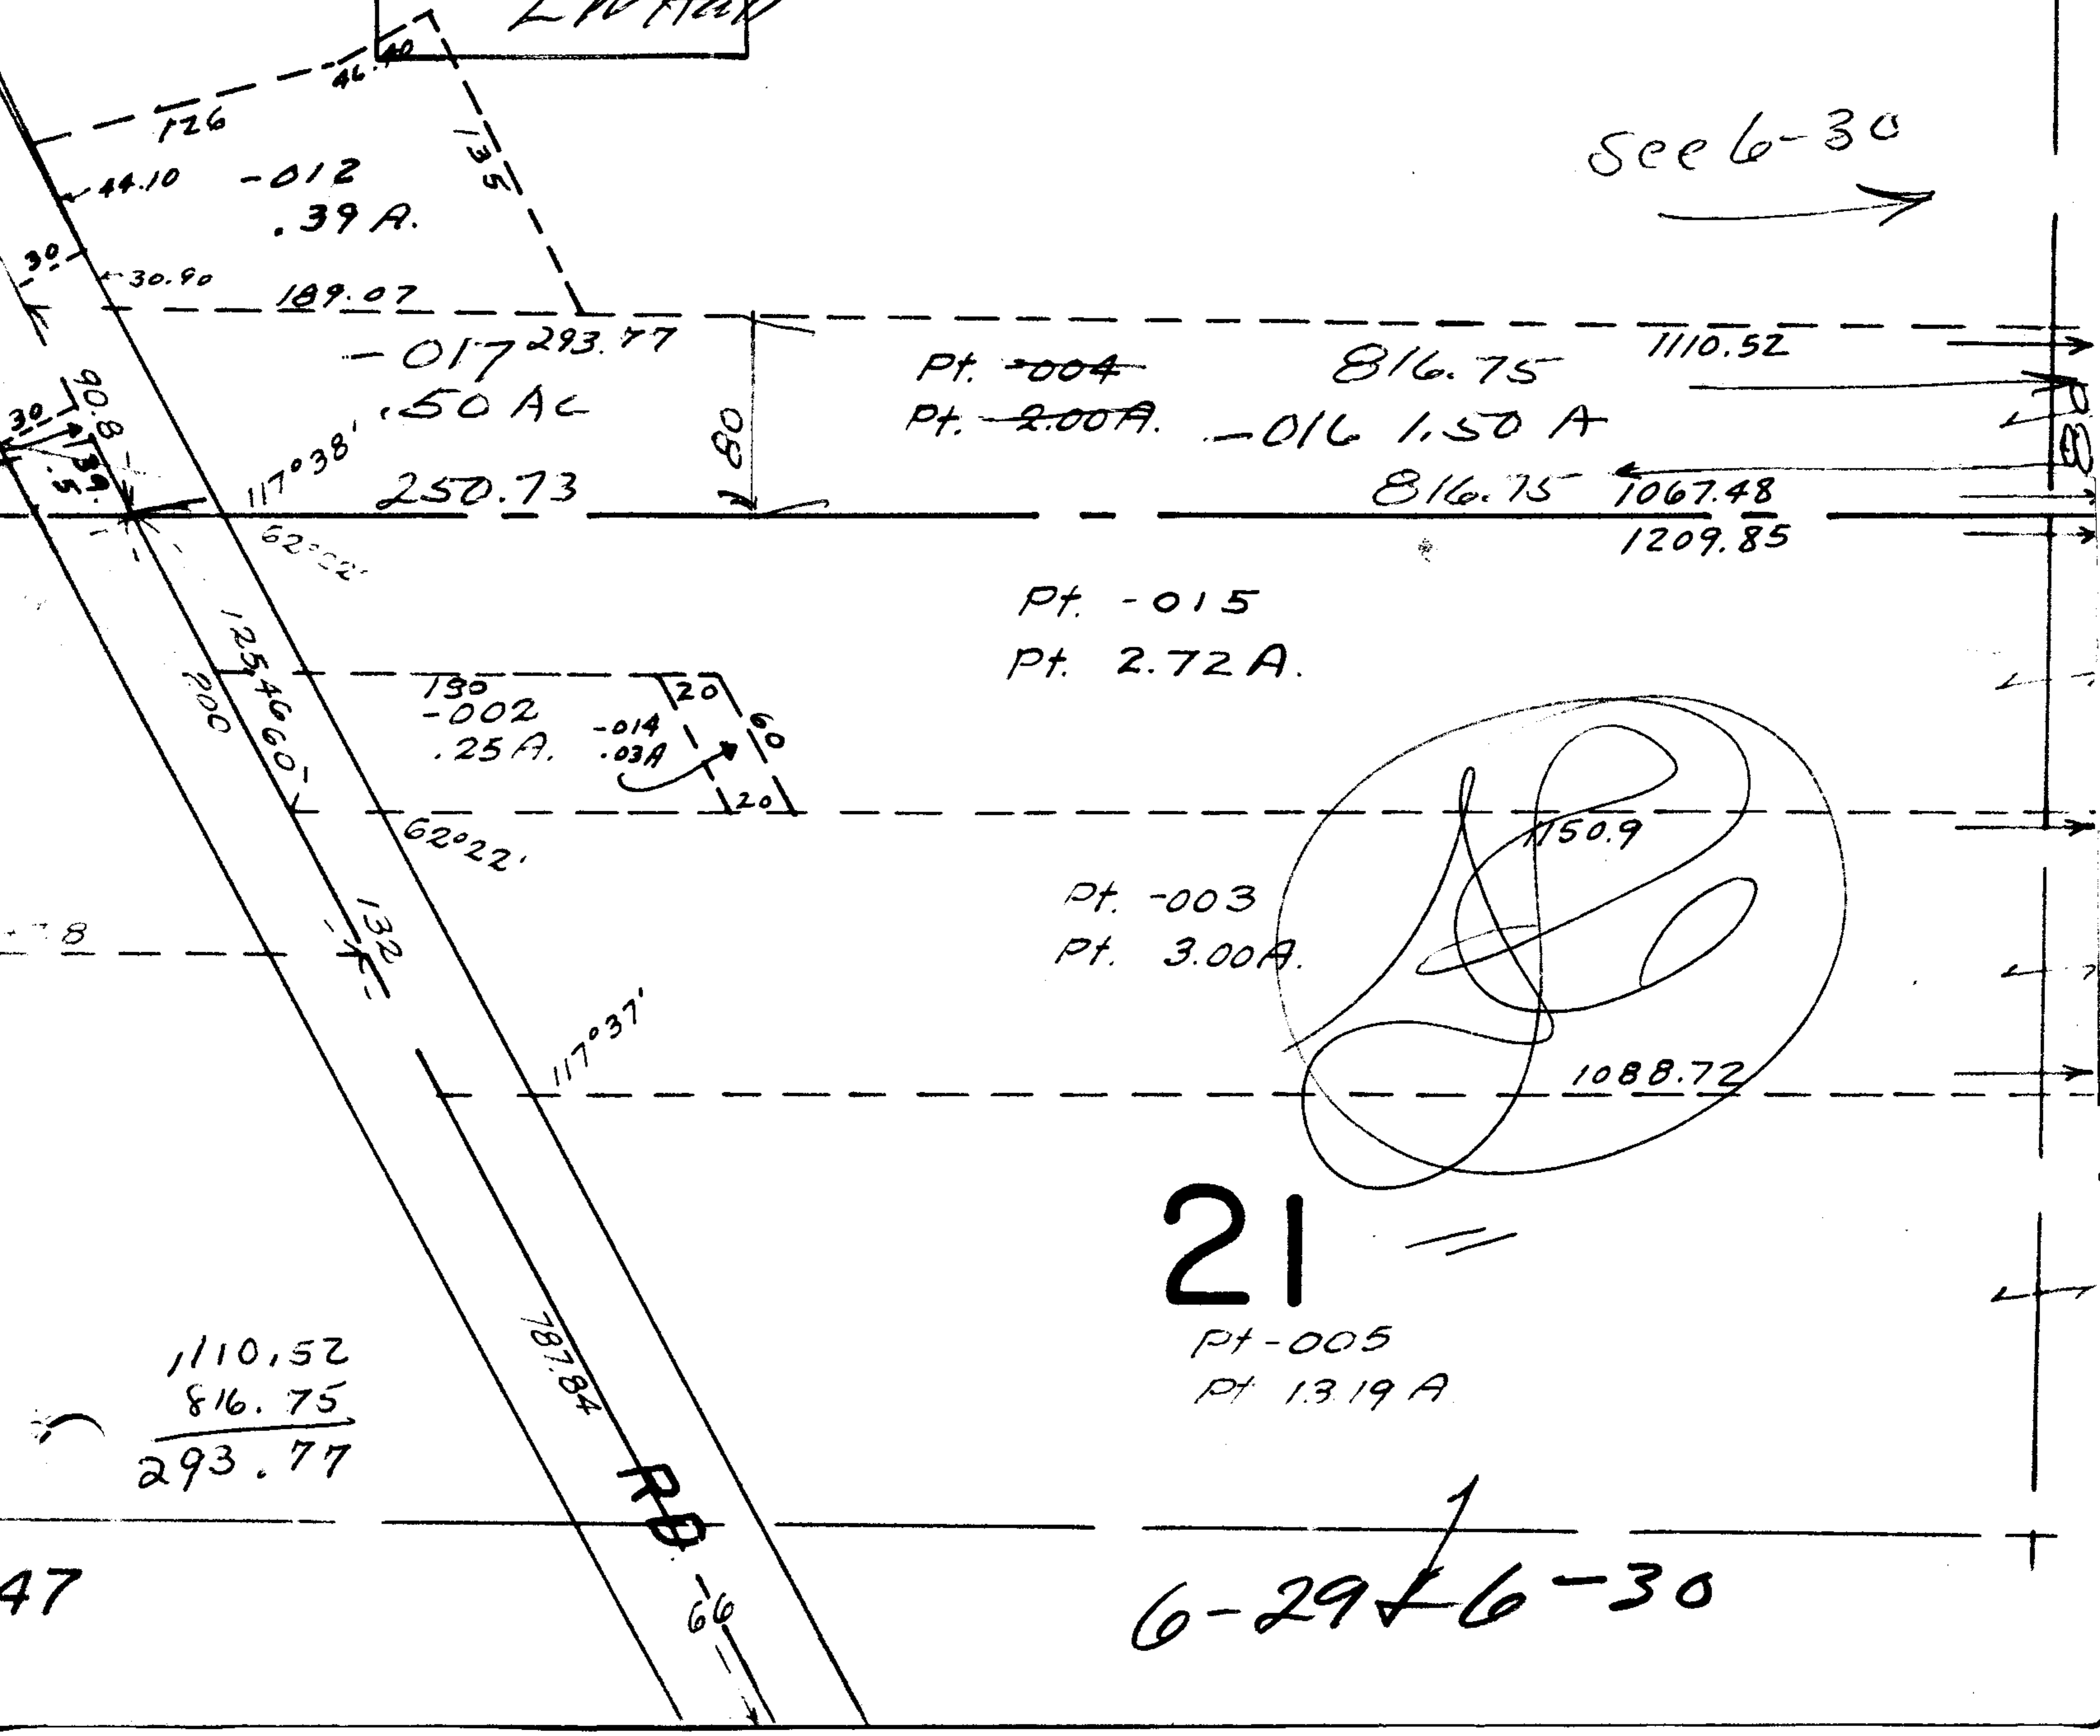

Pt. -015
Pt. 2.72 A.

Pt. -003
Pt. 3.00 A.

21

Pt -005
Pt 13.19 A.

6-29+6-30

47