


6179

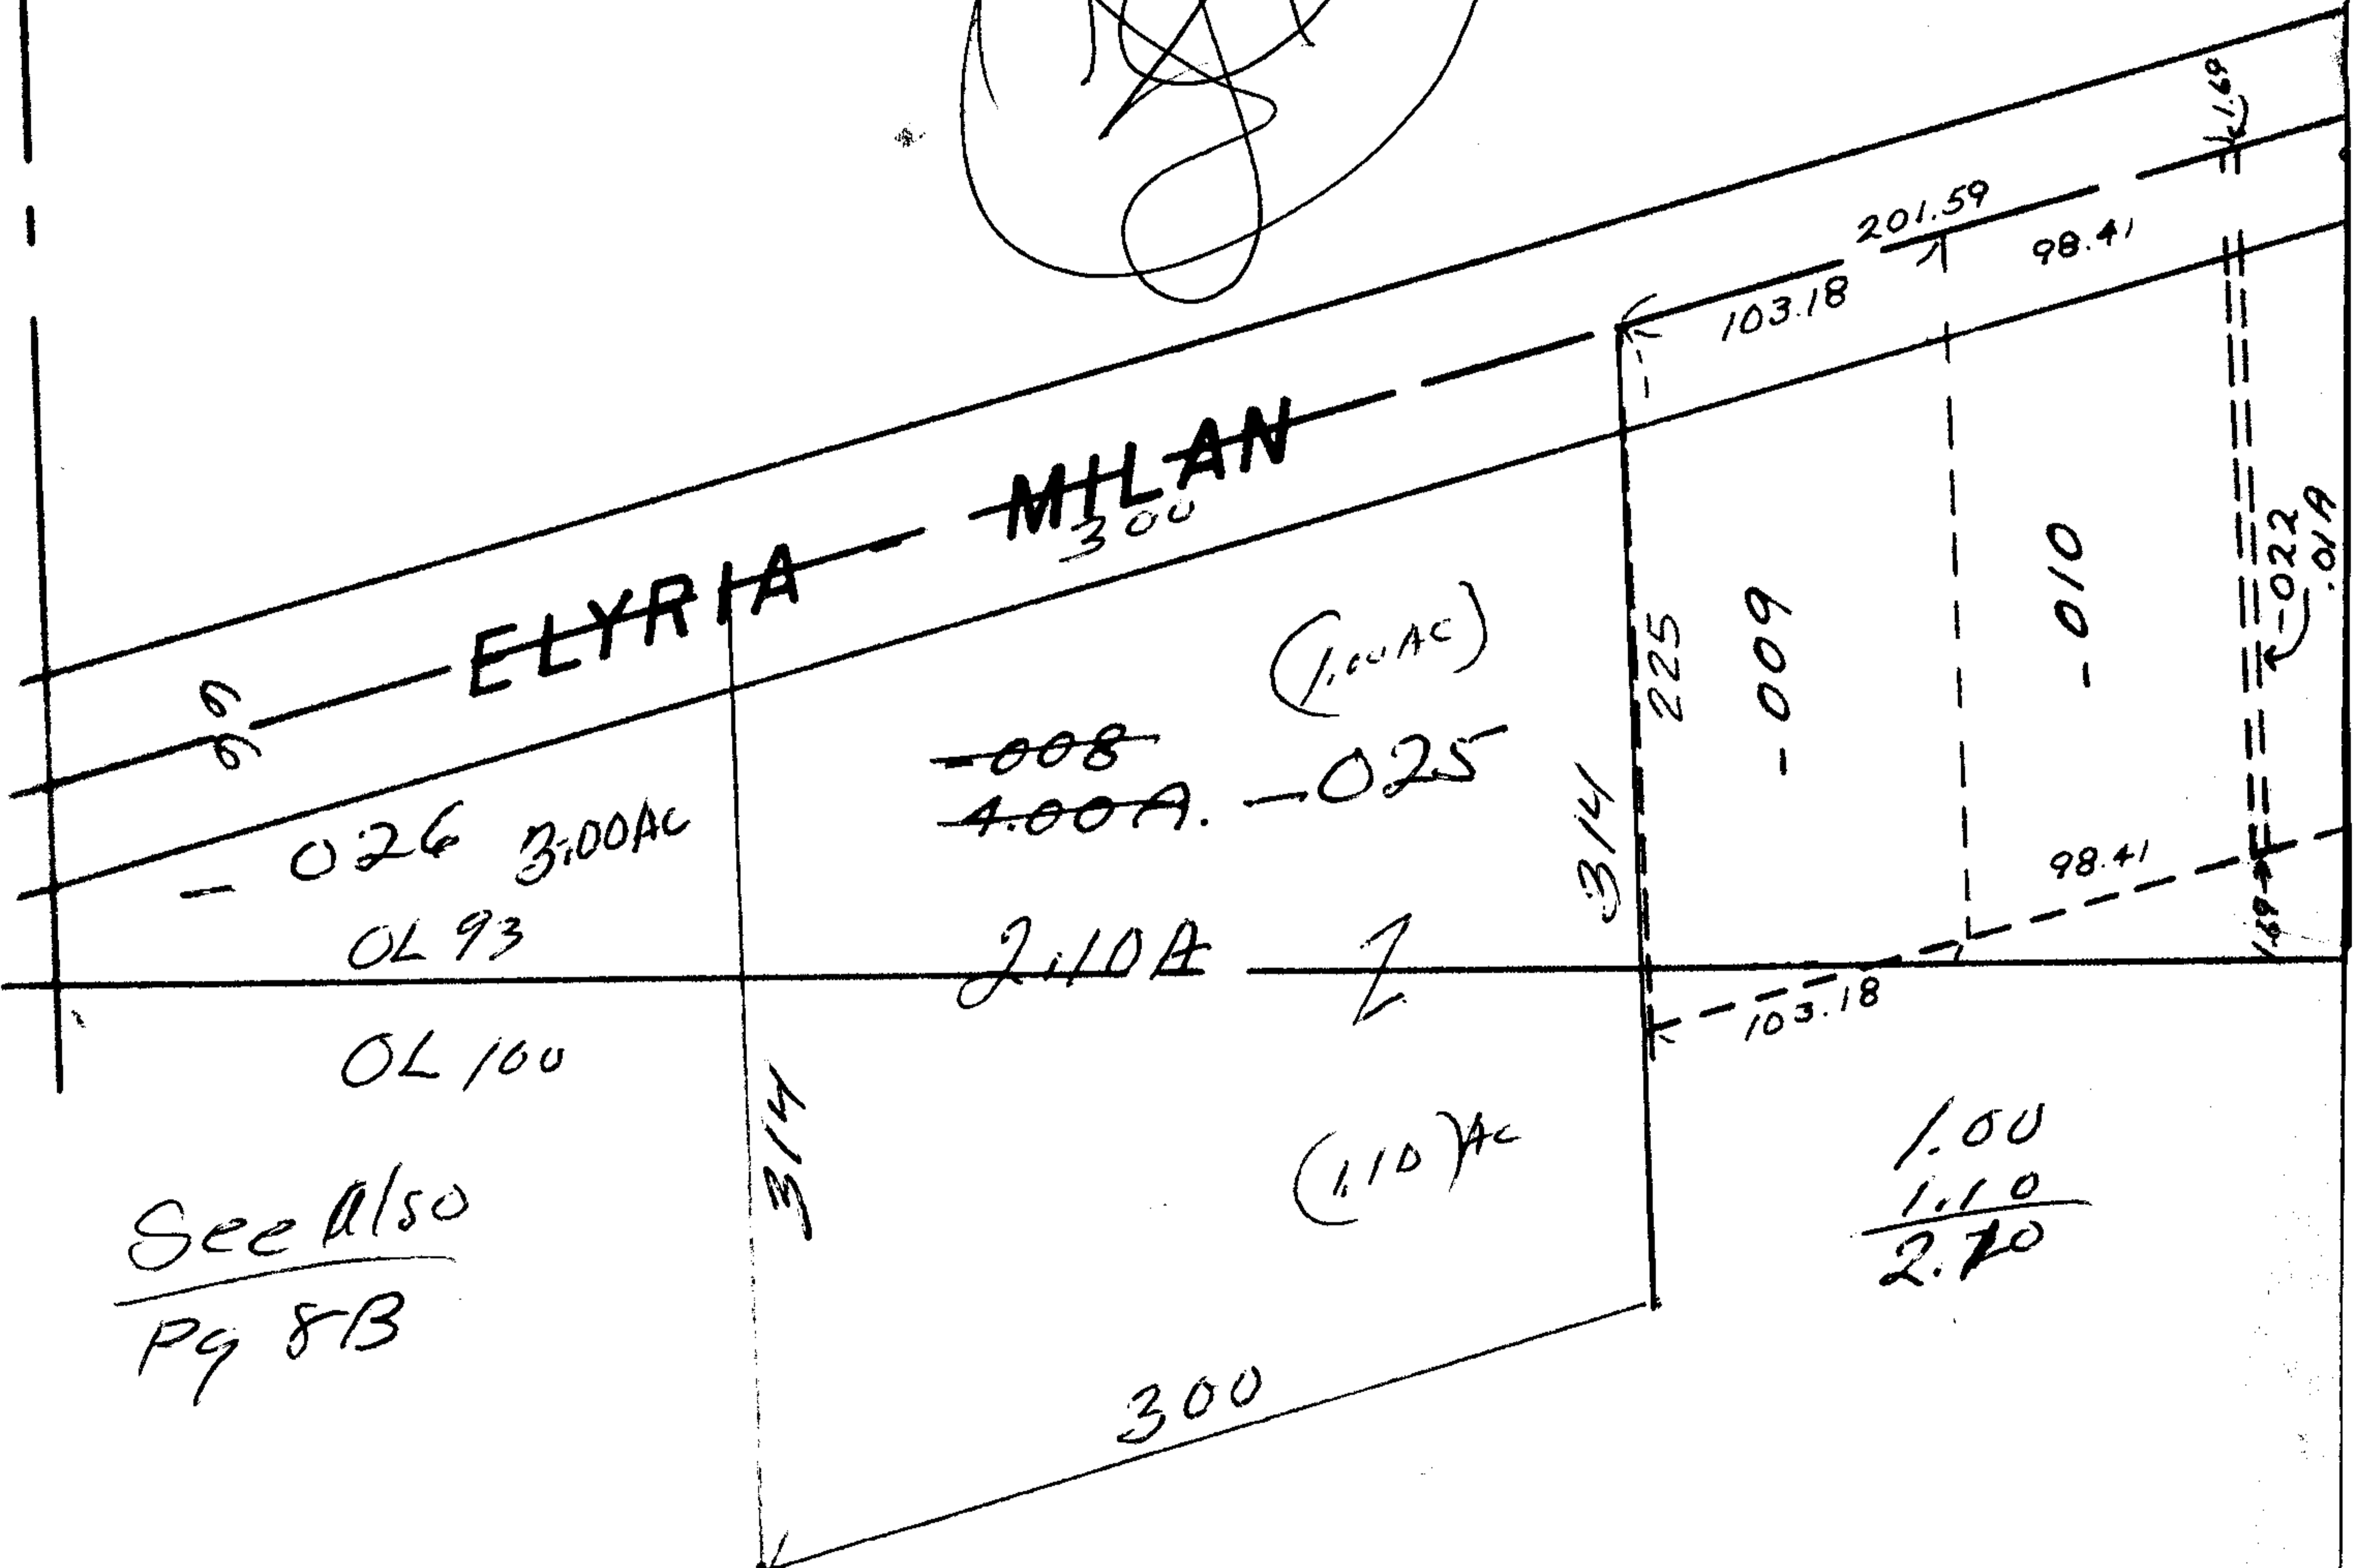

6179
 APPROVED
 LORAIN CO.
 MAP DEPT.
 DATE 8-2-72
 8-00-093A + 8B
 BY LWH/HA

86
 8-2-7-83
 113

See also
 Pg 8B

1.00
 1.10
 2.10

Copyright 1964
 8/17/65

8-00-093-A

HENRIETTA

SCALE: 1" = 100'