

6180

1013.26

300

150

250

100

250

250

250

150

749.27

-019  
4.98 A.  
-021  
3.95 A

~~1.03 AC~~  
-020

300 ✓

-018  
.69 A.

1024.4

300

6180

-013  
5.74 A.

A. 103 AC  
LORAIN  
8-3-72  
03-00-108B  
BY L.W. Hall


-003  
11.11 A. Dup #1  
27 A. Dup #2  
11.38 A. Total

103

LORAIN

1035.52

-014  
5.75 A.

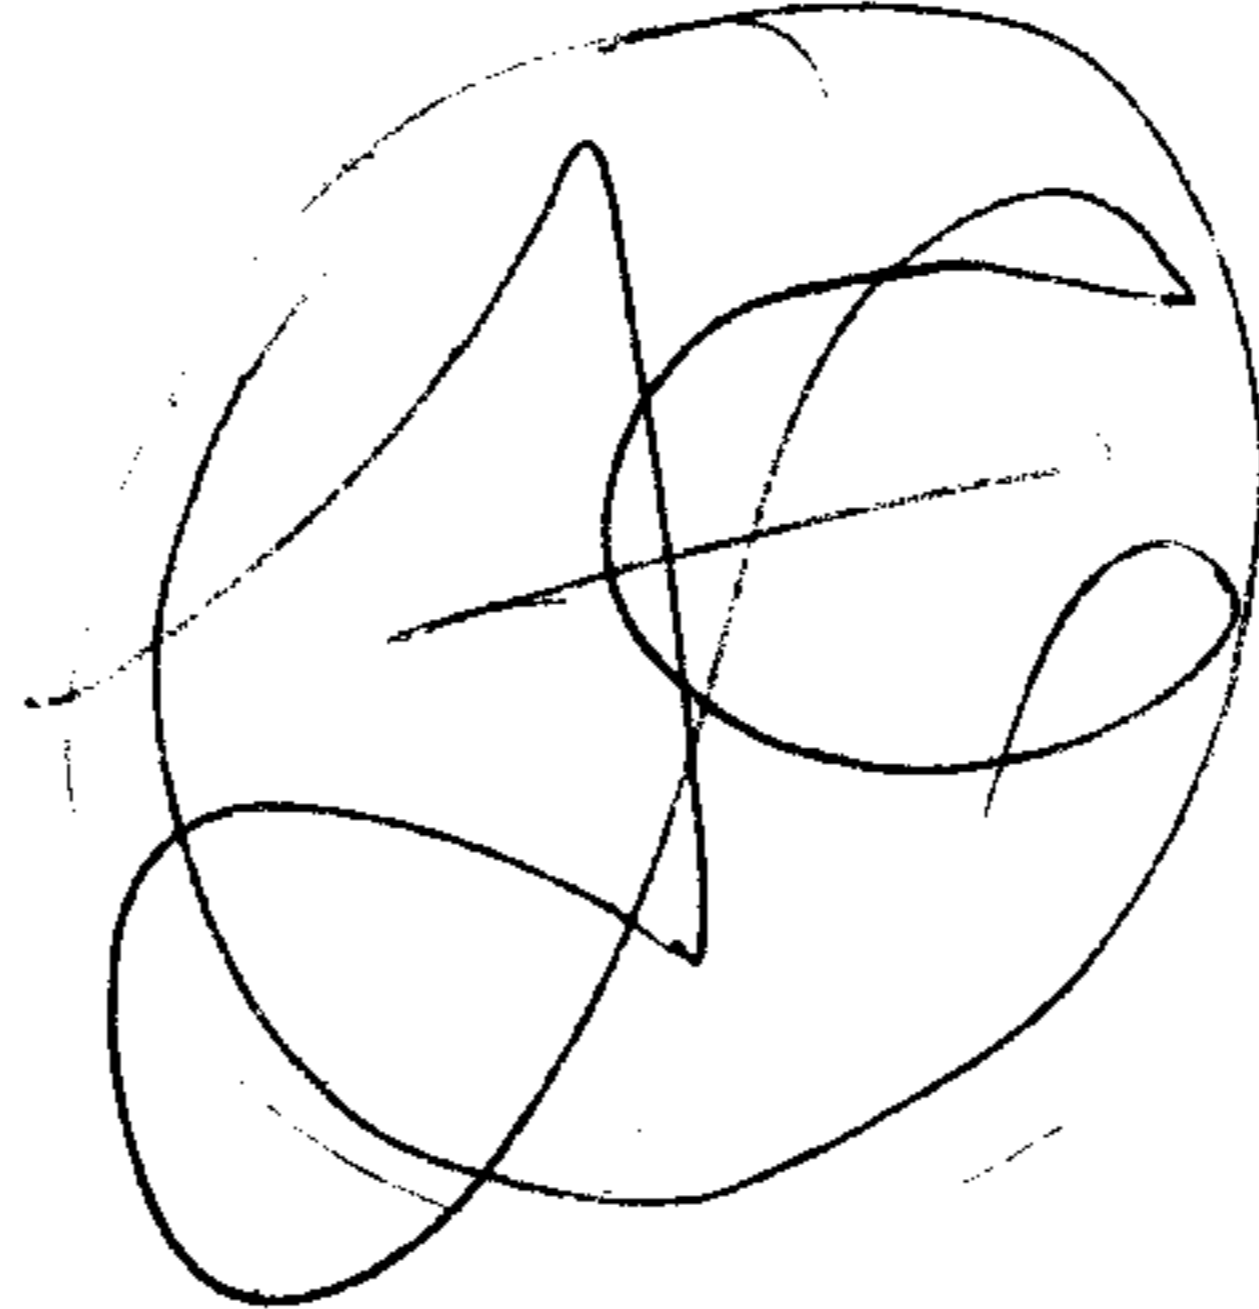

686.7

Pt. 03-00-105-101-022

Pt. 26.41 A.

.33

130

SEE 3-00-109-B

3-00-108B

03