



61810K
GMA

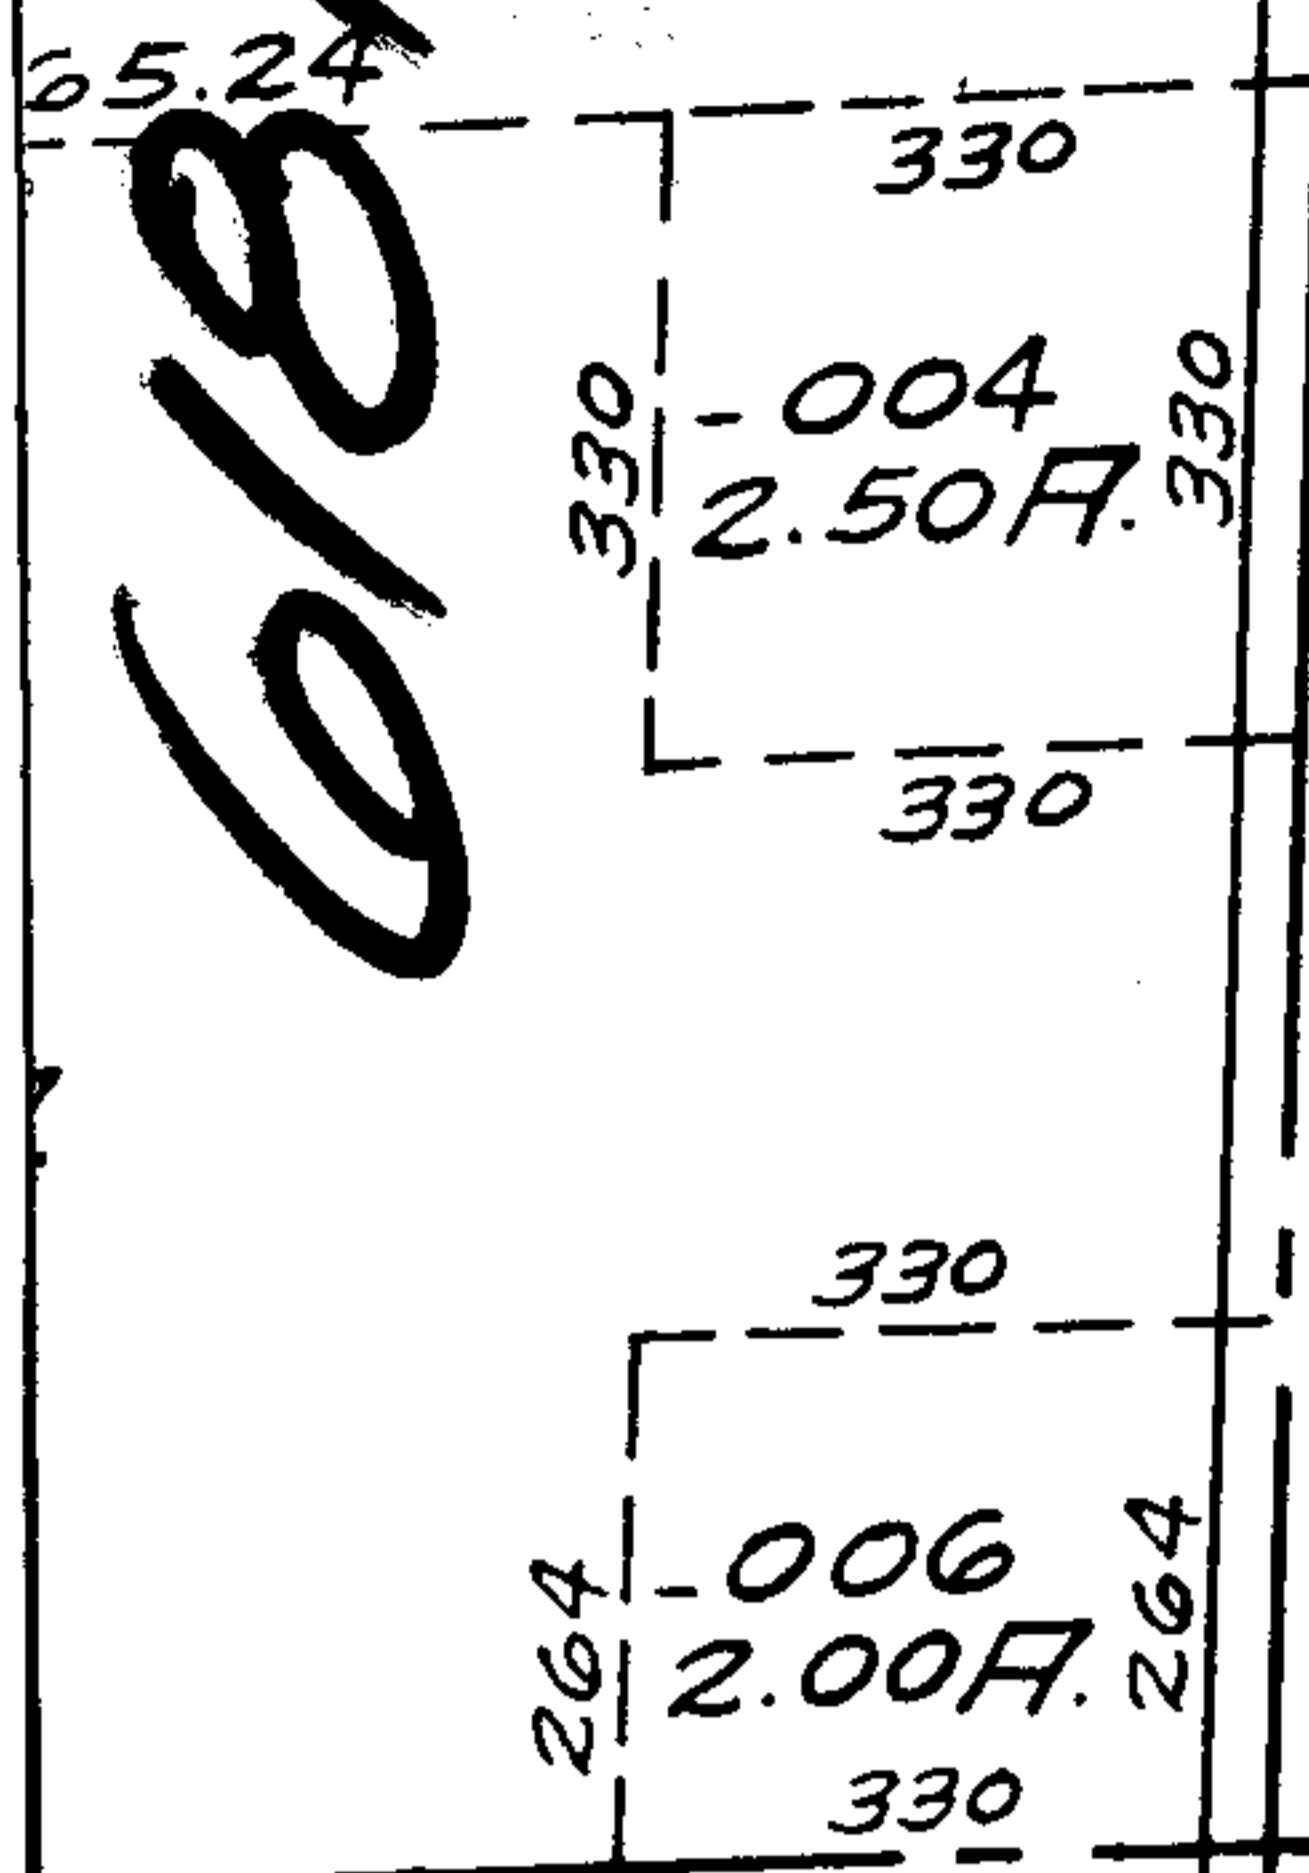

-001
100.00 F.

61

-002
30.00 F.

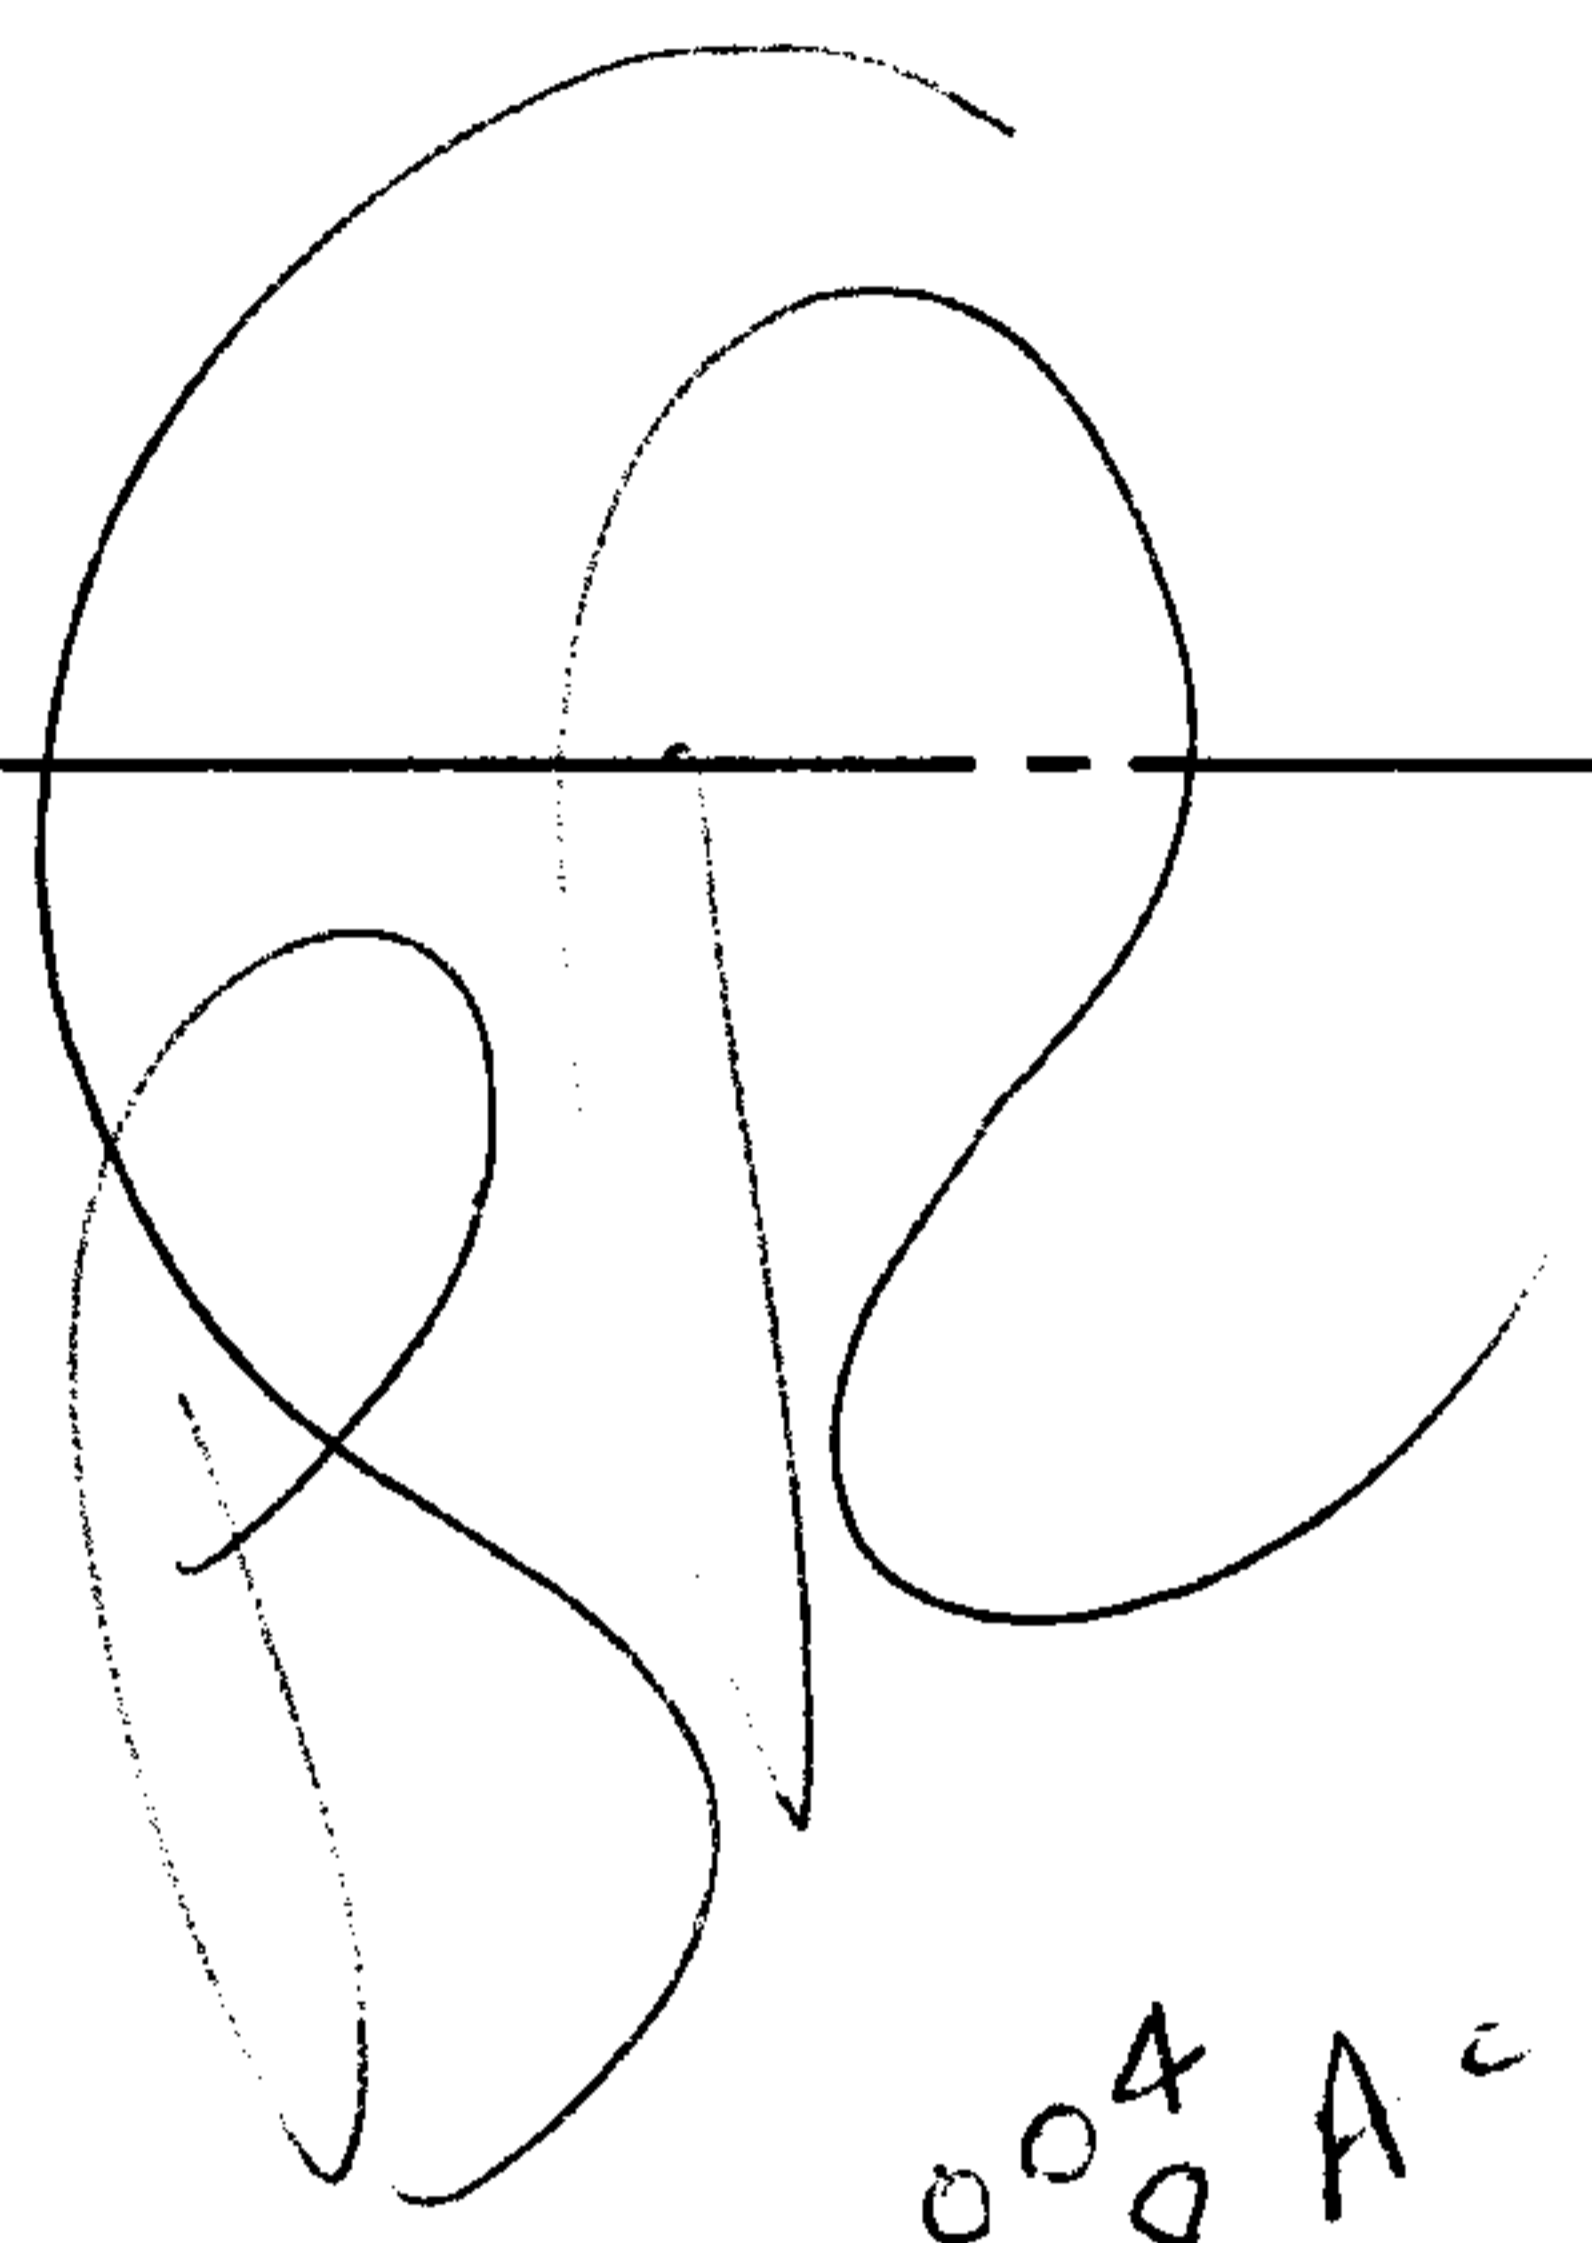

6181

-001
87.00 F.


-004
80.68 Ac.

80


-002
50.00 F.

APPROVED
LORAIN CO.
MAP DEPT.
DATE 8-3-72
14-D
BY <i>[Signature]</i>

7-28-86/hh

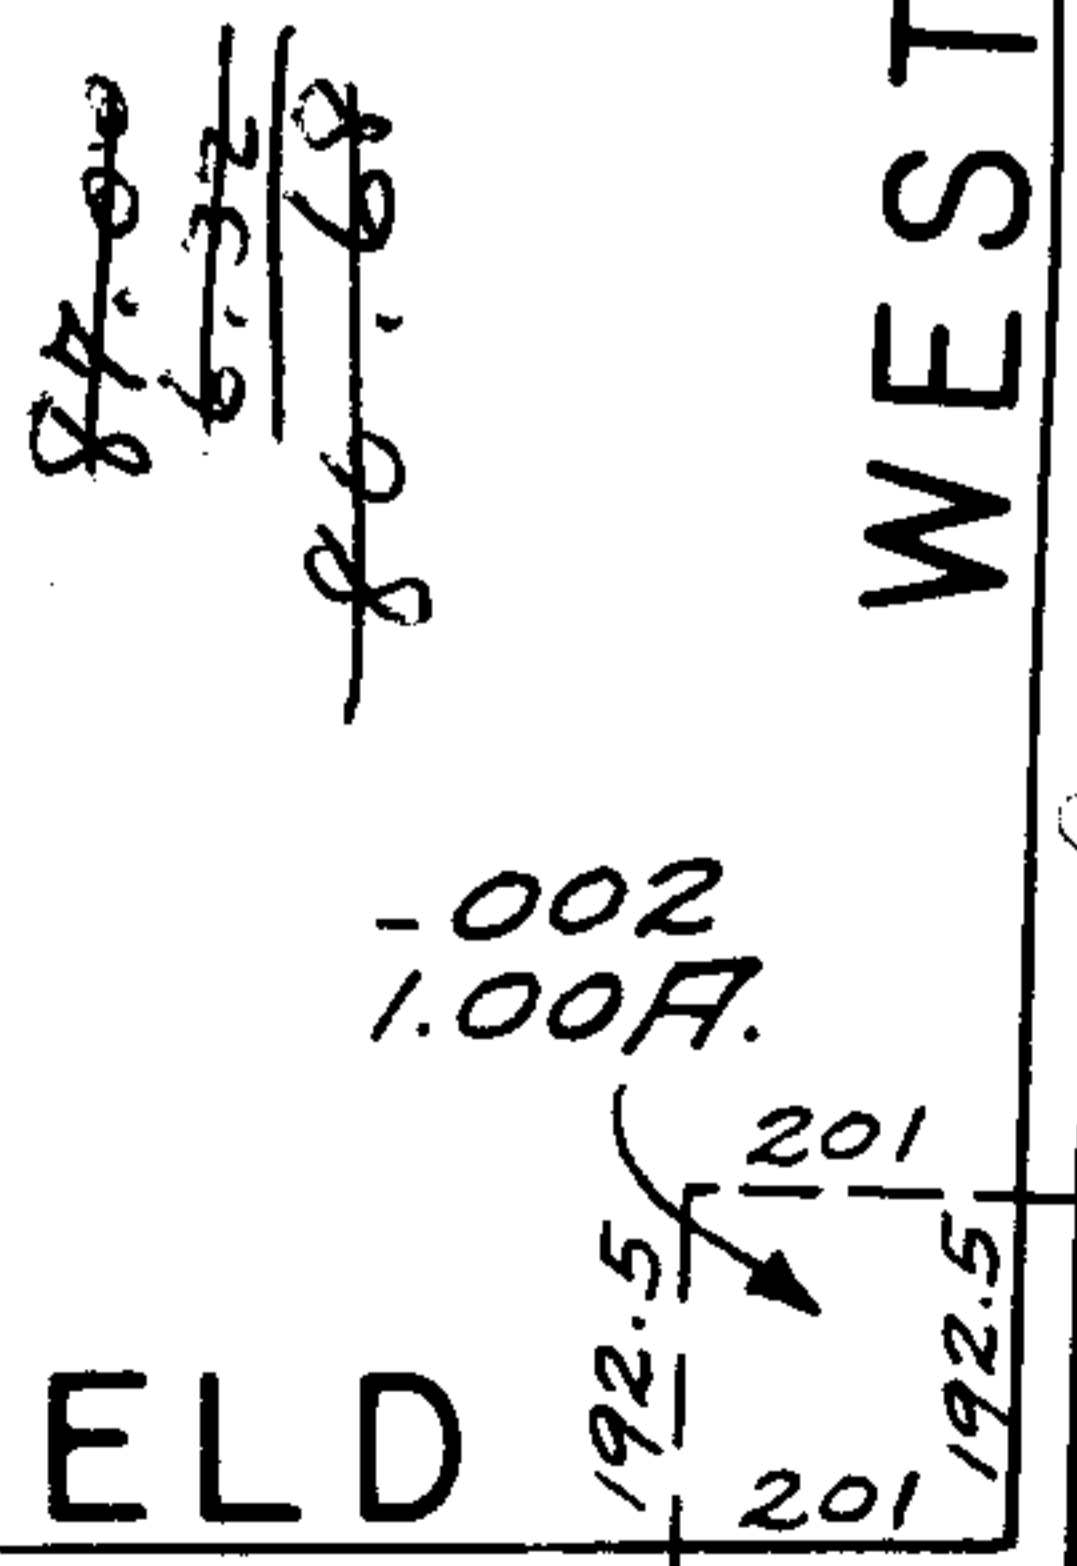

WEST (60)

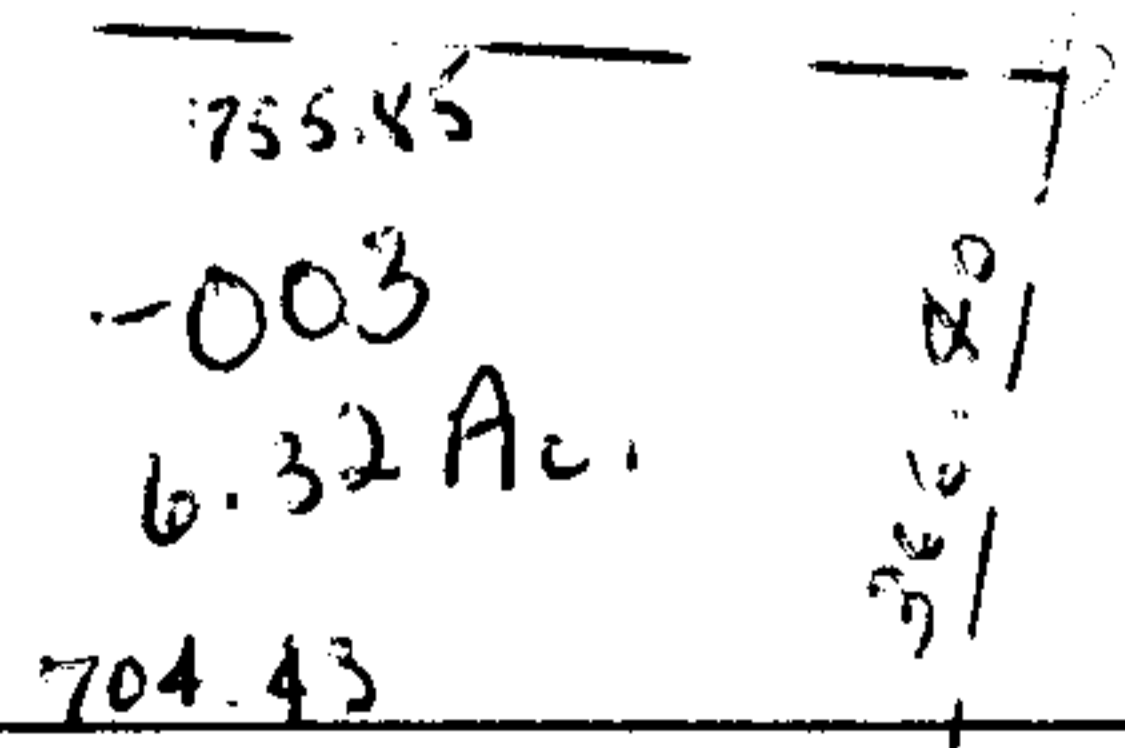

ELD

RD

303

SEE 14-H

TWP

LOTS 12 TO THRU 20