


6217

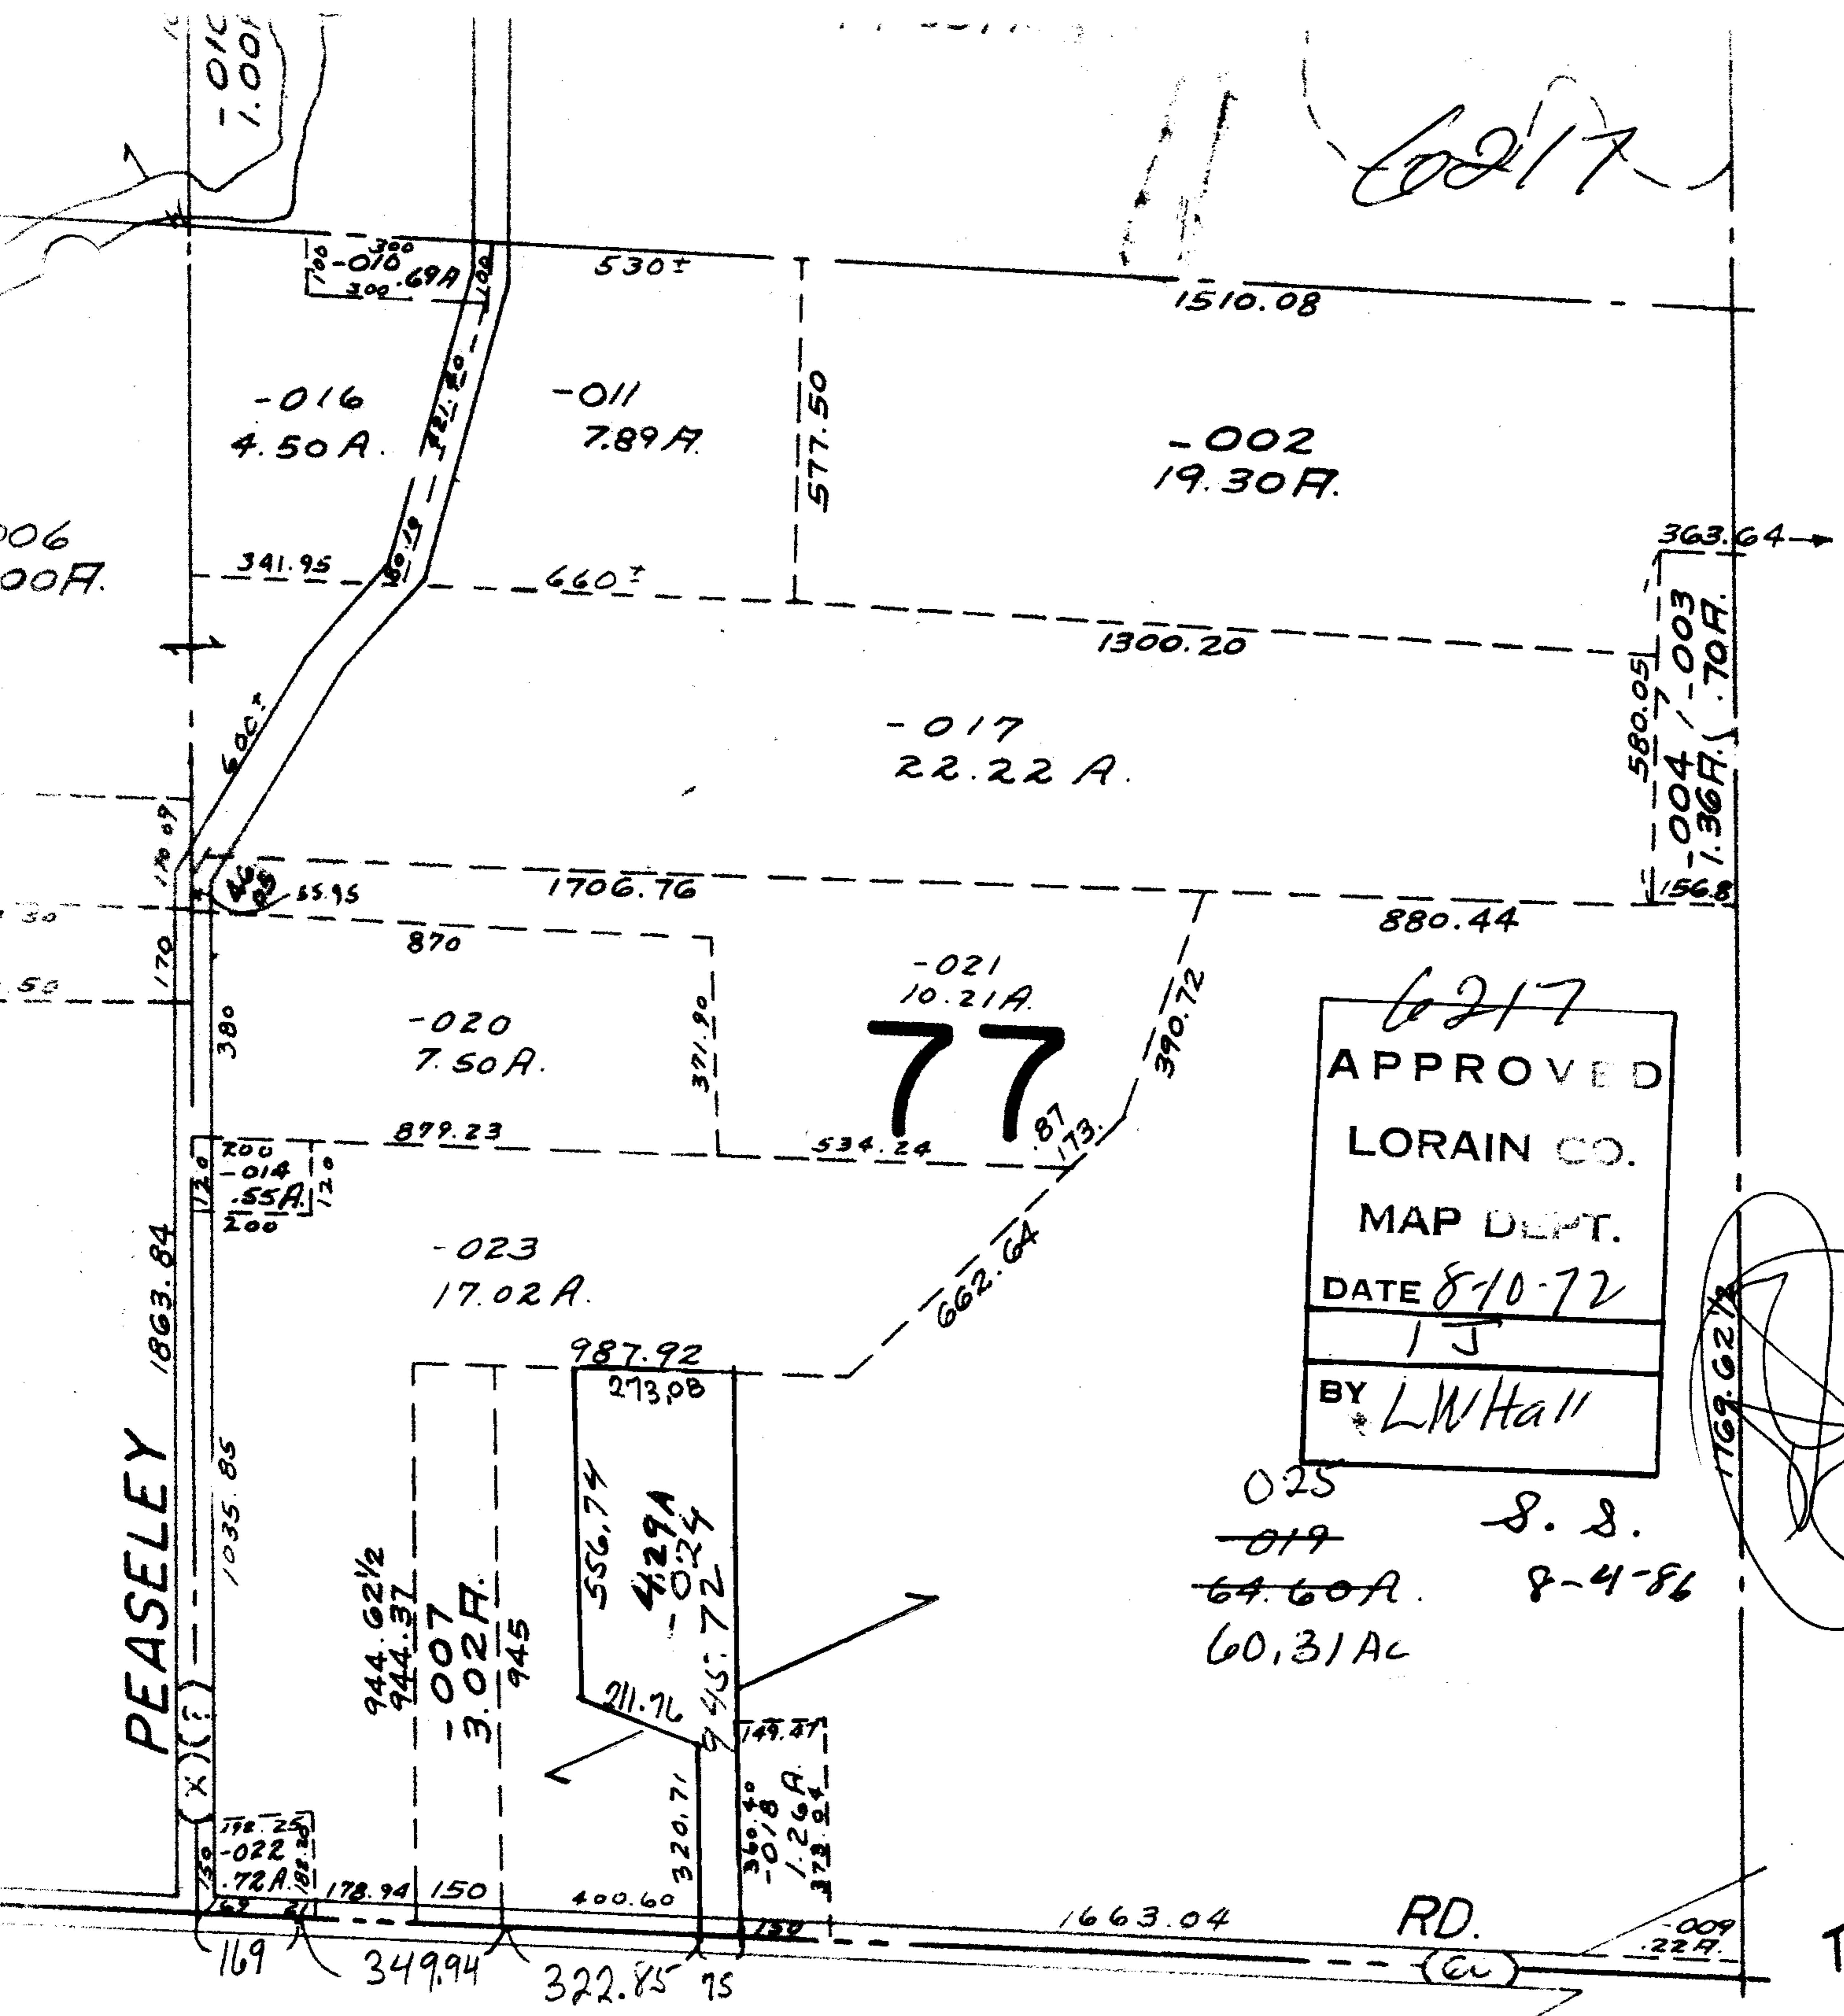

6217
 APPROVED
 LORAIN CO.
 MAP DEPT.
 DATE 8-10-72
 15
 BY L.W. Hall

025
~~019~~
 64.60A.
 60.31Ac
 S.S.
 8-4-86

1169.6218

OHIO

TURN

LOTS 51, 52, 61, 62,
 67, 68, 77, 78