


6819

65420

~~PL. 11-00-005-000-034~~

~~PL. 42.27A.~~

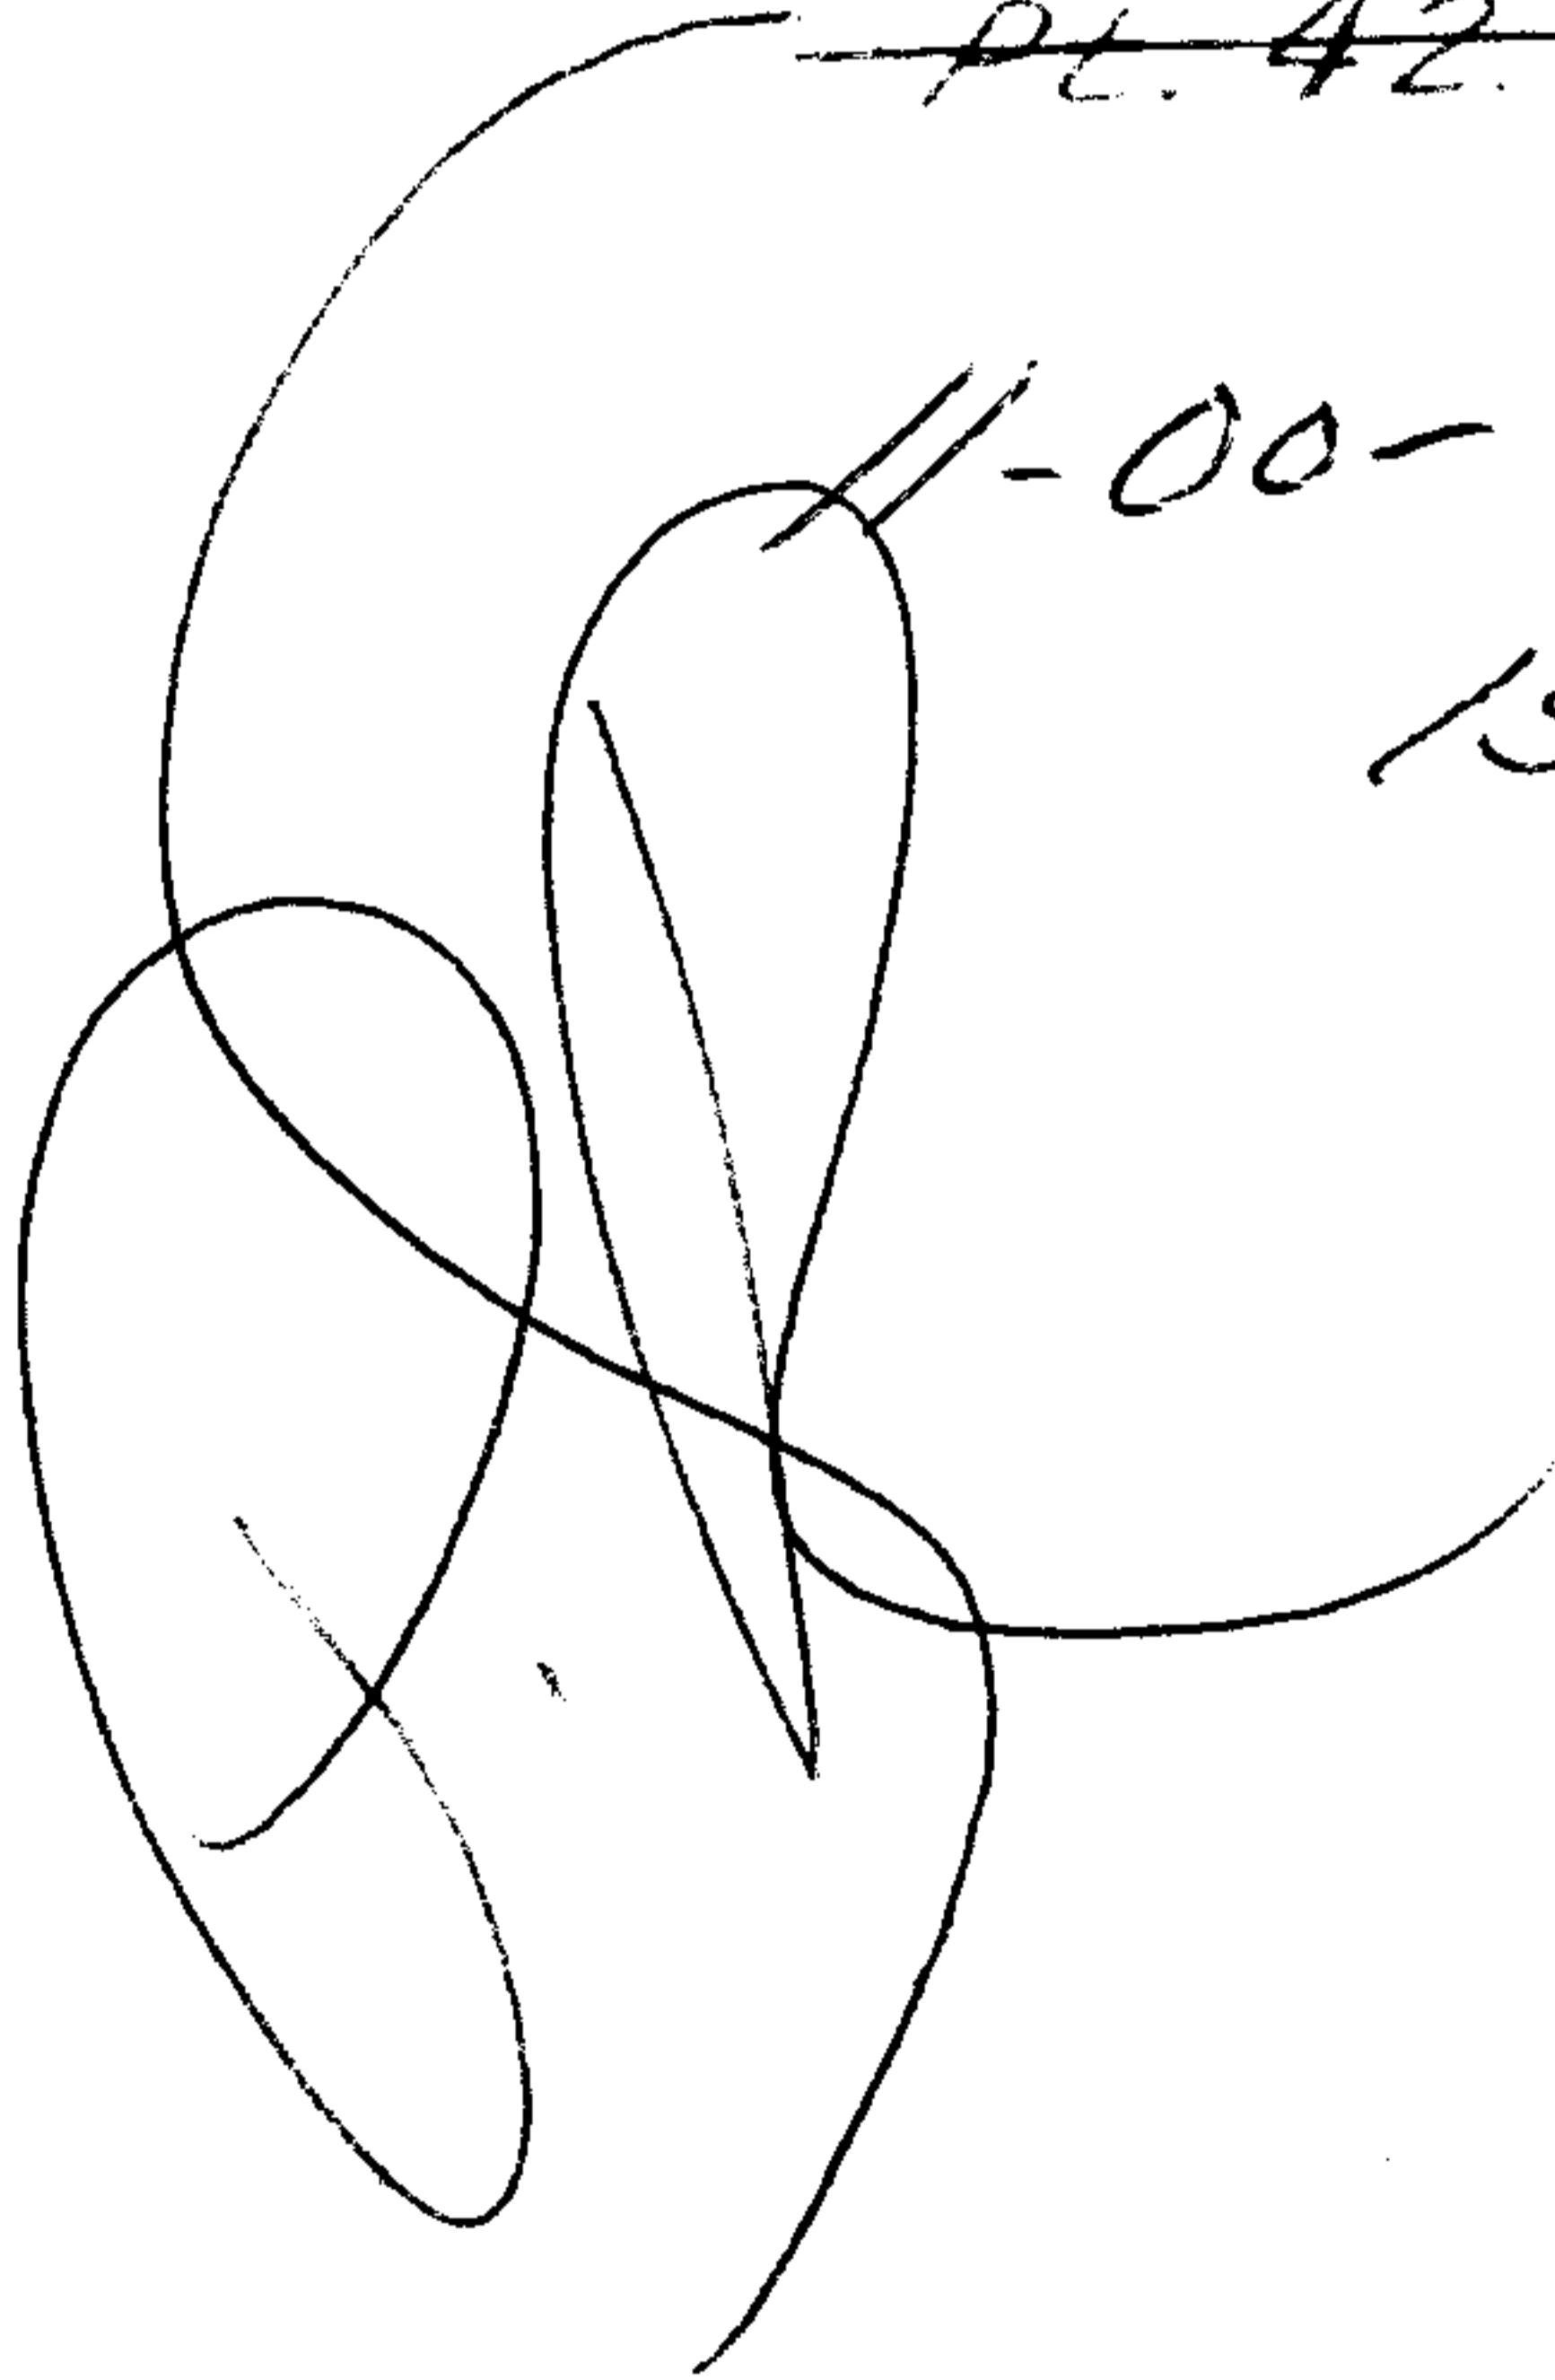

11-00-016-000-034

15.99 AC <sup>30.00</sup> V  
J. C. V  
J. C. V

~~Handwritten scribble~~

AVA

11-00-016B

COWLEY