

RD.



839.5

-001
5.00A.

837

-002
4.90A.

-003
4.91A.

-004
14.88A.

1014.18
6224
-005
20.00A.

511

10

260

4

321.26


841.5

010
~~-006~~
~~47.16A.~~ 39.31AC

250.81
118.02

-011
7.85AC

883.08

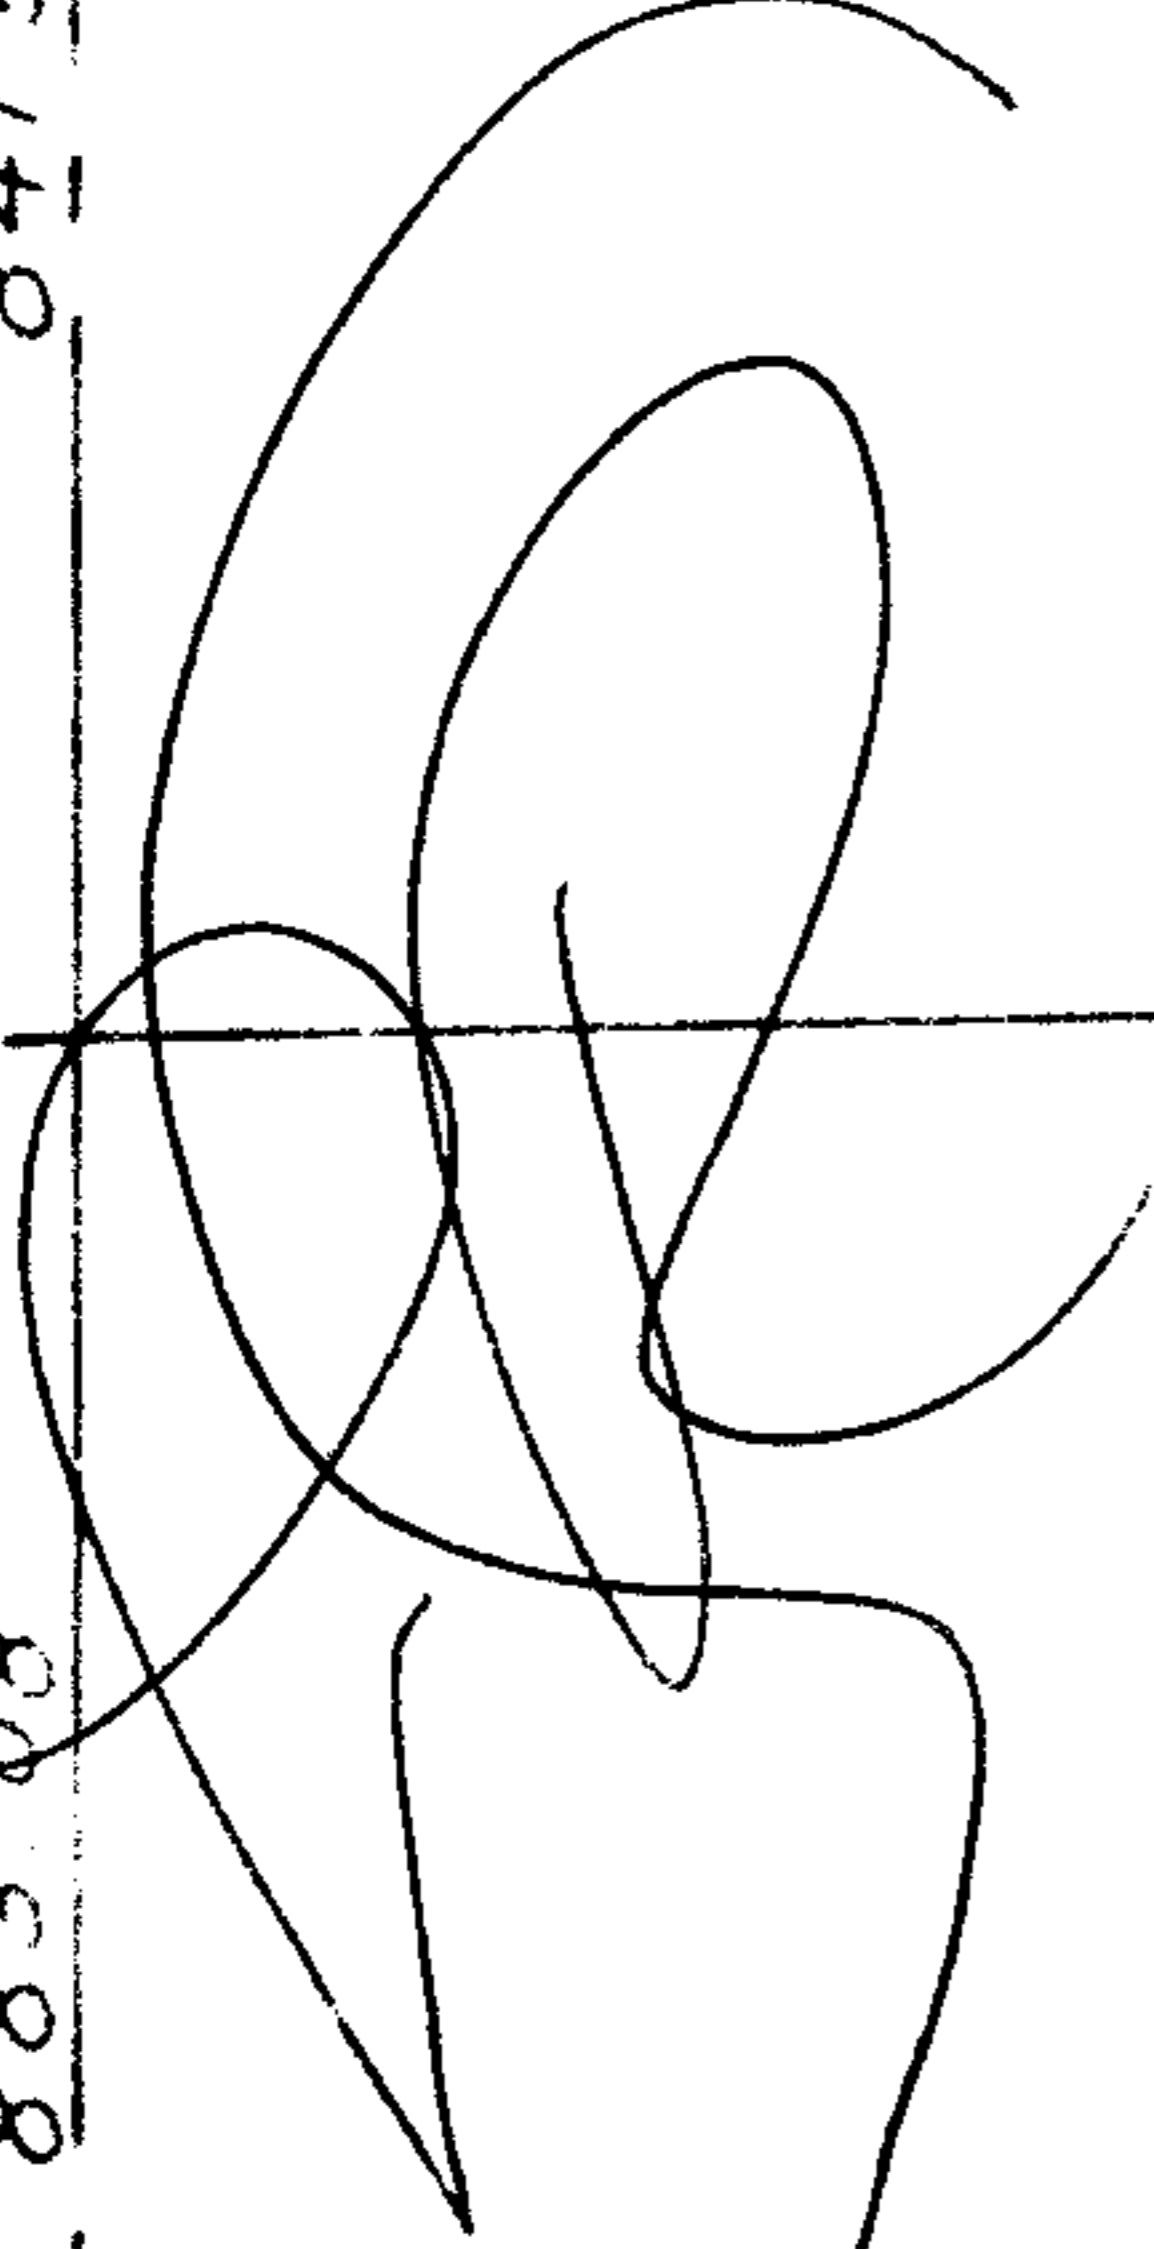

7-28-86 L.L.

6224
APPROVED
8-14-72
13B
LW Hall

300
-009
.83 A.
394.4

349.14
-007
1.00A
-008
1.00A
323.4

-001
120.00 A.

13

Old Oberlin Res.

002
26.00 A.

(VERMILION RD.)

1320

177.01

659.77

-001
4.32A.

595.69

453.47