


7-00-010-B

45-99.594 = 105.25

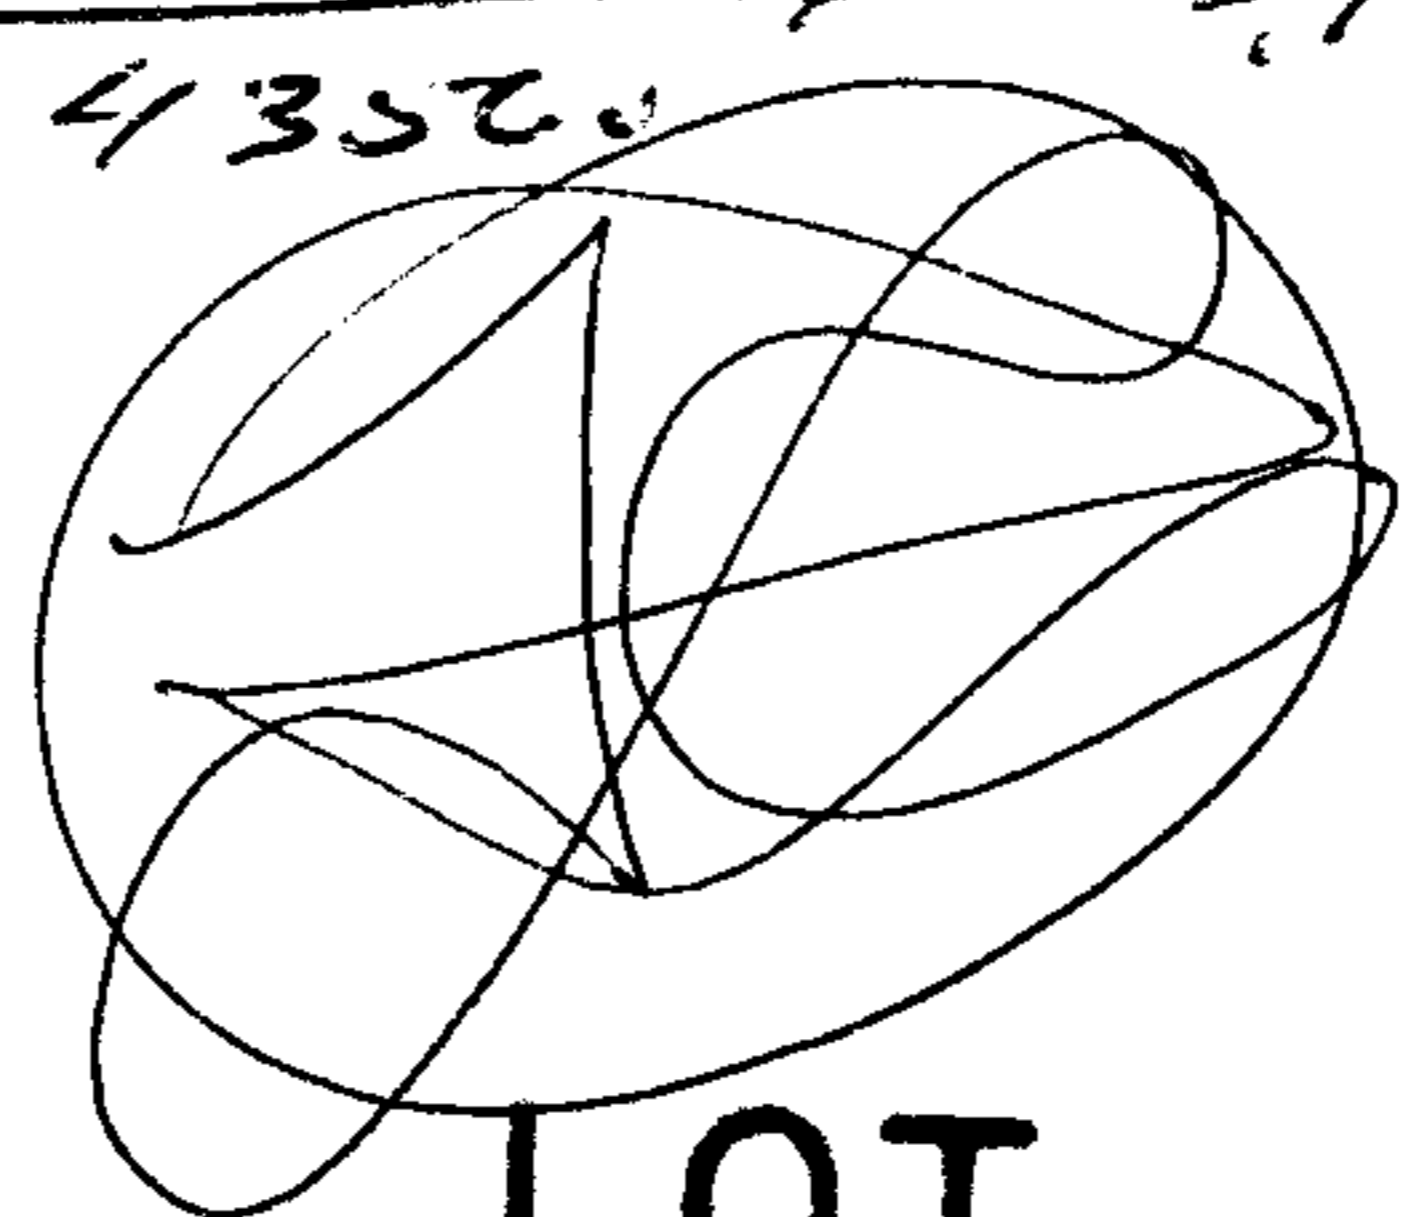

SE 1/4 LOT 9

6229  
 APPROVED  
 LORAIN CO.  
 MAP DEPT.  
 DATE 8-15-72  
 7-00-009D  
 BY L.W. Hall