

0.77 AC

292

250

314.43

60

240

303

-027
2.25 A.

333.37


-029 • 46 AC.
330

110

198

94.75

60.10

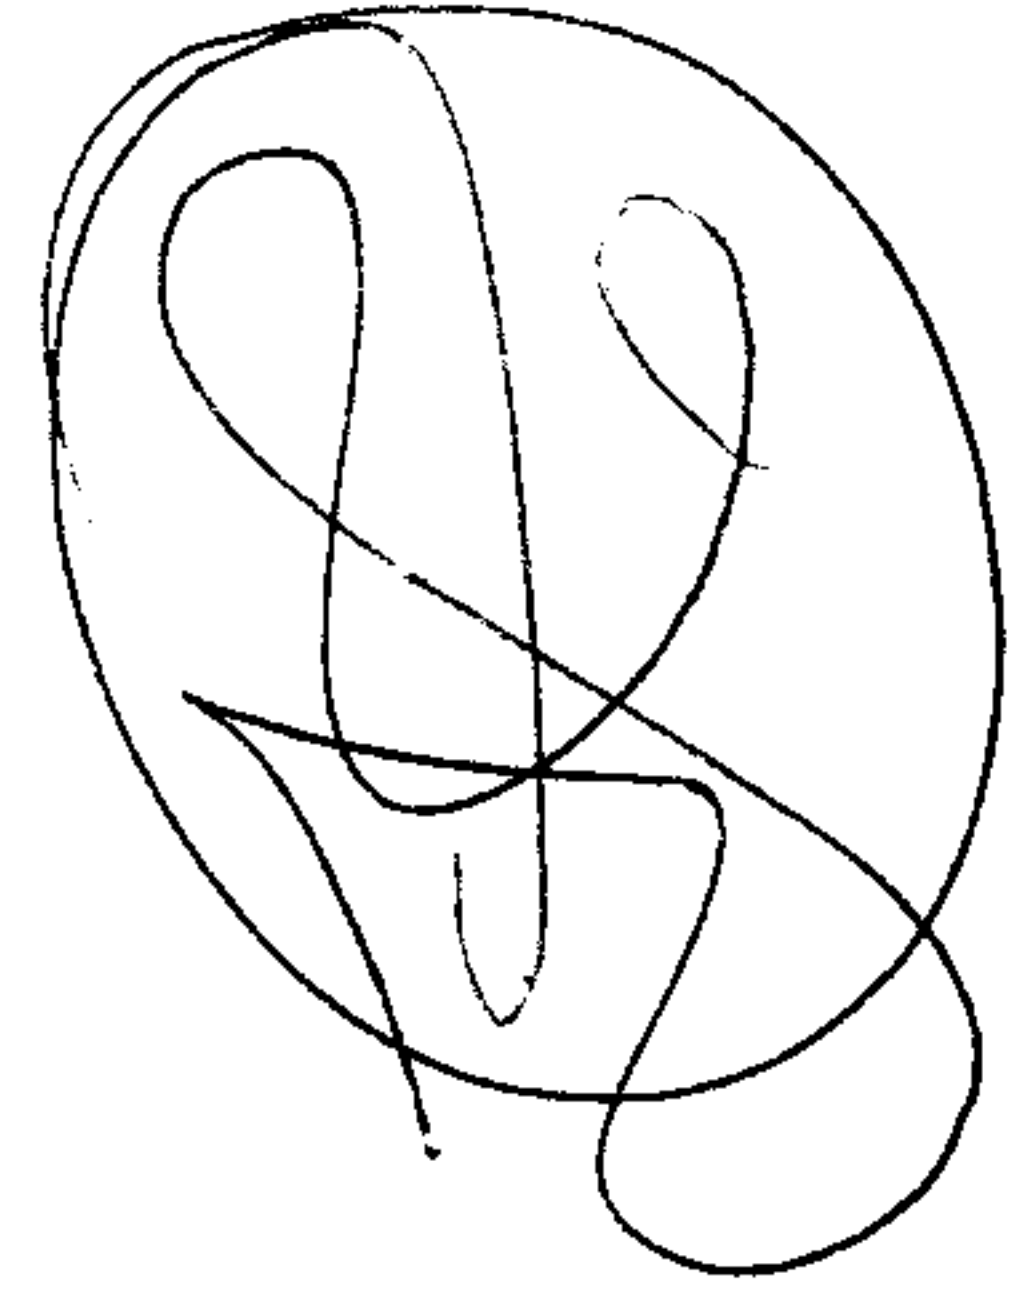

-028
3.40 A.

557.39

~~0.77~~
~~4.20 A.~~
0.77 AC
561.90

-016
4.92 A.

123
46
77

6250

APPROVED
LORAIN CO.
MAP DEPT.
DATE 8-17-72
7-00-004-D
BY *[Signature]*

7-21-86
L.L.

240.26

60

300.40 RD.

895.17

39