


9.82 A.

44

Correction

1988.1
1976.04
1996.26

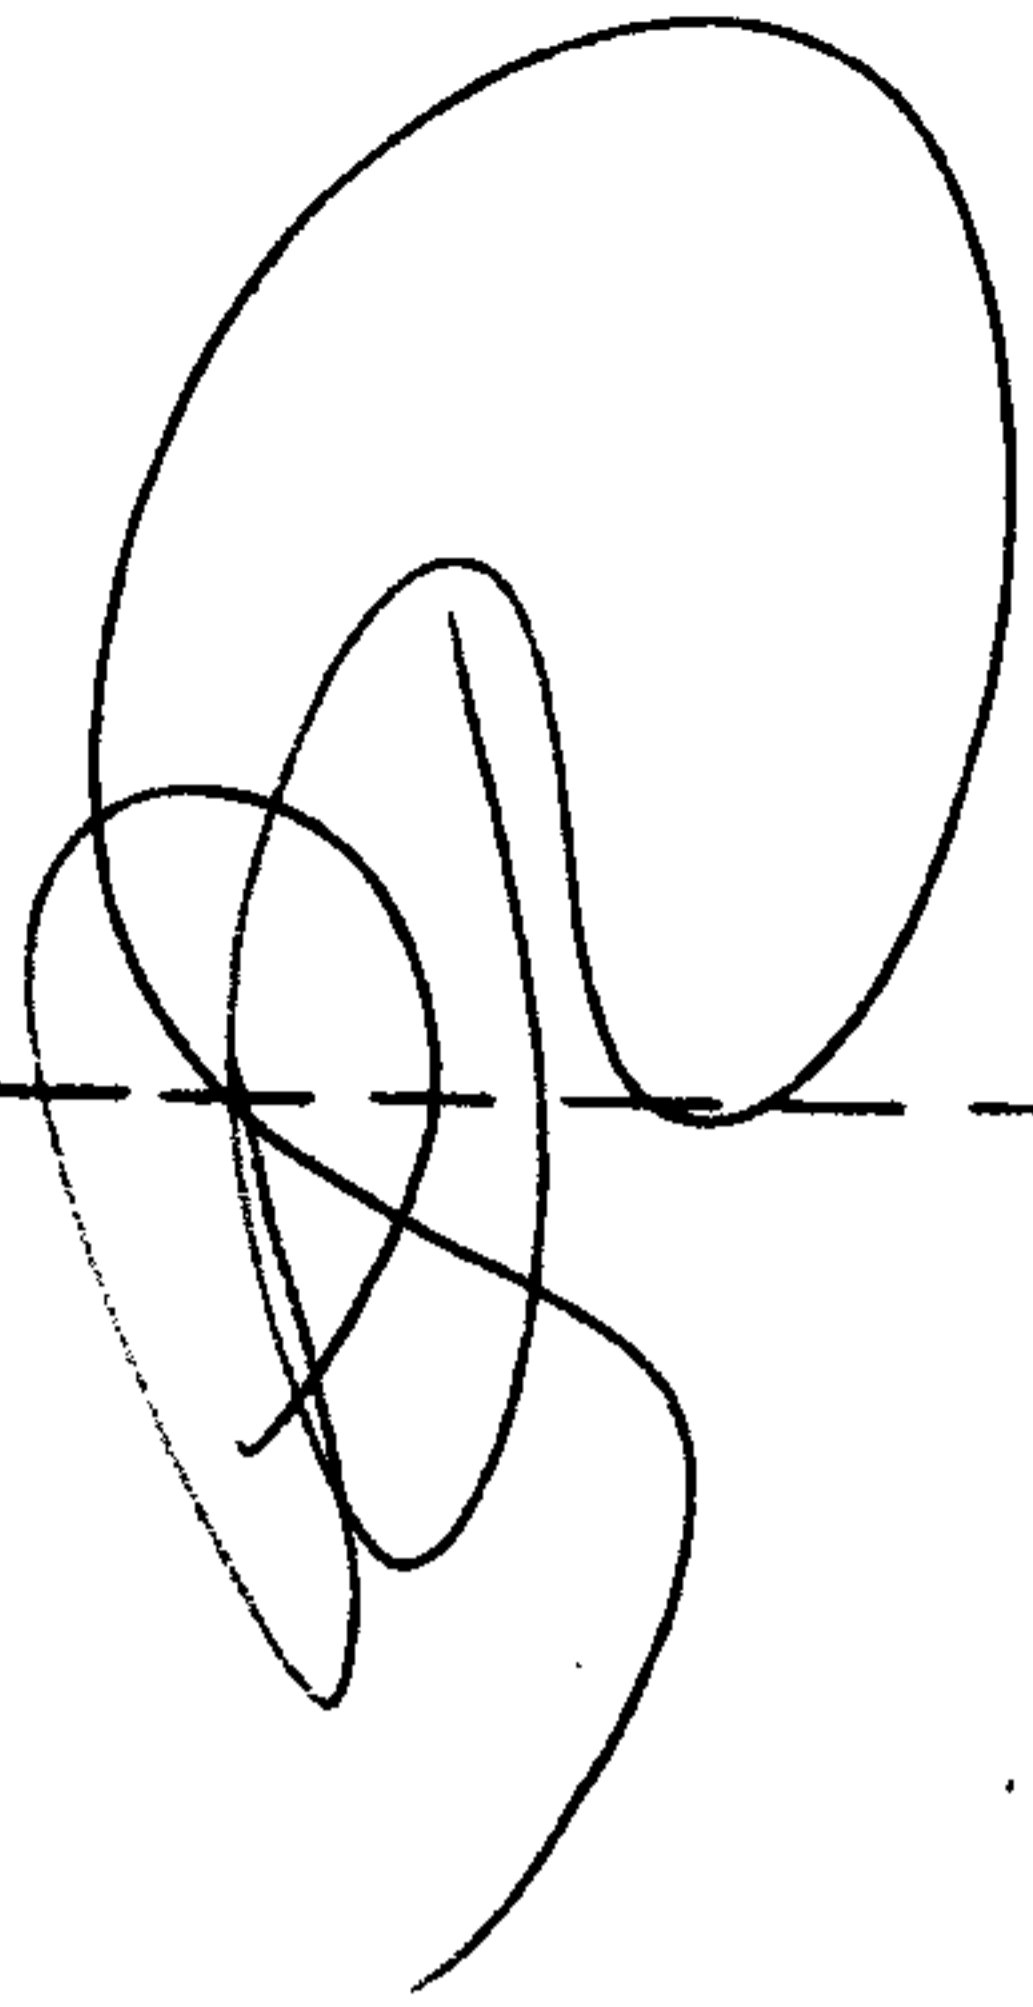

6252

APPROVED
LORAIN CO.
MAP DEPT.
DATE 8-17-72
6-57
BY *[Signature]*

~~Pt. 010~~ - 010
Pt. 14.53 A. 15.00 AC.

1622.28

Pt. -001
Pt. 6.67 A.

Pt. -002
12.98 AC

14.53
47
15.00 AC.

TURNPIKE

260

1250

80° 30' 60

10
-011
0.47 A.
326.30
251.70

70

?