

[Handwritten scribble]

101

-047
9.82 A.

44

0251

*Murphy
Pike*

6257
APPROVED
LORAIN CO.
MAP DEPT.
DATE 8-21-72
6-57
BY Lw Hall


1988.1
1976.04
1996.26

06-24-044-101-048

Pt. -010 16.53
Pt. ~~14.53~~ 15.00
520.90

Deleted

Pt 16.53 AC

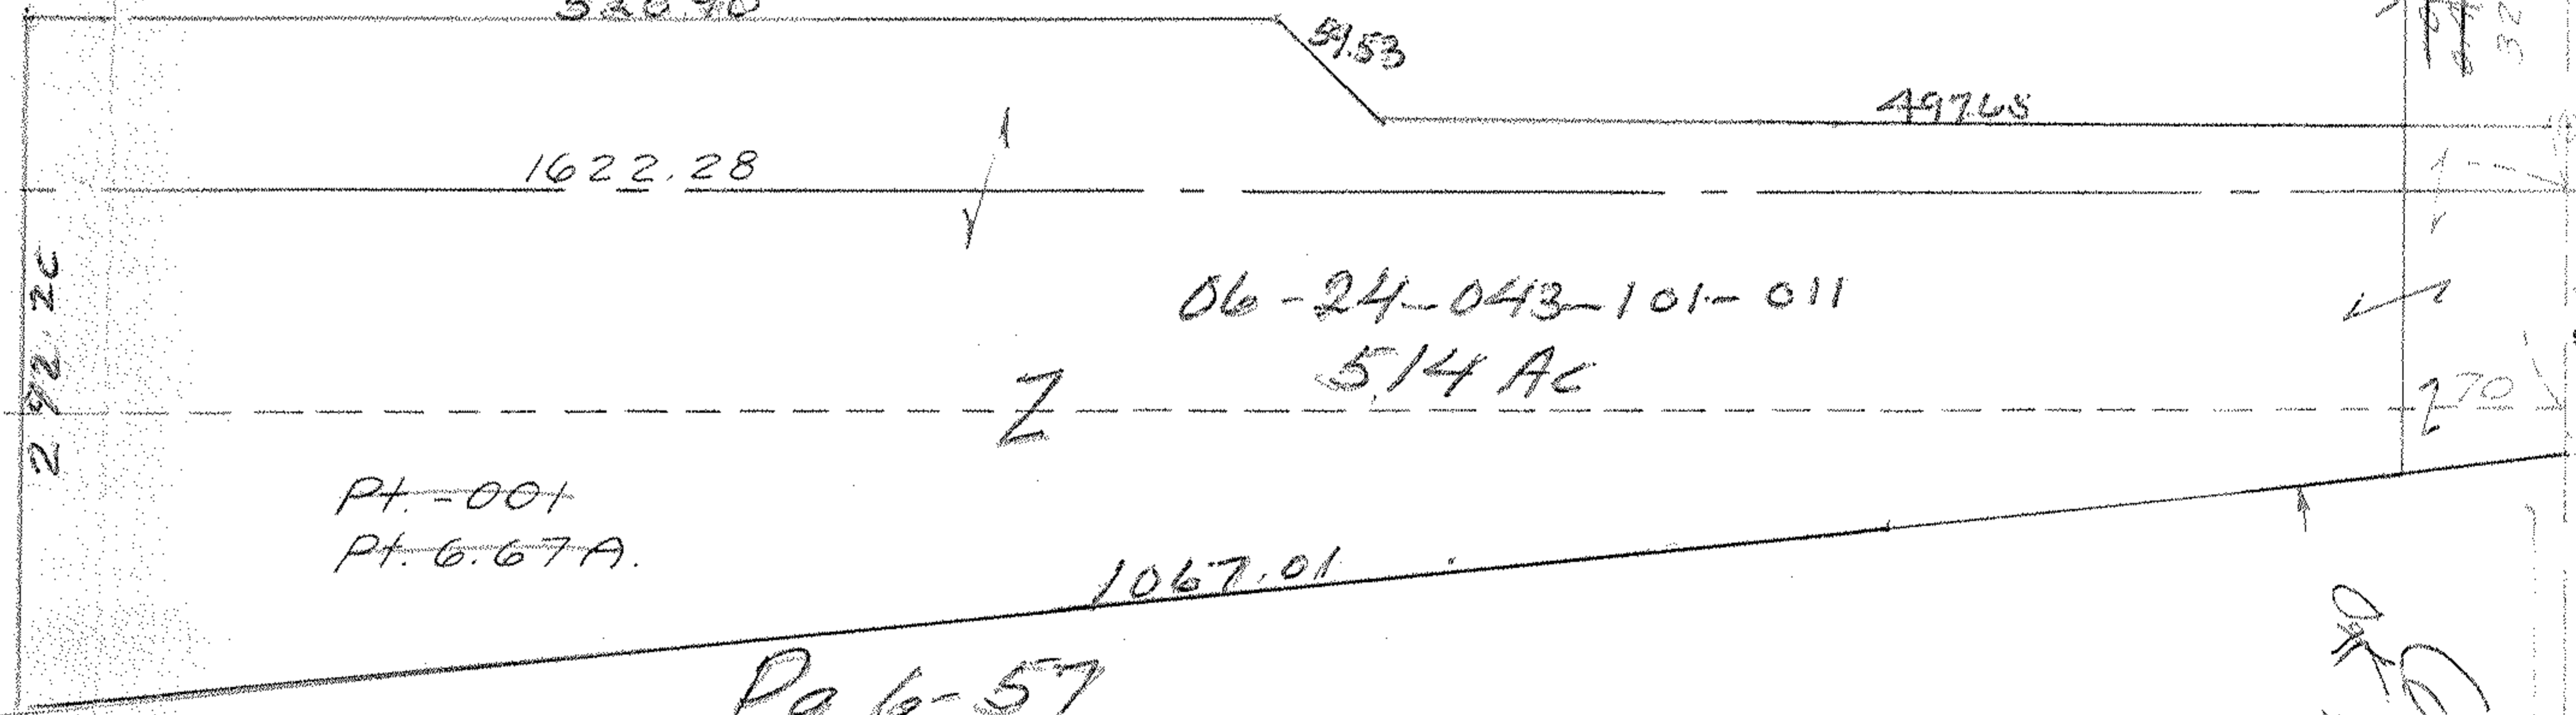

Pt 06-24-044-101-048 2008.32

Pg 6-57

Pt. -002
12.98 AC

TURNPIKE



OK 260
0257

