

See 7-0-014B
A150

7-00-014B

Pt. - 010

6259
OK

019
34.30
9x
9x

240.30
240.22
-012

009
834

6259

387.72




[Handwritten signature]

6259
APPROVED
LORAIN CO.
MAP DEPT.
DATE 8-22-72
67-00-014 B & C
BY L V Hall

014D

Pt. 019
Pt. 34.30

104

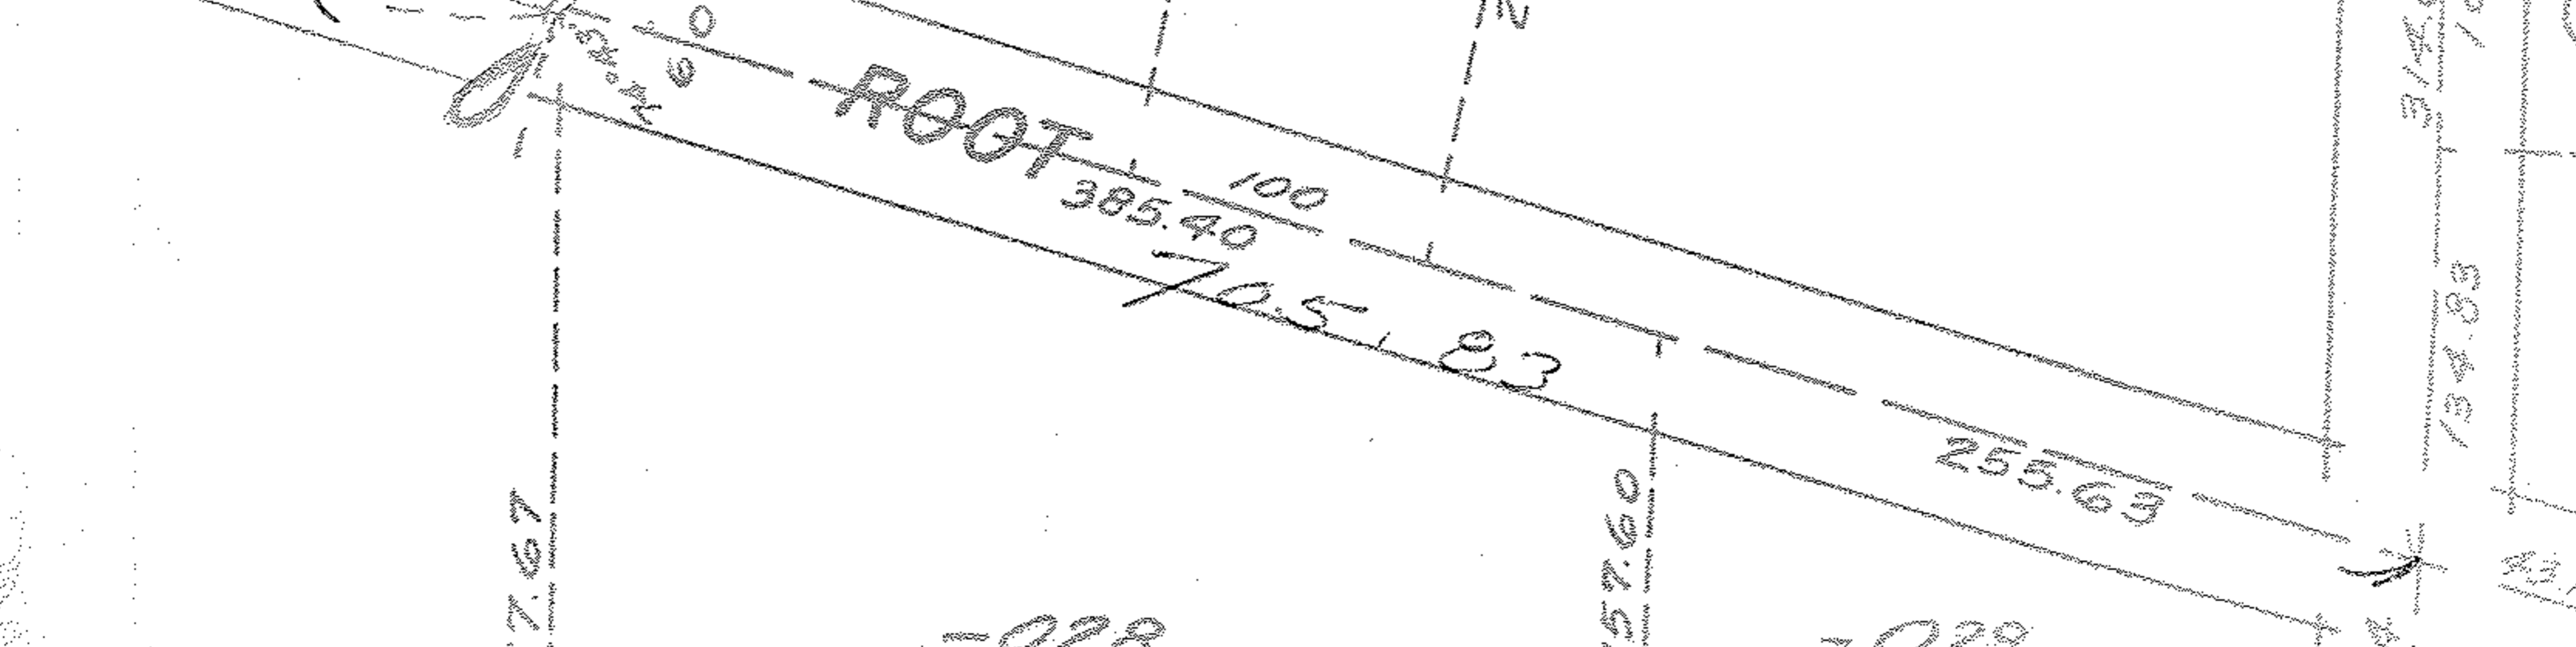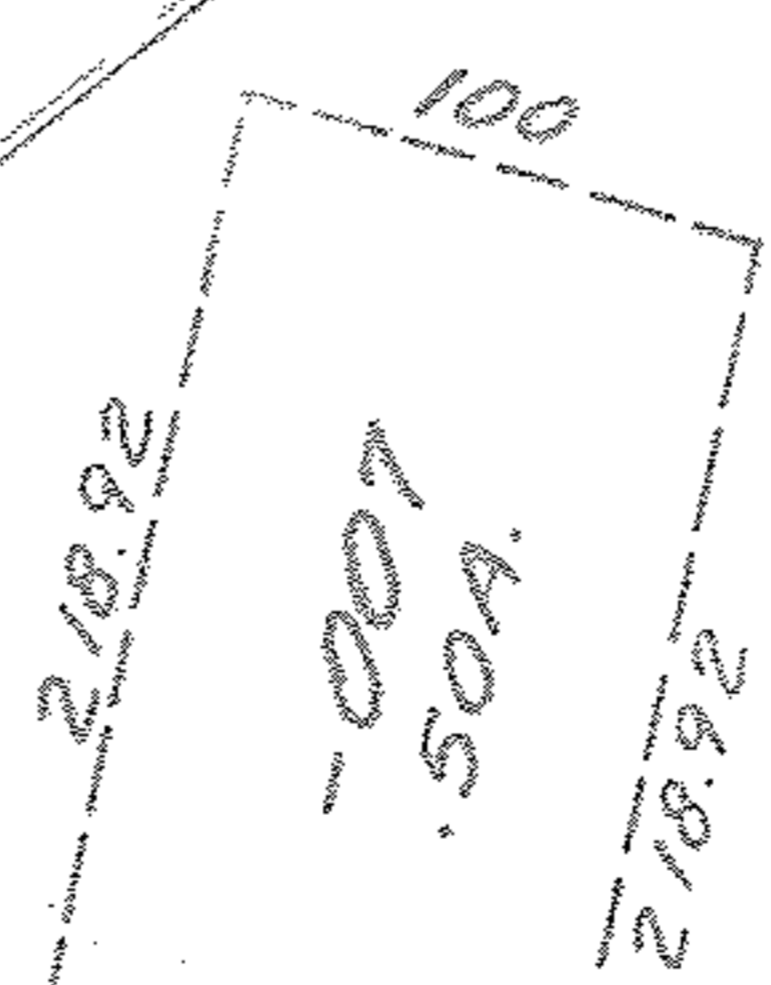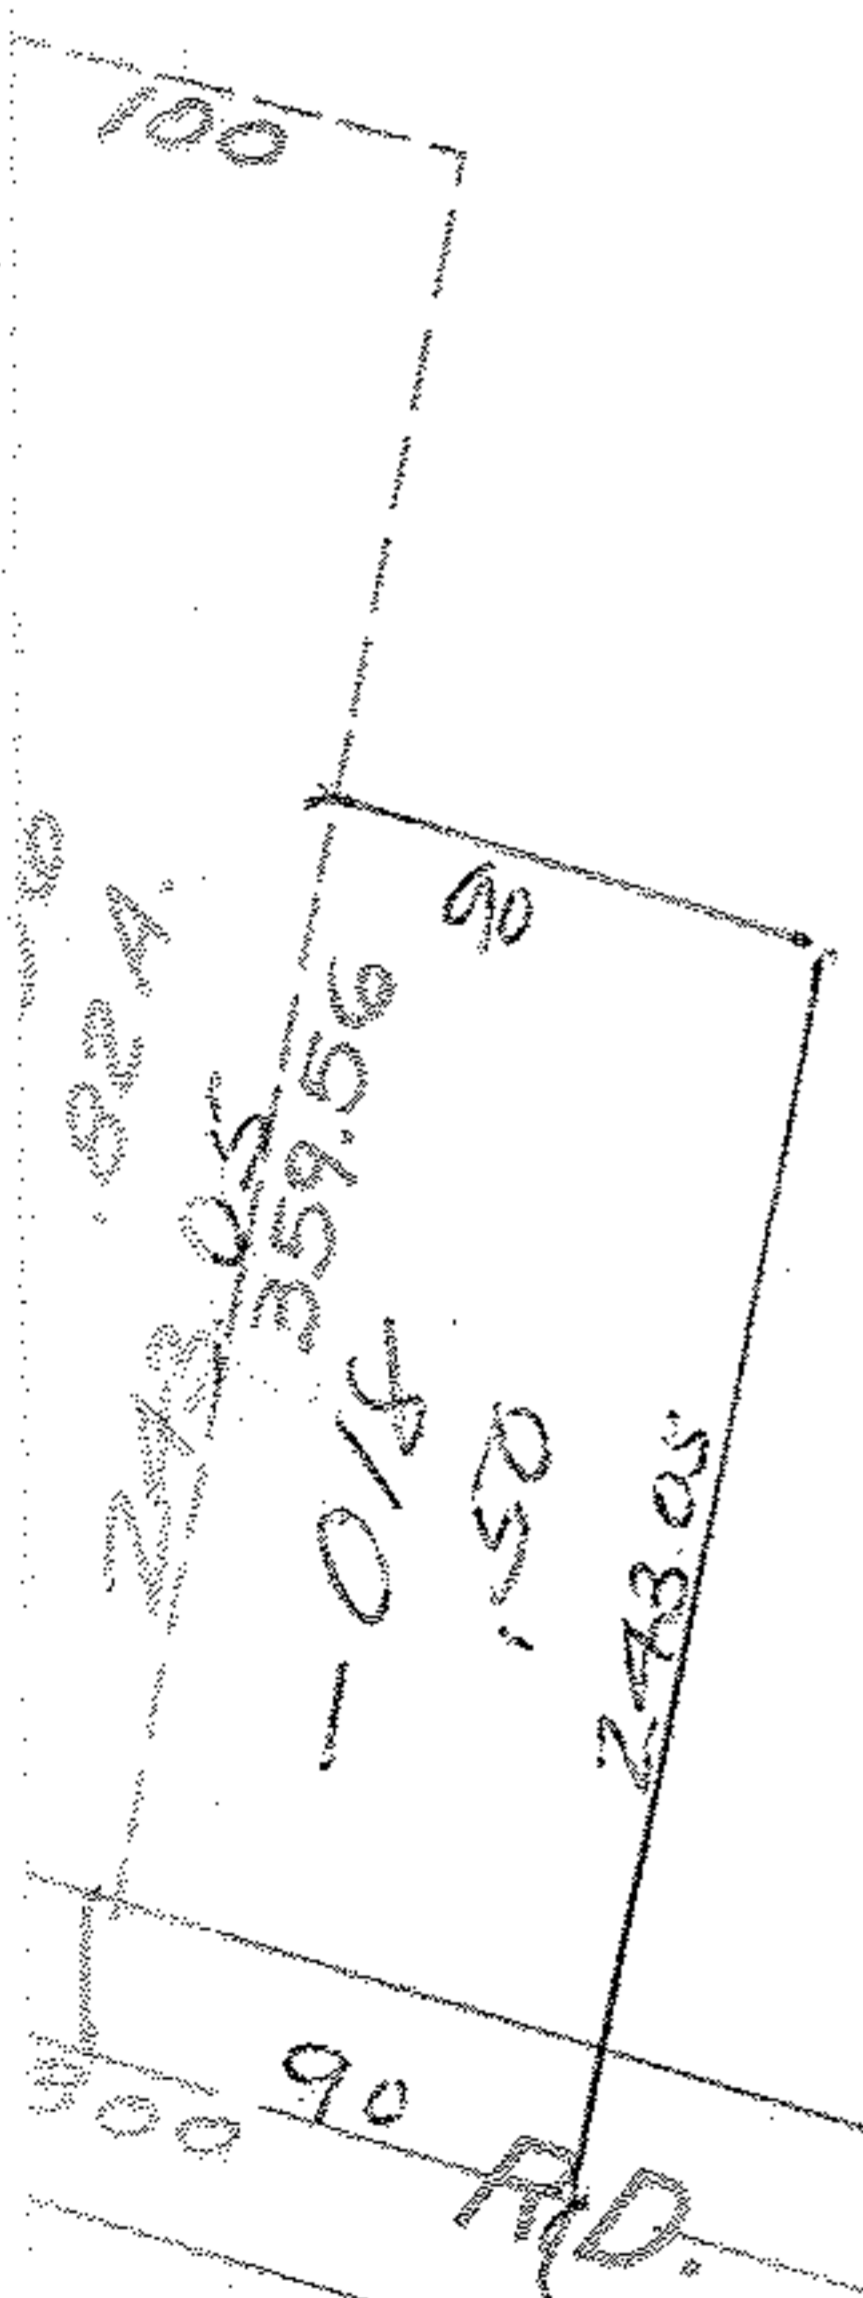

-028

-029

997.23
BUTHERNUT - RIDGE