
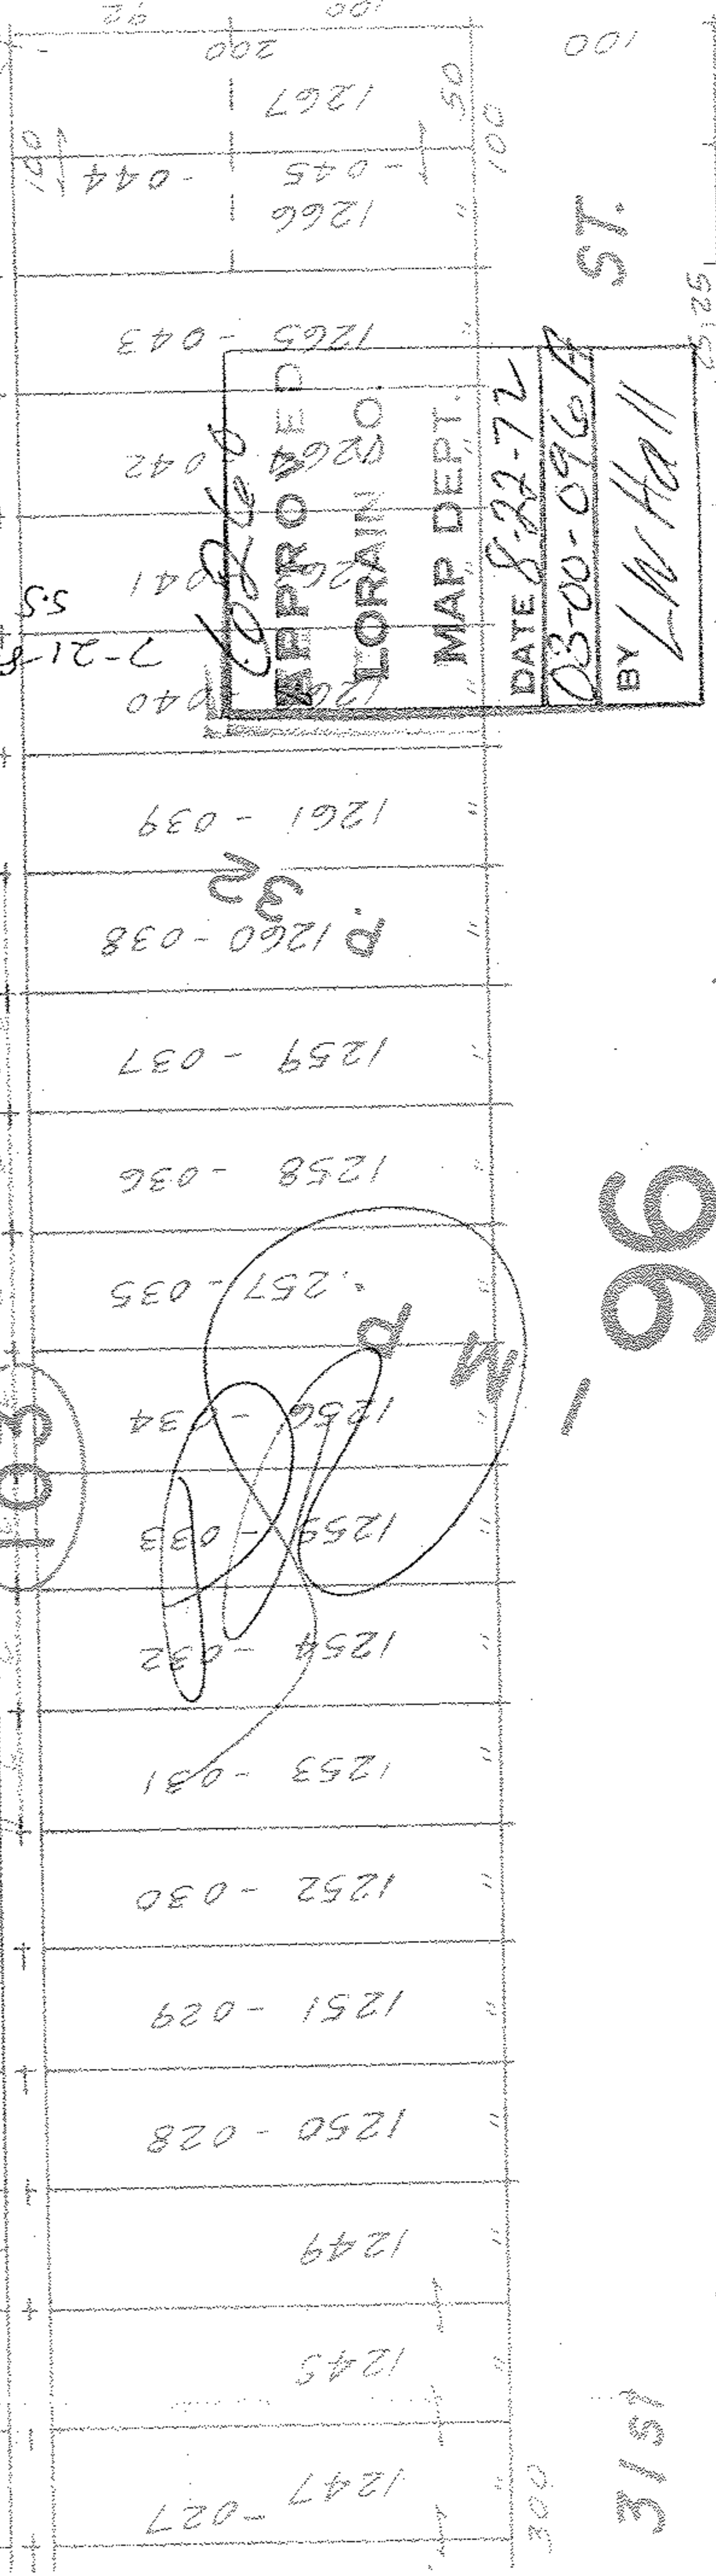
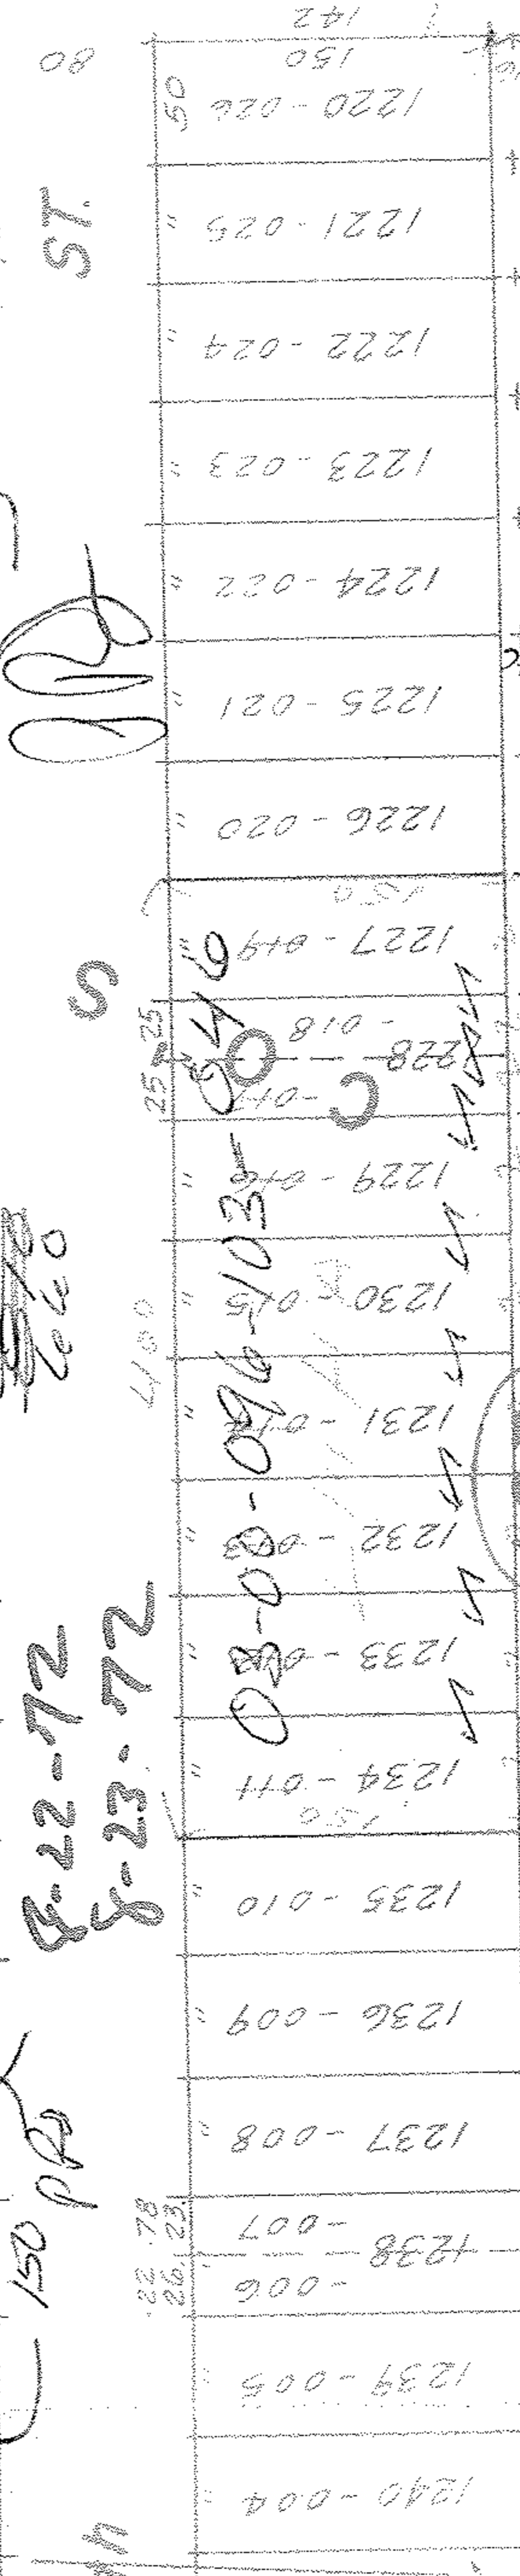


Send through

6260

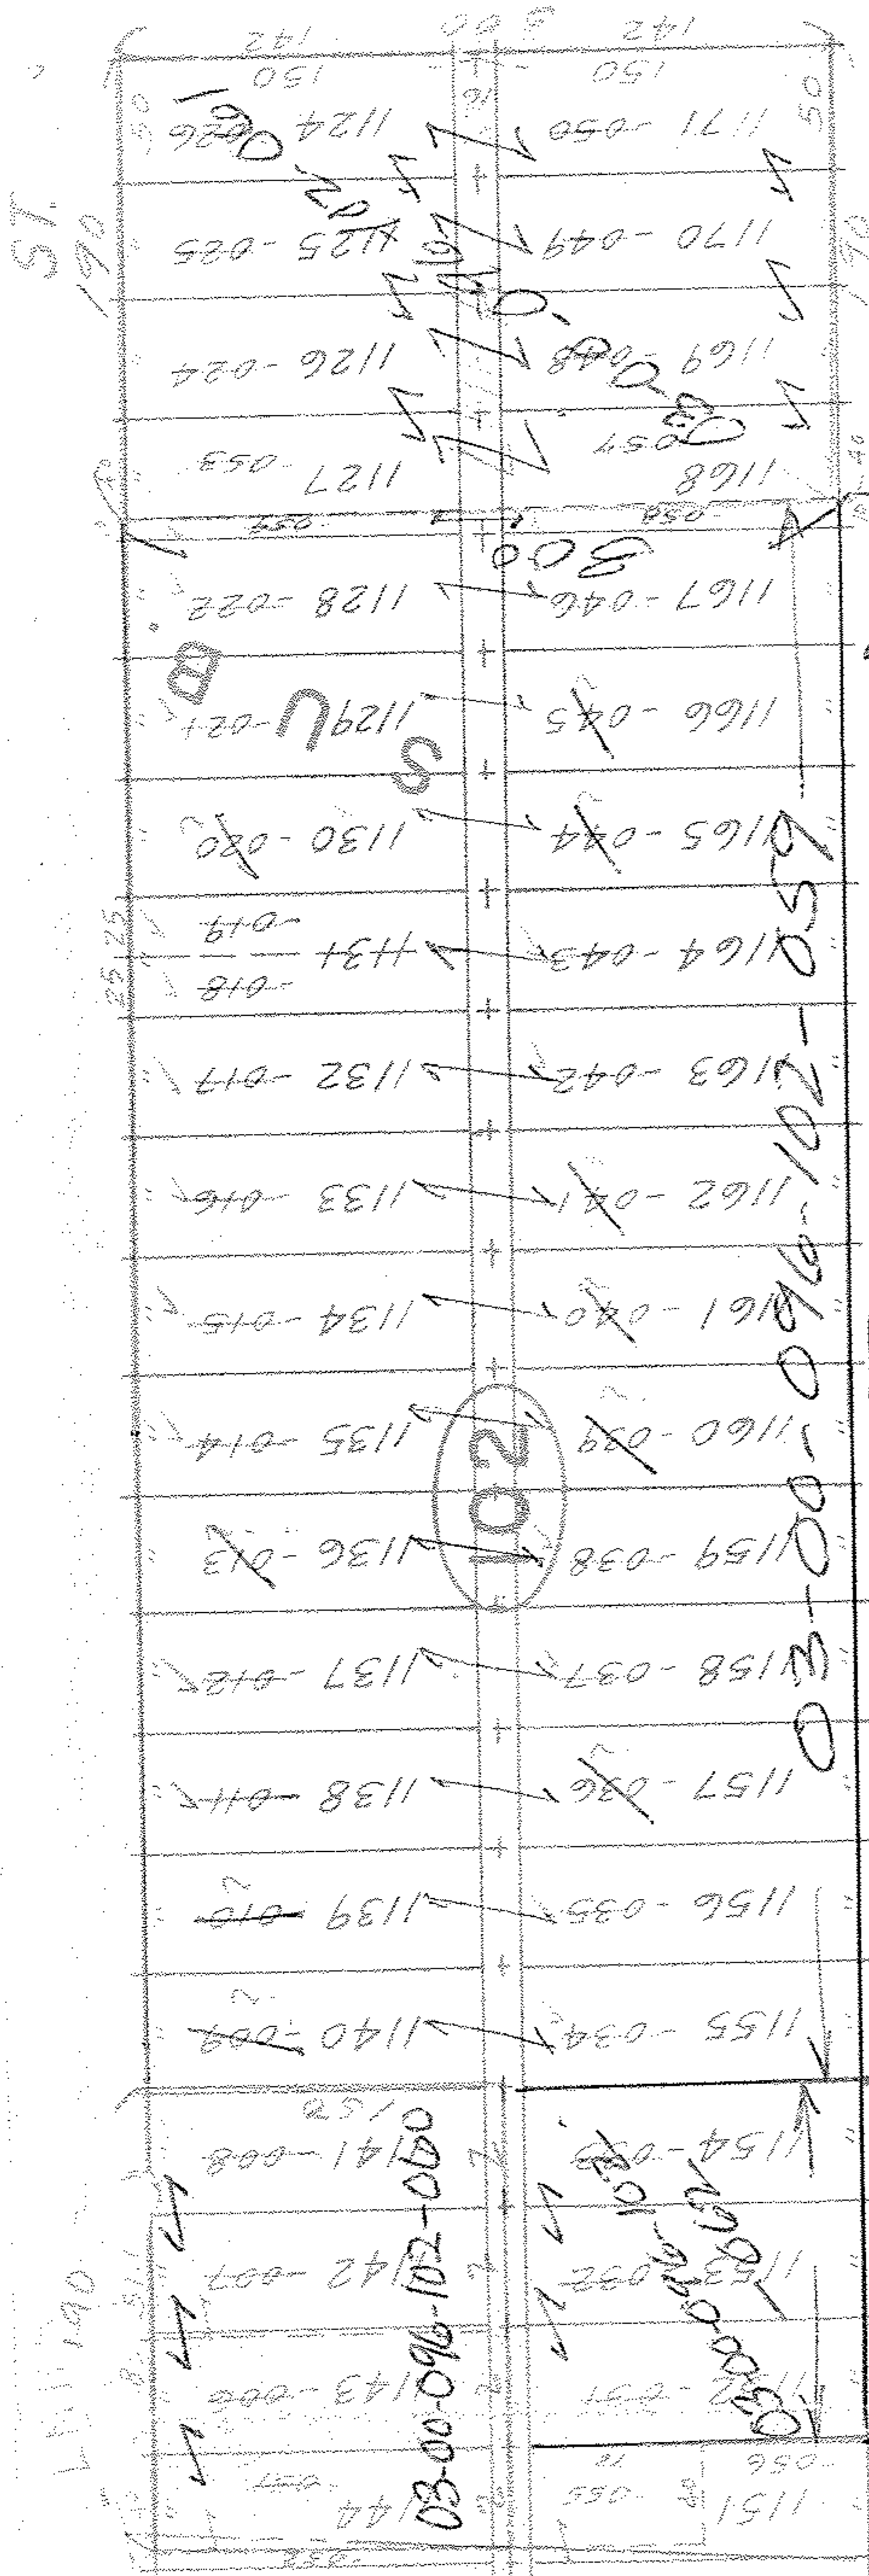

APPROVED
 LORAIN O
 MAP DEPT.
 DATE 8-22-72
 03-00-096A
 BY L W Hall

96

151E