
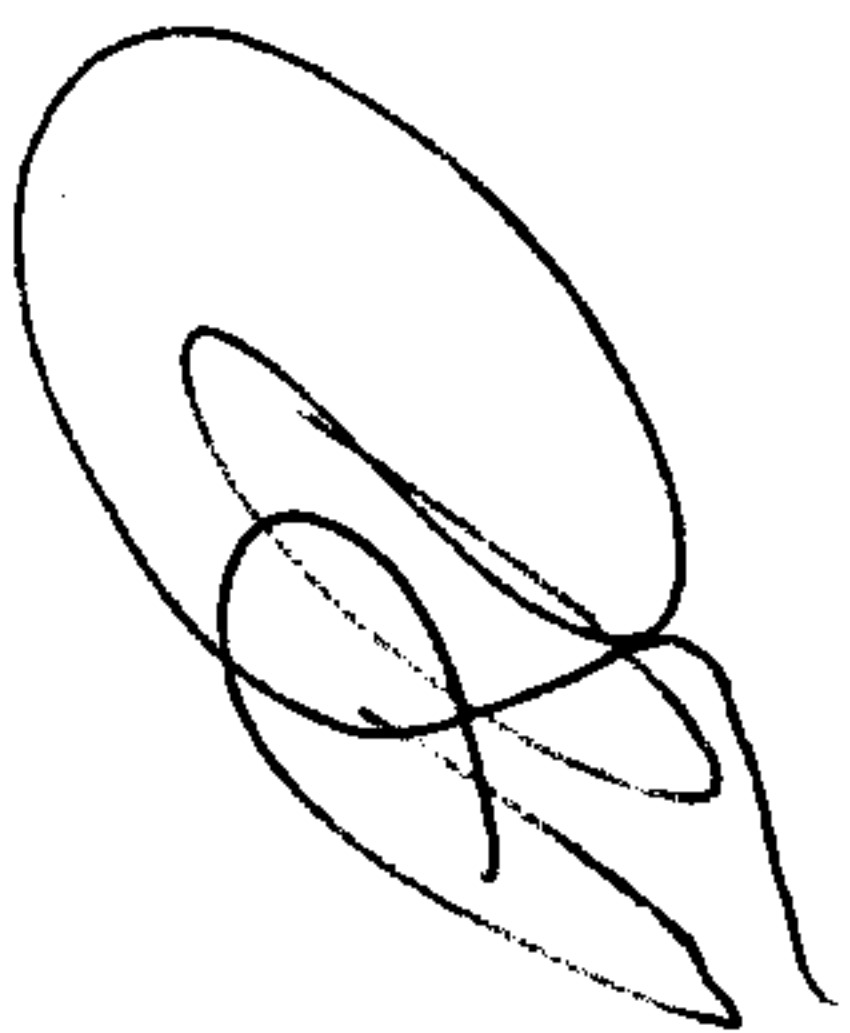


#6261

58

588.50
41.51
930.01

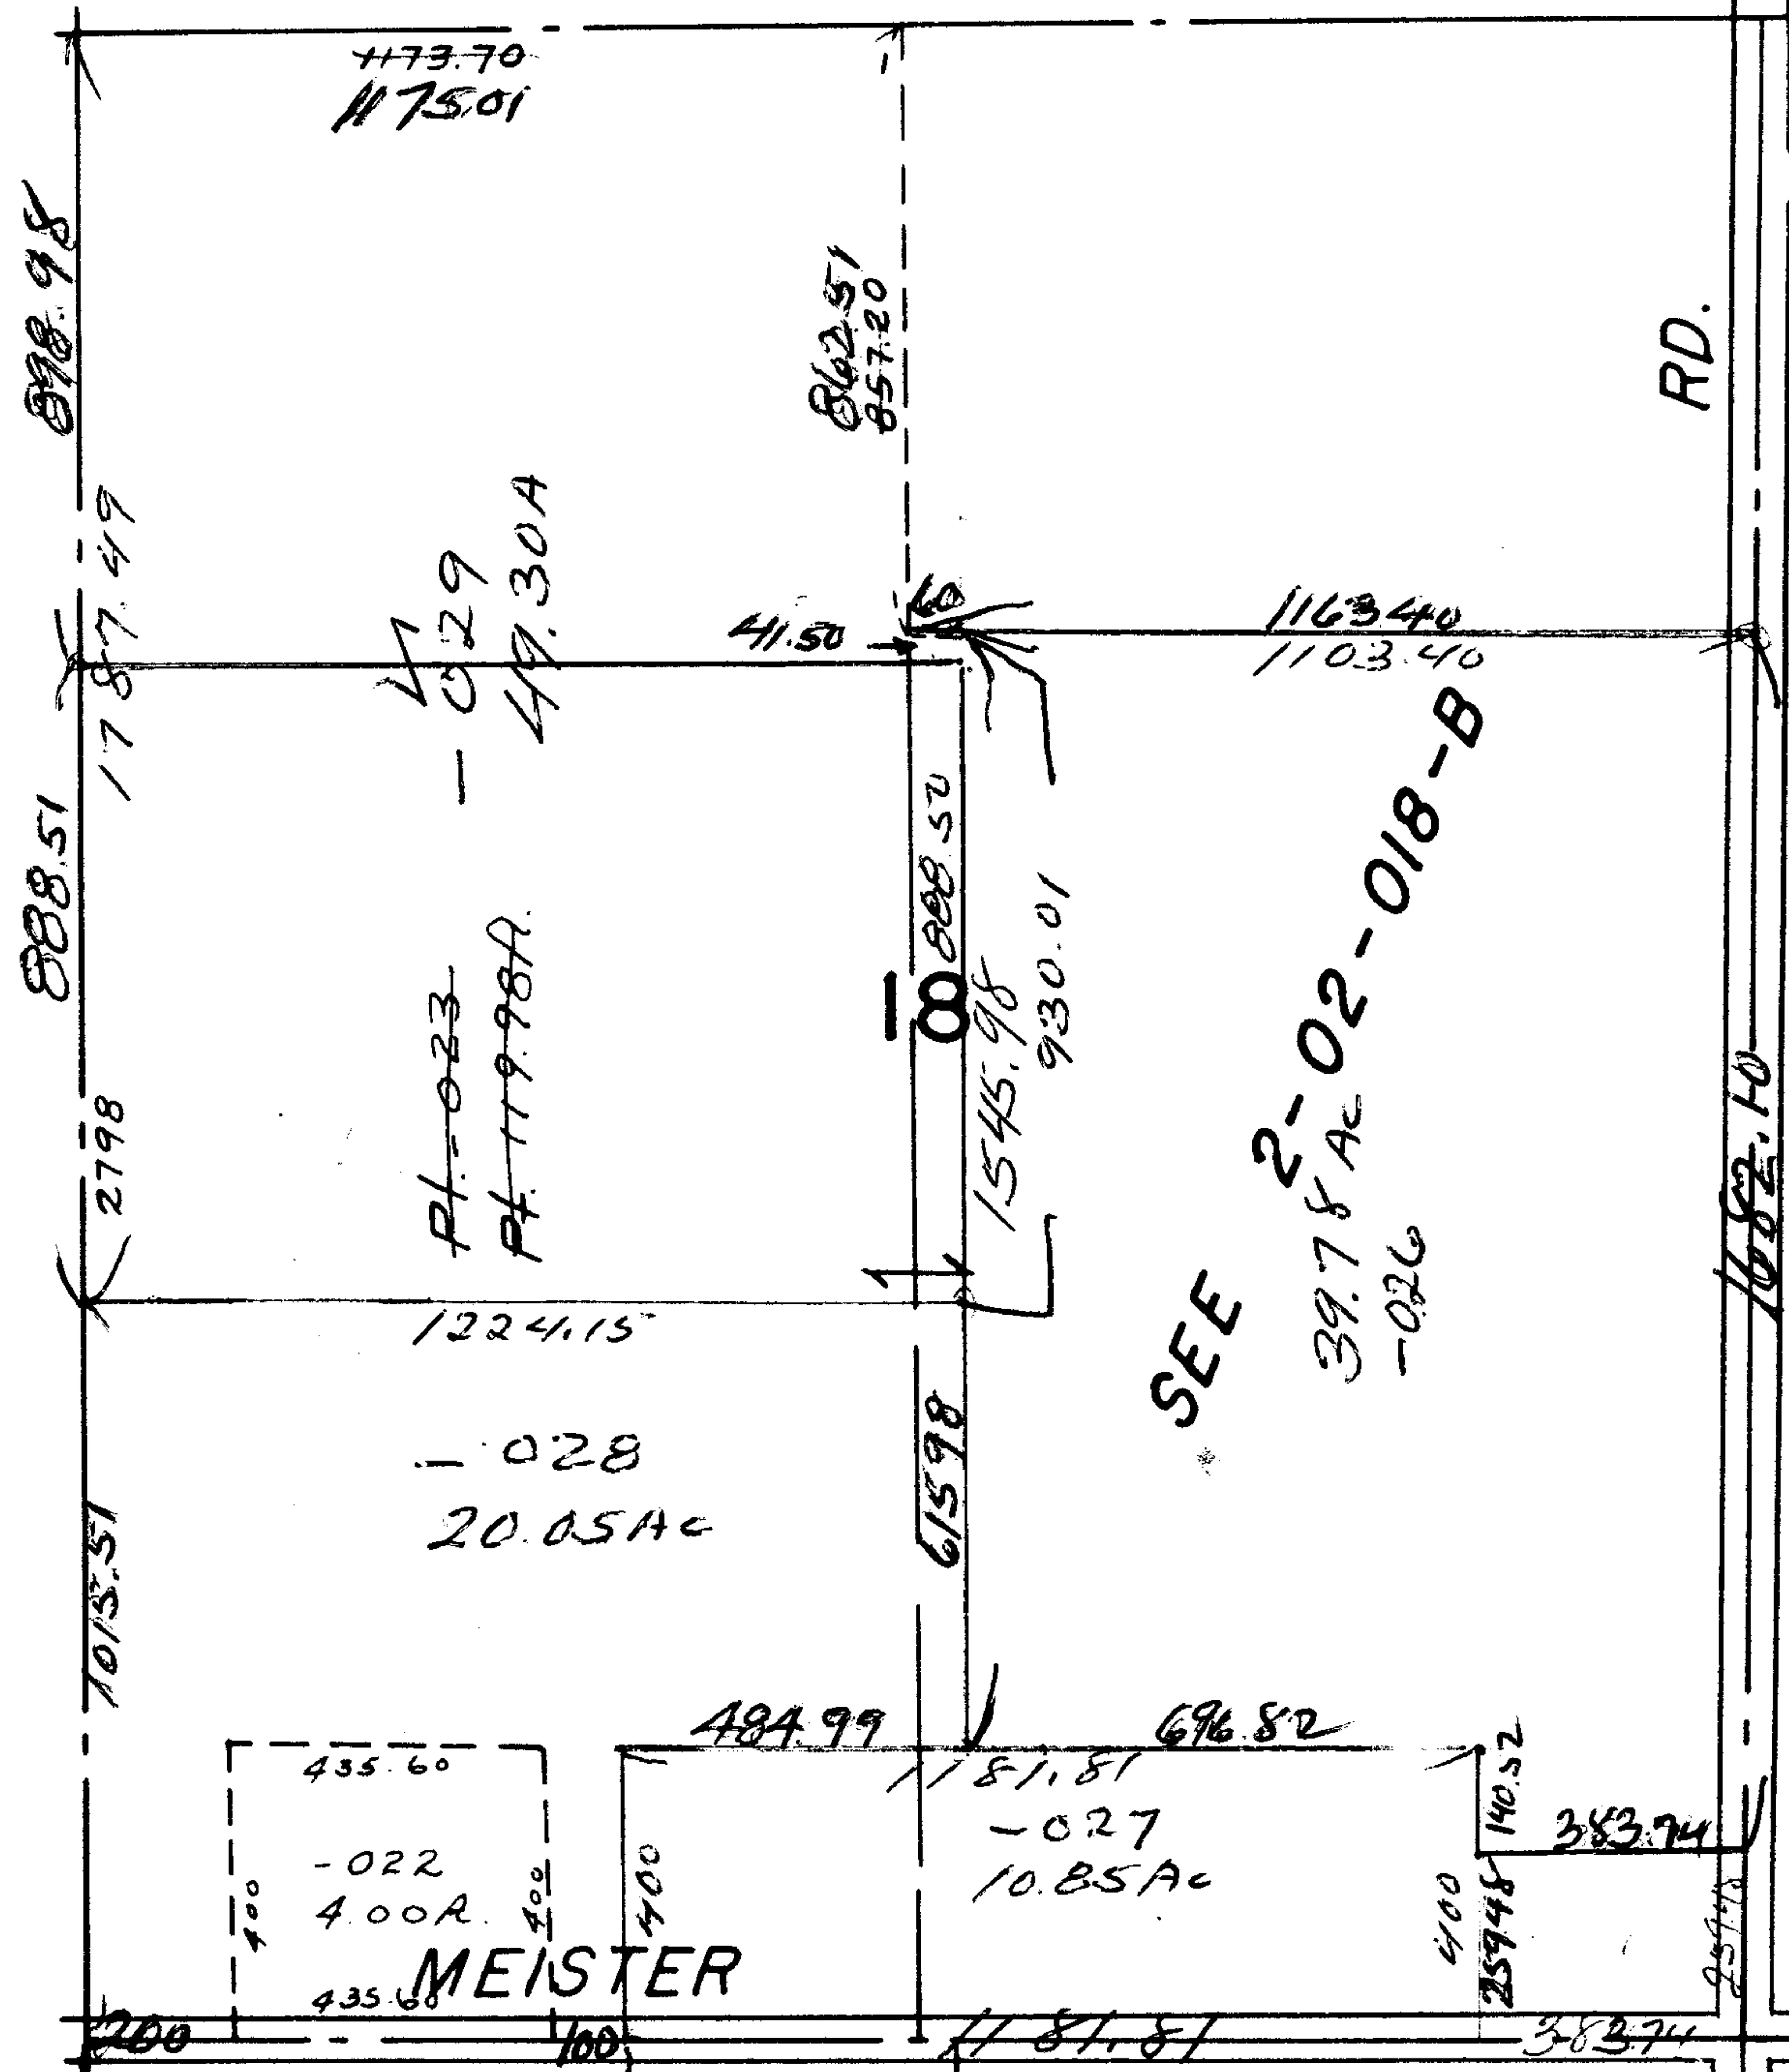

APPROVED
LORAIN CO.
MAP DEPT.
DATE 8-22-72
02-02-018 B-2G
BY LNH Hall

A.S.
7-21-86
S.S.

corrected
2G

3-A

-B