

6263

OK Burd
gms.

EE 3-00-097-B


1244	1245	1246	1247-027	1248	1149	1150	1151	1152	1153-047	1154-033	1155-034	1156-035	1157-036	1158-037	1159-038	1160-039	1161-040	1162-041	1163-042	1164-043	1165-044	1166-045	1167-046	1168-047	1169-048	1170-049	1171-050	
1243-001	1242-002	1241-003	1240-004	1239-005	1238-006	1237-008	1236-009	1235-010	1234-011	1233-012	1232-013	1231-014	1230-015	1229-016	1228-017	1227-018	1226-019	1225-020	1224-021	1223-022	1222-023	1221-024	1220-025	1219-026	1218-027	1217-028	1216-029	1215-030
1250-028	1251-029	1252-030	1253-031	1254-032	1255-033	1256-034	1257-035	1258-036	1259-037	1260-038	1261-039	1262-040	1263-041	1264-042	1265-043	1266-044	1267-045	1268-046	1269-047	1270-048	1271-049	1272-050	1273-051	1274-052	1275-053	1276-054	1277-055	1278-056

Vacated ORD# 140-72
7-3-72 30th
03-00-096-103-047

Vacated - 9-7-71
103
ORD# 146-71

Vacated ORD# 139-72
7-3-72 03-00-096-103-048
97 31st
03-00-096-104-050

Board of Education

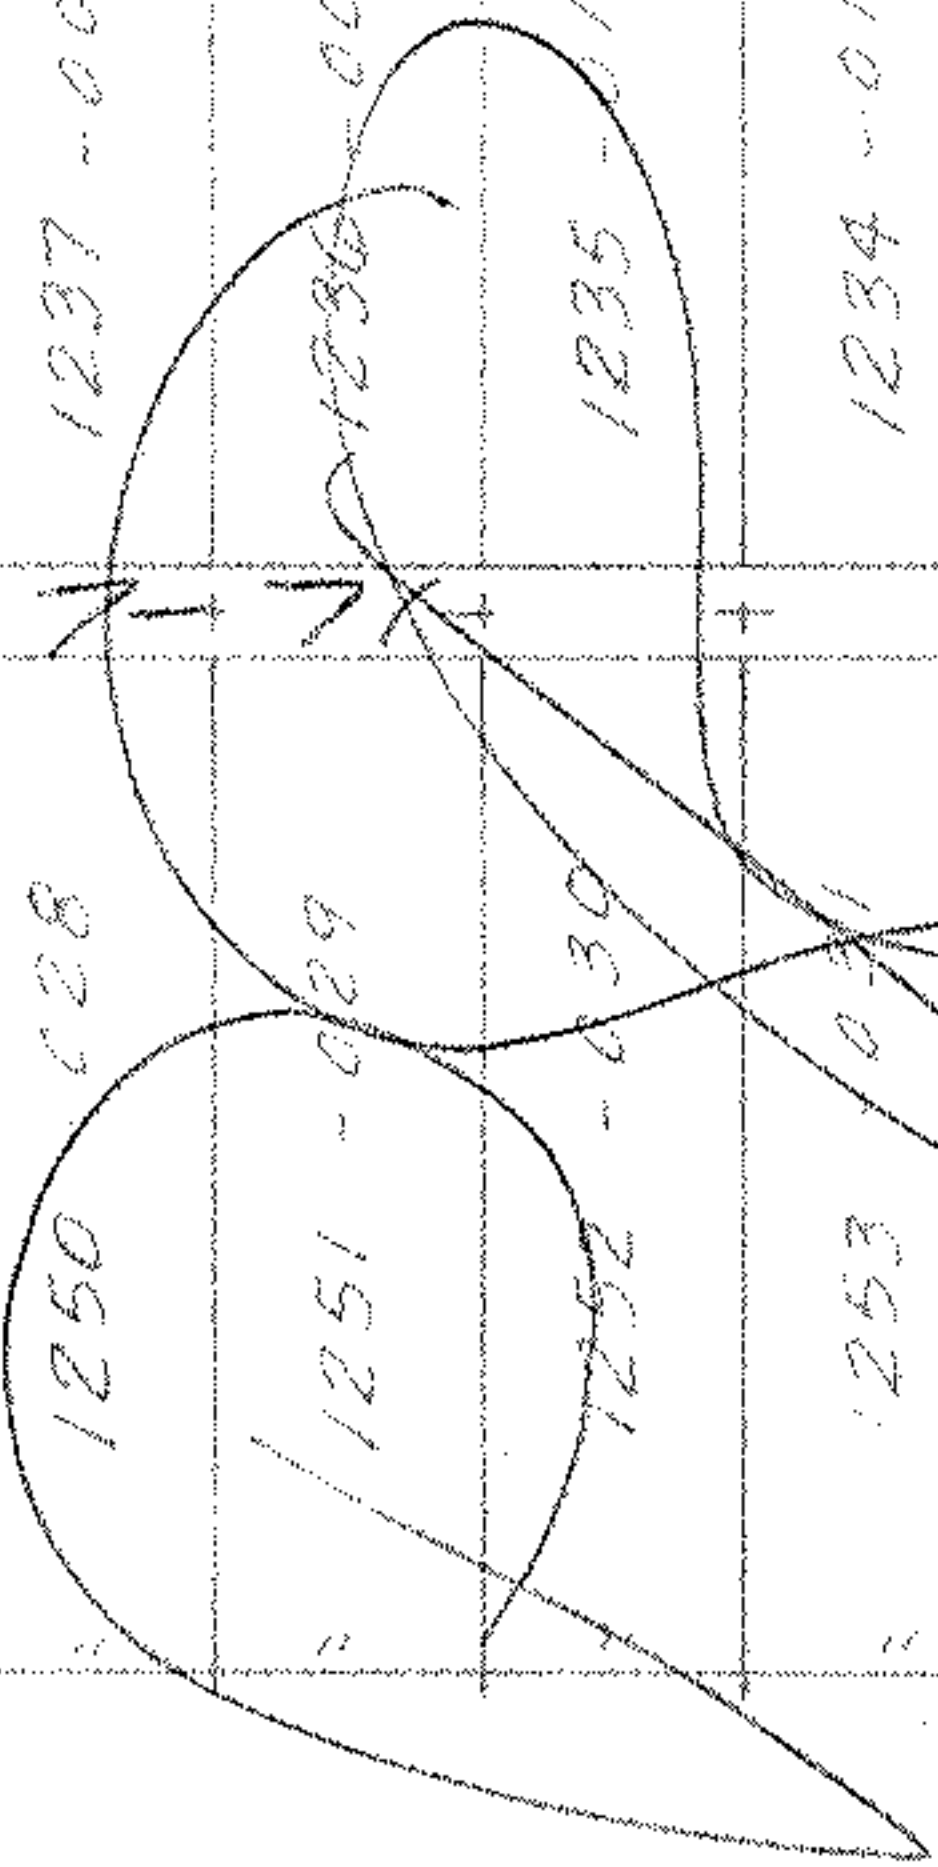

OK 96

1 M P

C O S

#6263 ST.

6263
APPROVED
LORAIN CO.
MAP DEPT.
DATE 8-23-74
03-00-096-A
W Hall

ST.