

6269

OK



- 034
9.60A.

Note: This Average Corrected
by Cent


160 X 243

473560 = .89 Ac

415-
134
-56
78

6269
APPROVED
LORAIN CO.
MAP DEPT.
DATE 8-28-72
4-00-0194
BY L.W. Hall

7-21-84
h.l.

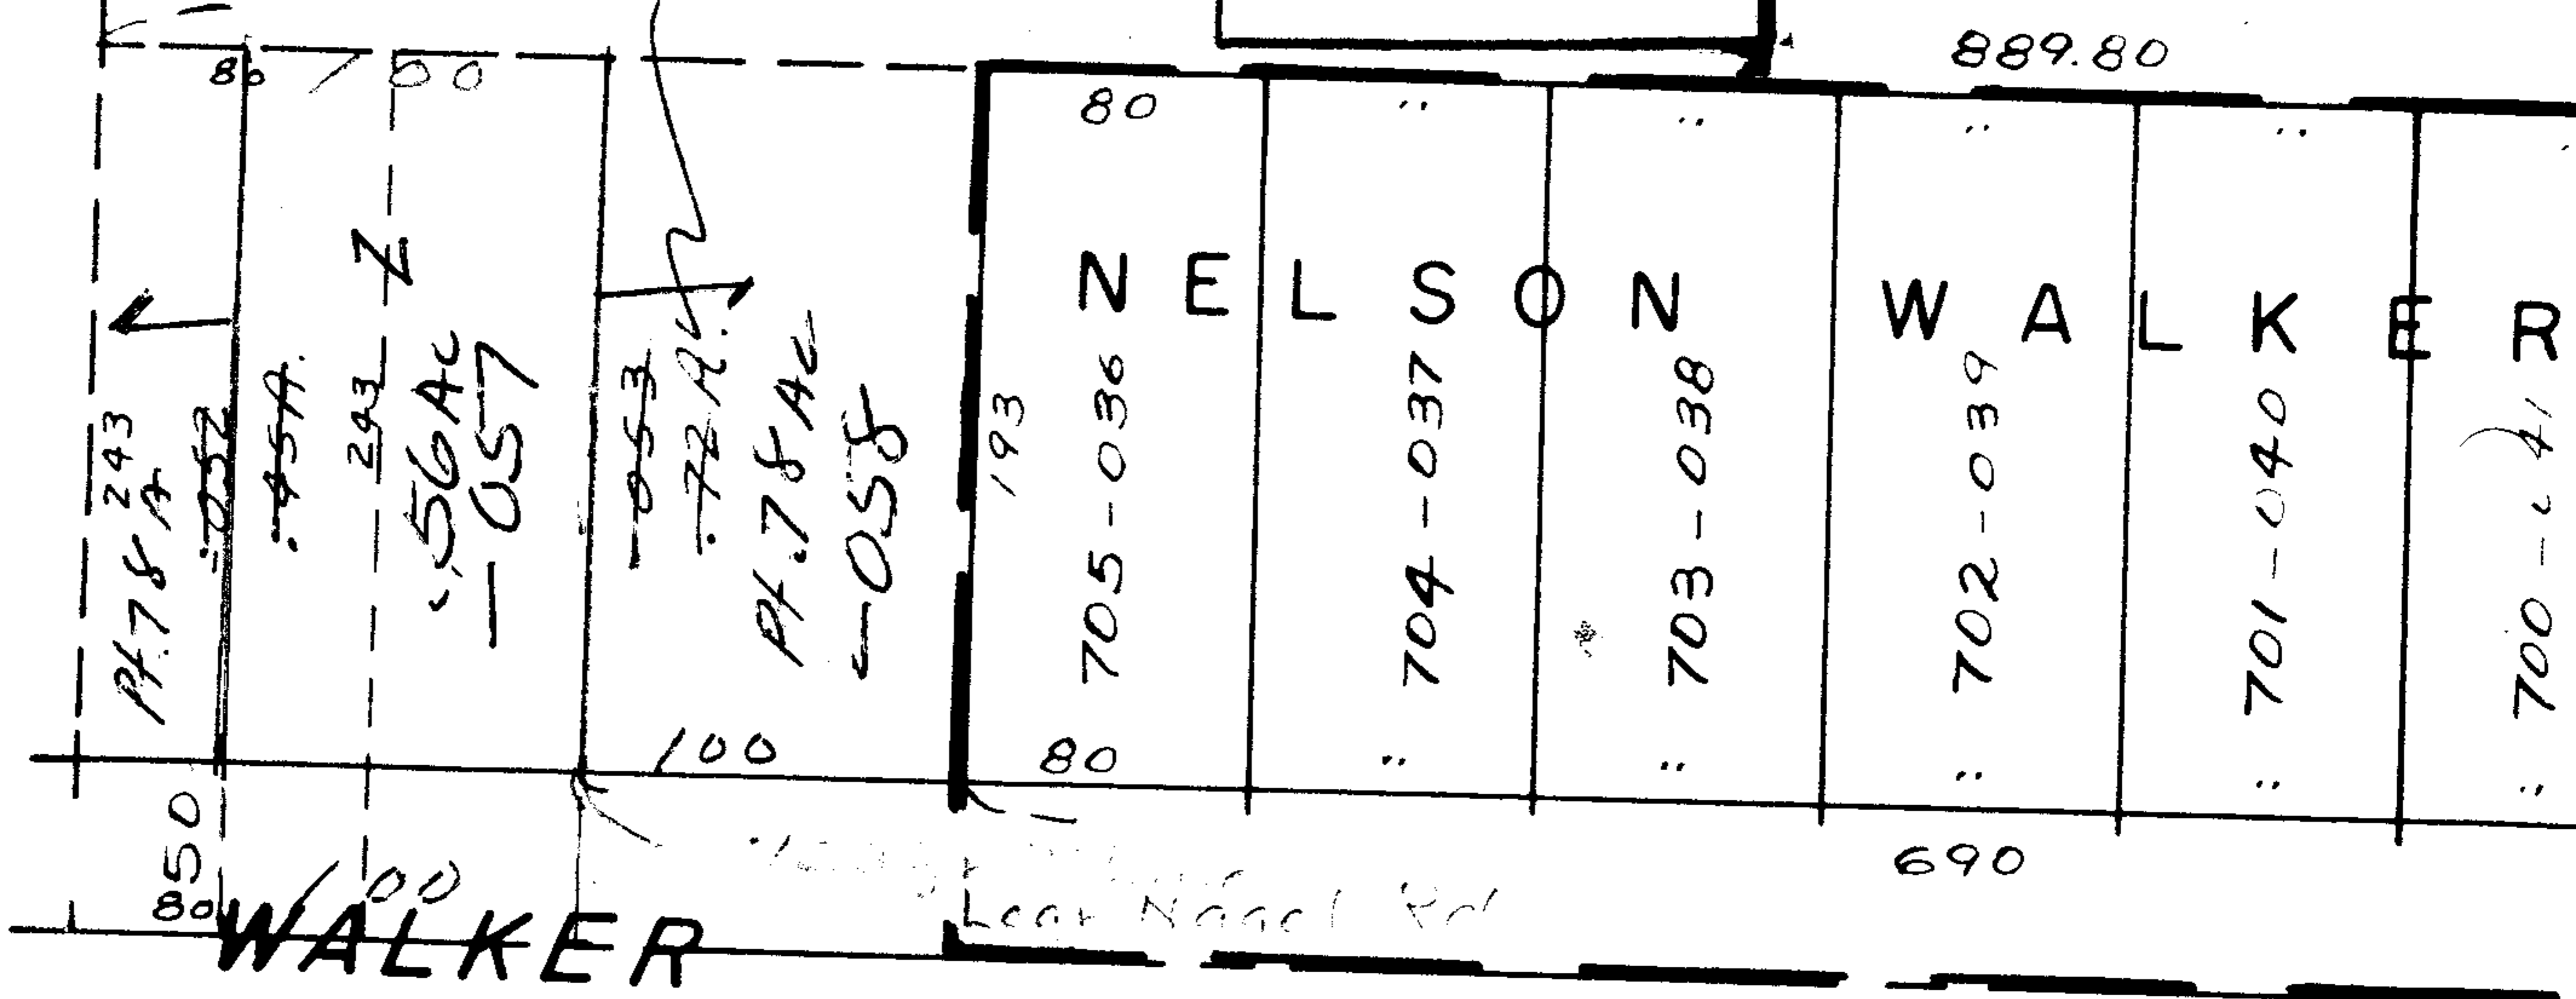

889.80

SEE 4-C

199
x 100

19300 = .414 Ac
473560

243
x 80

19440
473560

750 690
690 40

60 650

4-00-0194

LAKE VILLAGE

E 1/2

100'