


6274 OK



-040  
12.93A

See F 0070  
7-00-008

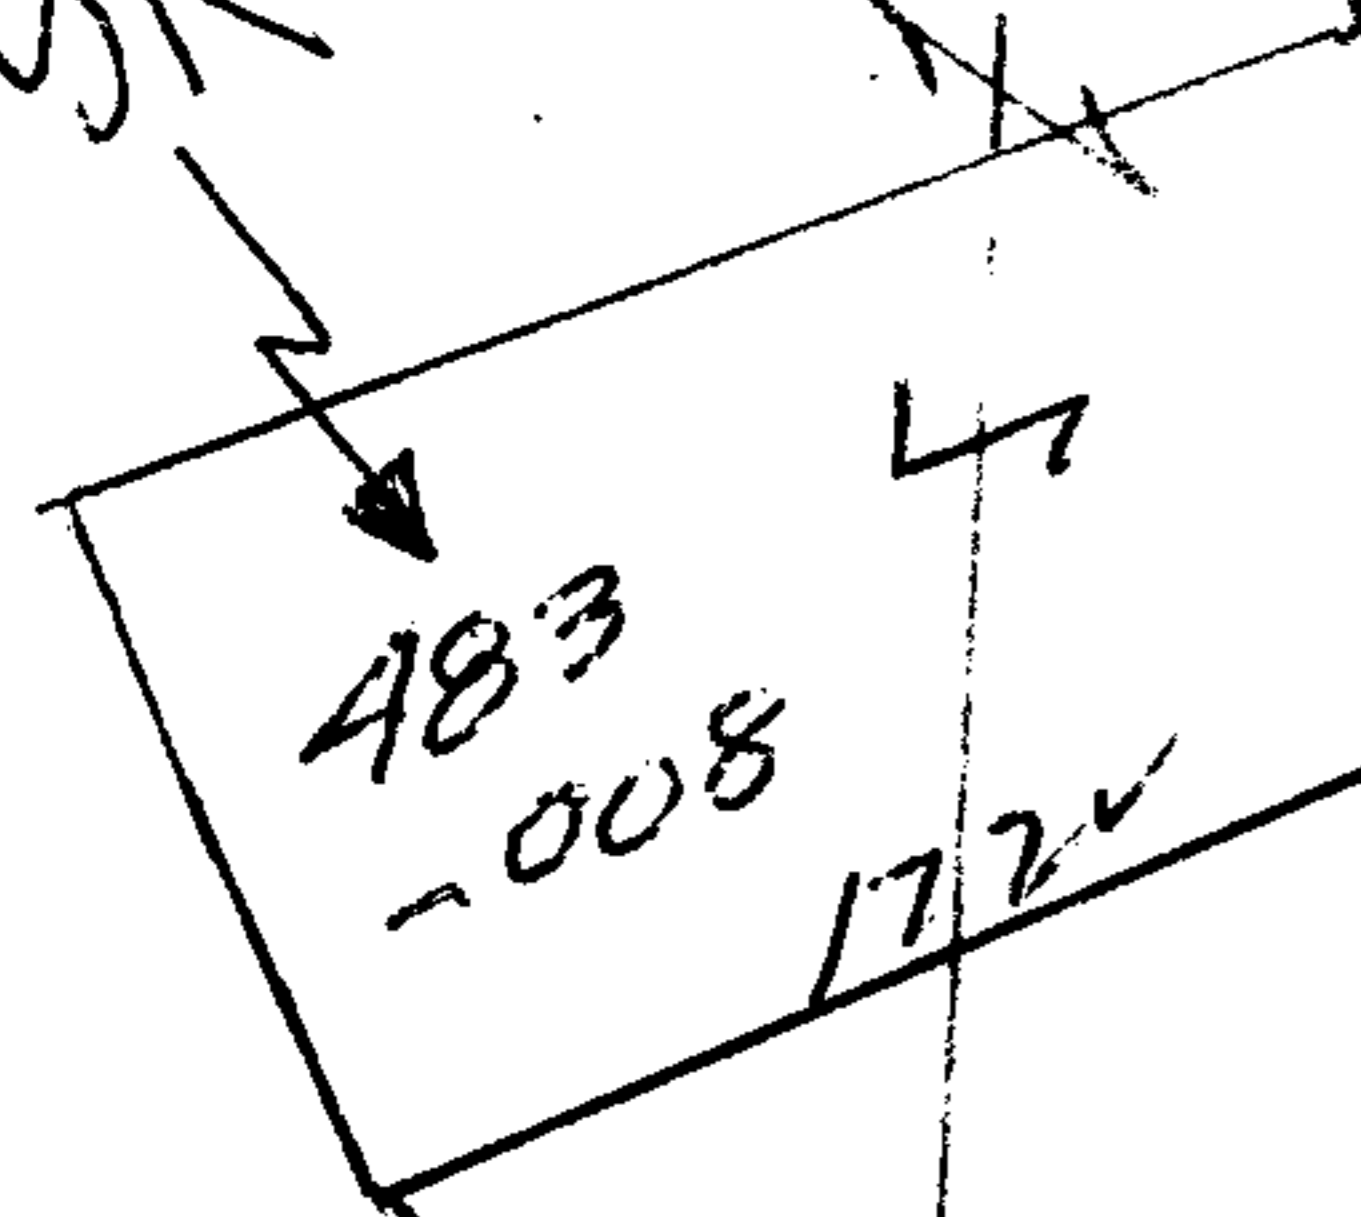

6274  
APPROVED  
LORAIN CO.  
MAP DEPT.  
DATE 8-28-72  
07-00-005A & 006C  
BY L. W. Hall

MILLS

019  
CREEK  
LN.

248AC

361.01

95.31

186.60

BLOCK "G" 098  
07-00-006-101-099

~~092~~  
545A 4159A

329.15

07-00-006-101-099  
PT 2.11 AC

SEE 7-00-005-A  
See Also ↑

RIDGEVILLE

SCALE: 1" = 100'

1964  
0-006-C