


6276 OK



SOUTH AMHERST

PYLE

1334.99

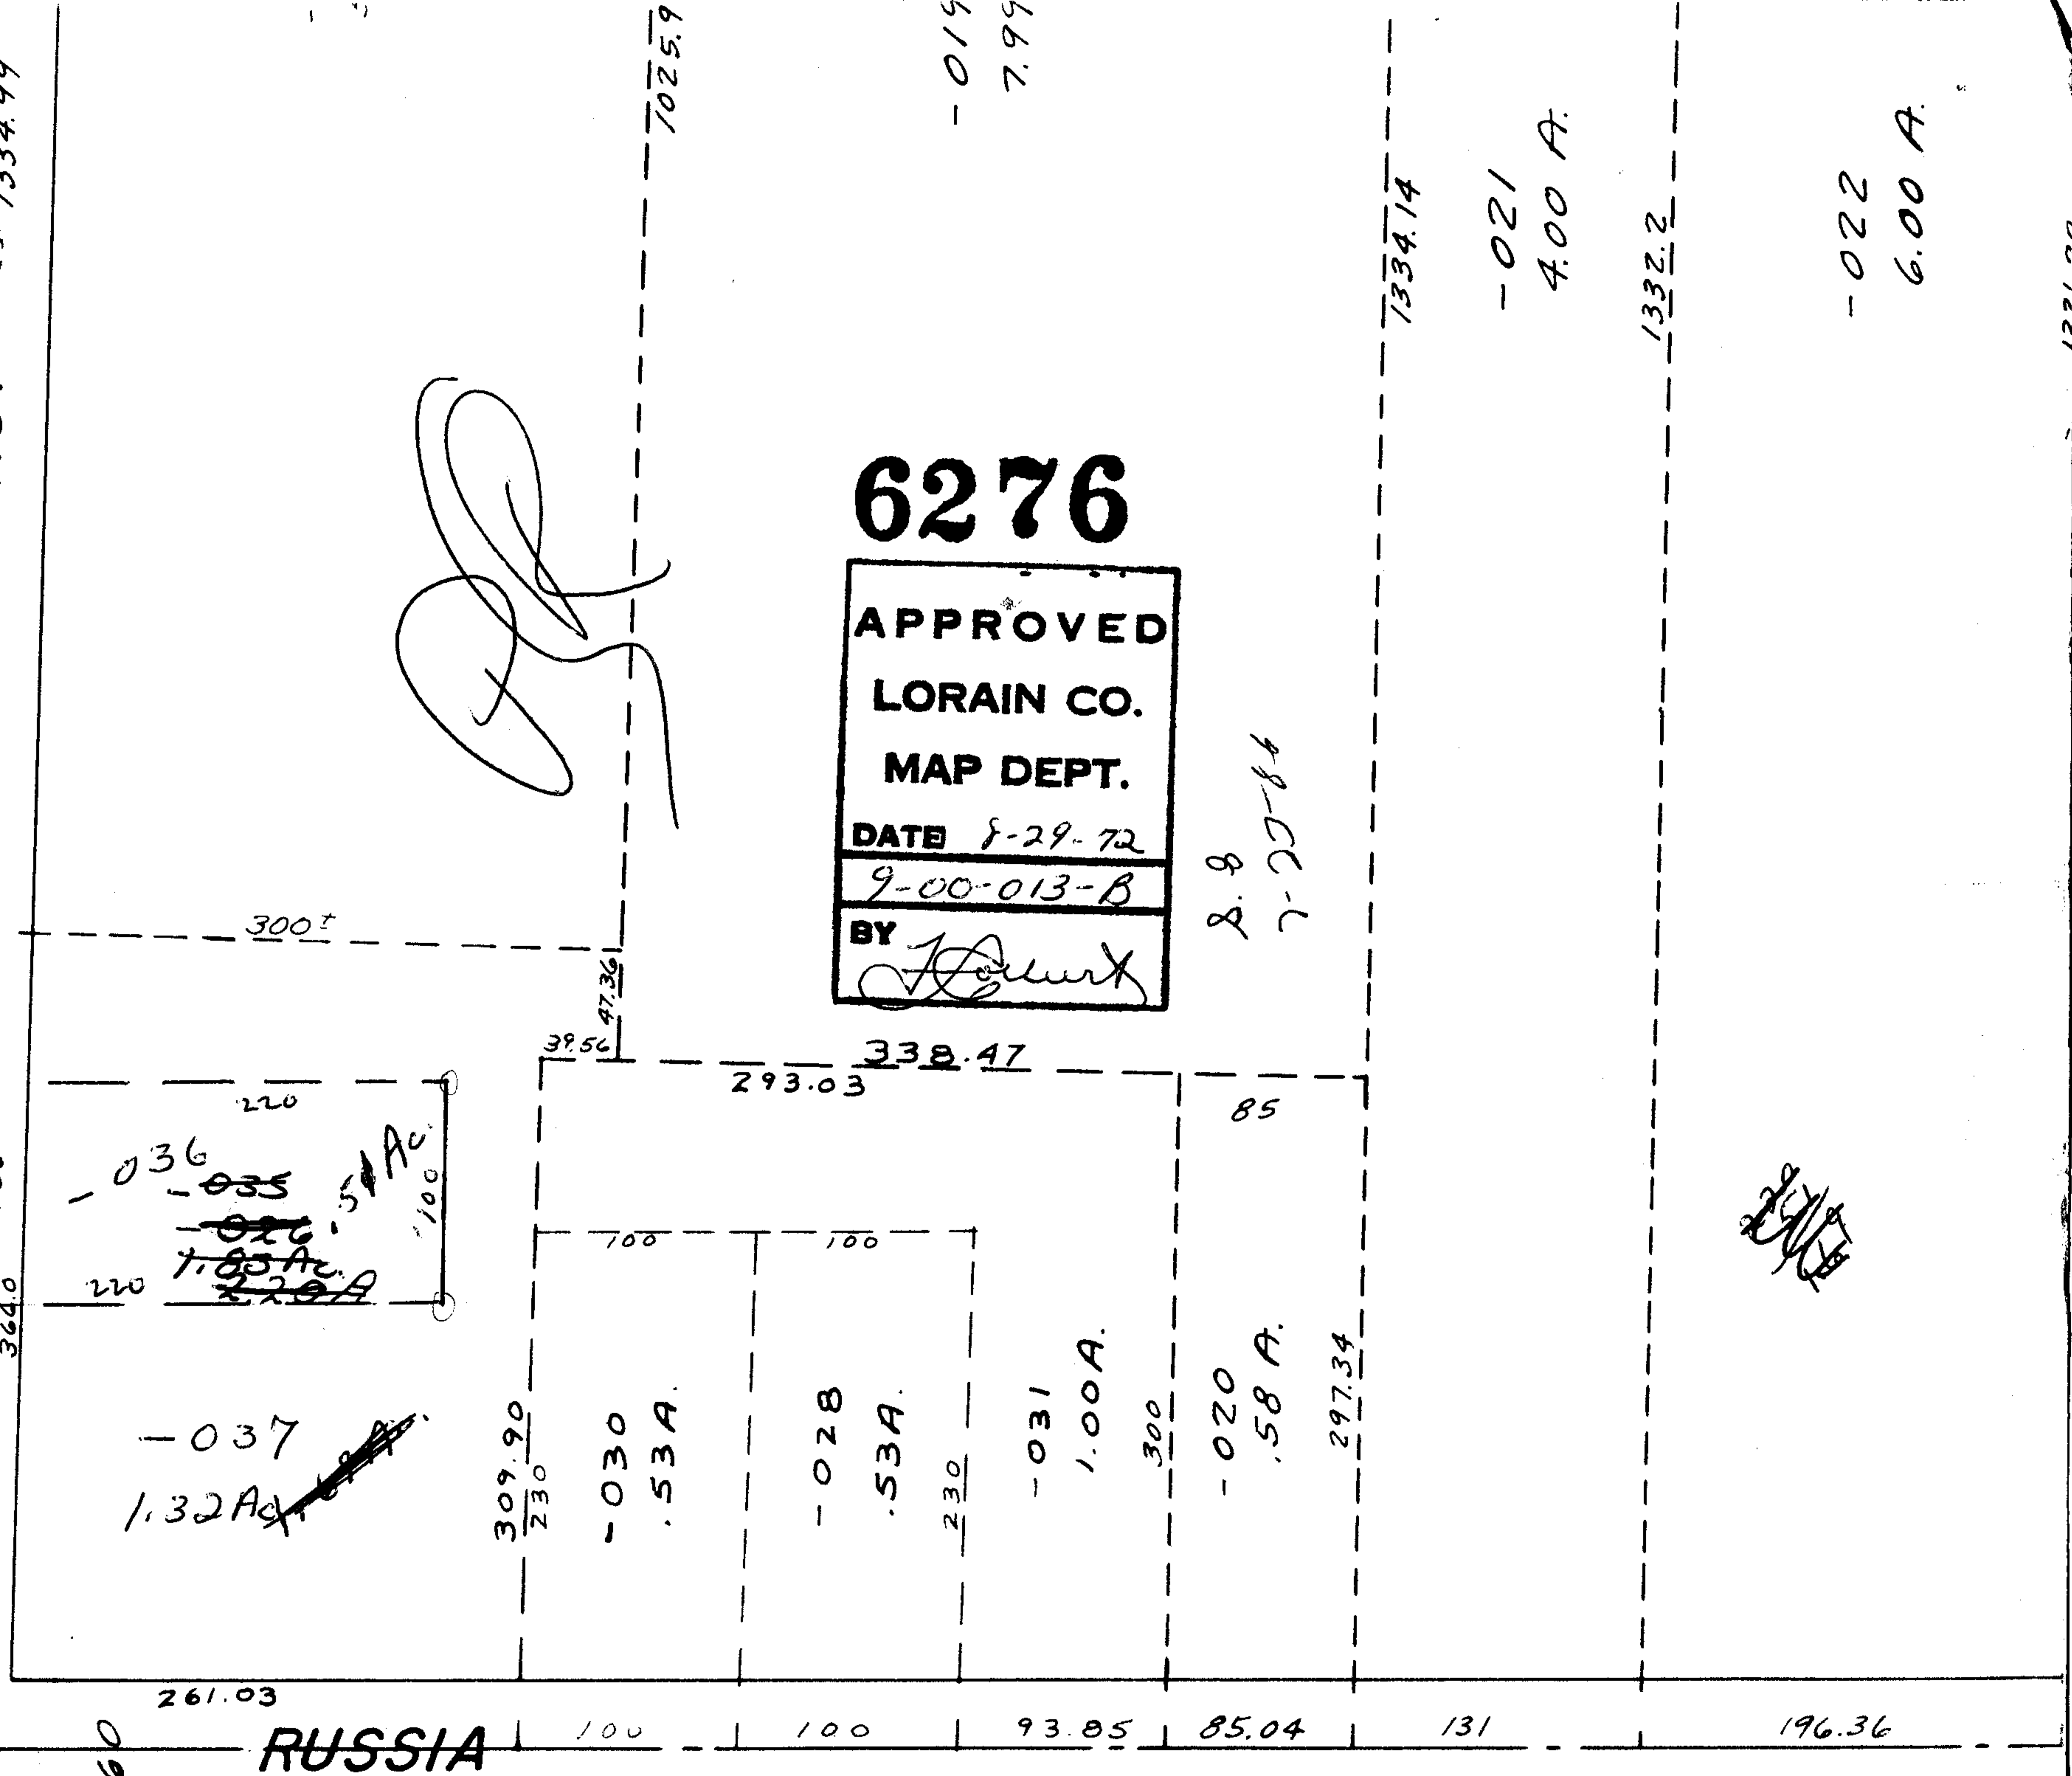

[Handwritten signature]

6276

APPROVED
LORAIN CO.
MAP DEPT.

DATE 8-29-72
9-00-013-B

BY *[Signature]*

8.8
7-27-84

1334.14

-021
4.00 A.

1332.2

-022
6.00 A.

[Handwritten signature]

SEE 9-00-023-B