

6281



87° 24'

329.60


120.76

90° 15'

568.64

89° 45'

6-19

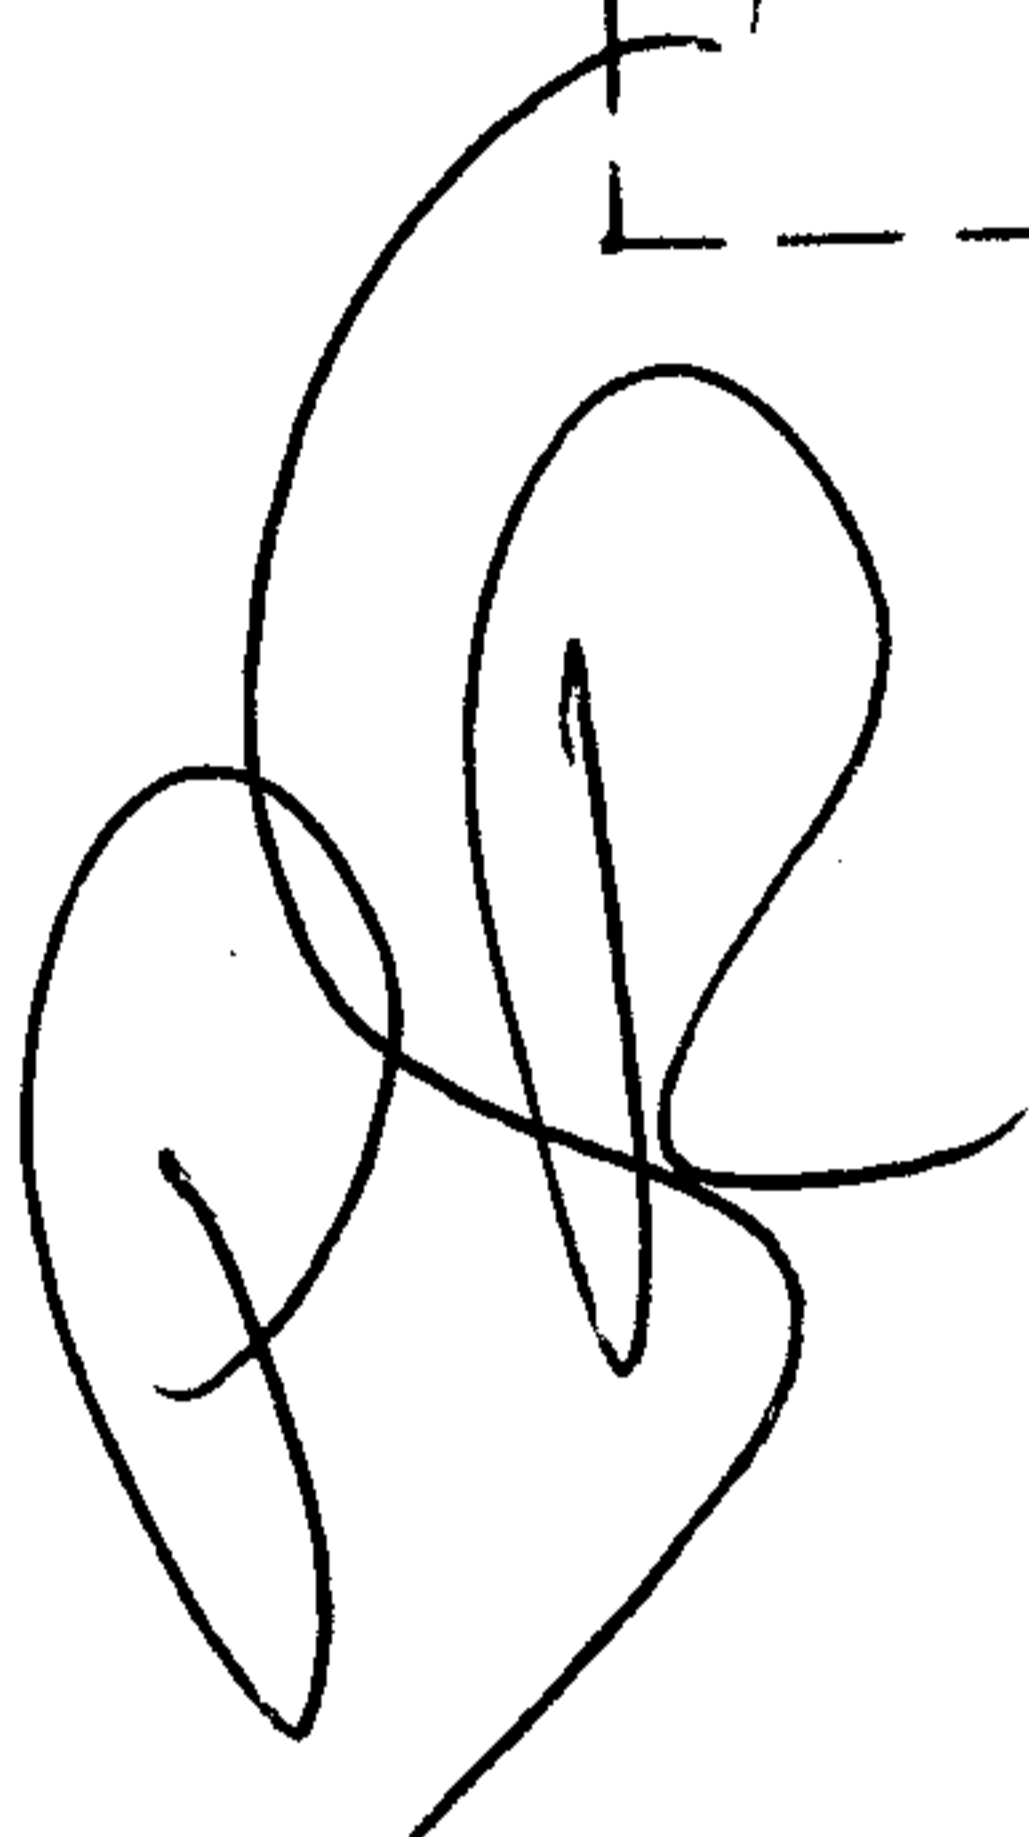

6281

APPROVED

LORAIN CO.

MAP DEPT.

DATE 8-29-72

6-19

BY L.H. Hall

Pt. ~~6-9~~ 015

Pt. ~~4~~ A. 41.10

ALSO
CHANGED
Page 6-20

200

46 AC

-014

200

849.8

977.12

21° 35'

Pt. -001
Pt. 6.02 A.

500

500

-002
2.22 A.

W.

107.79

107.79

107.79

5-D

9
11.5