


6292 OK

QUARRY

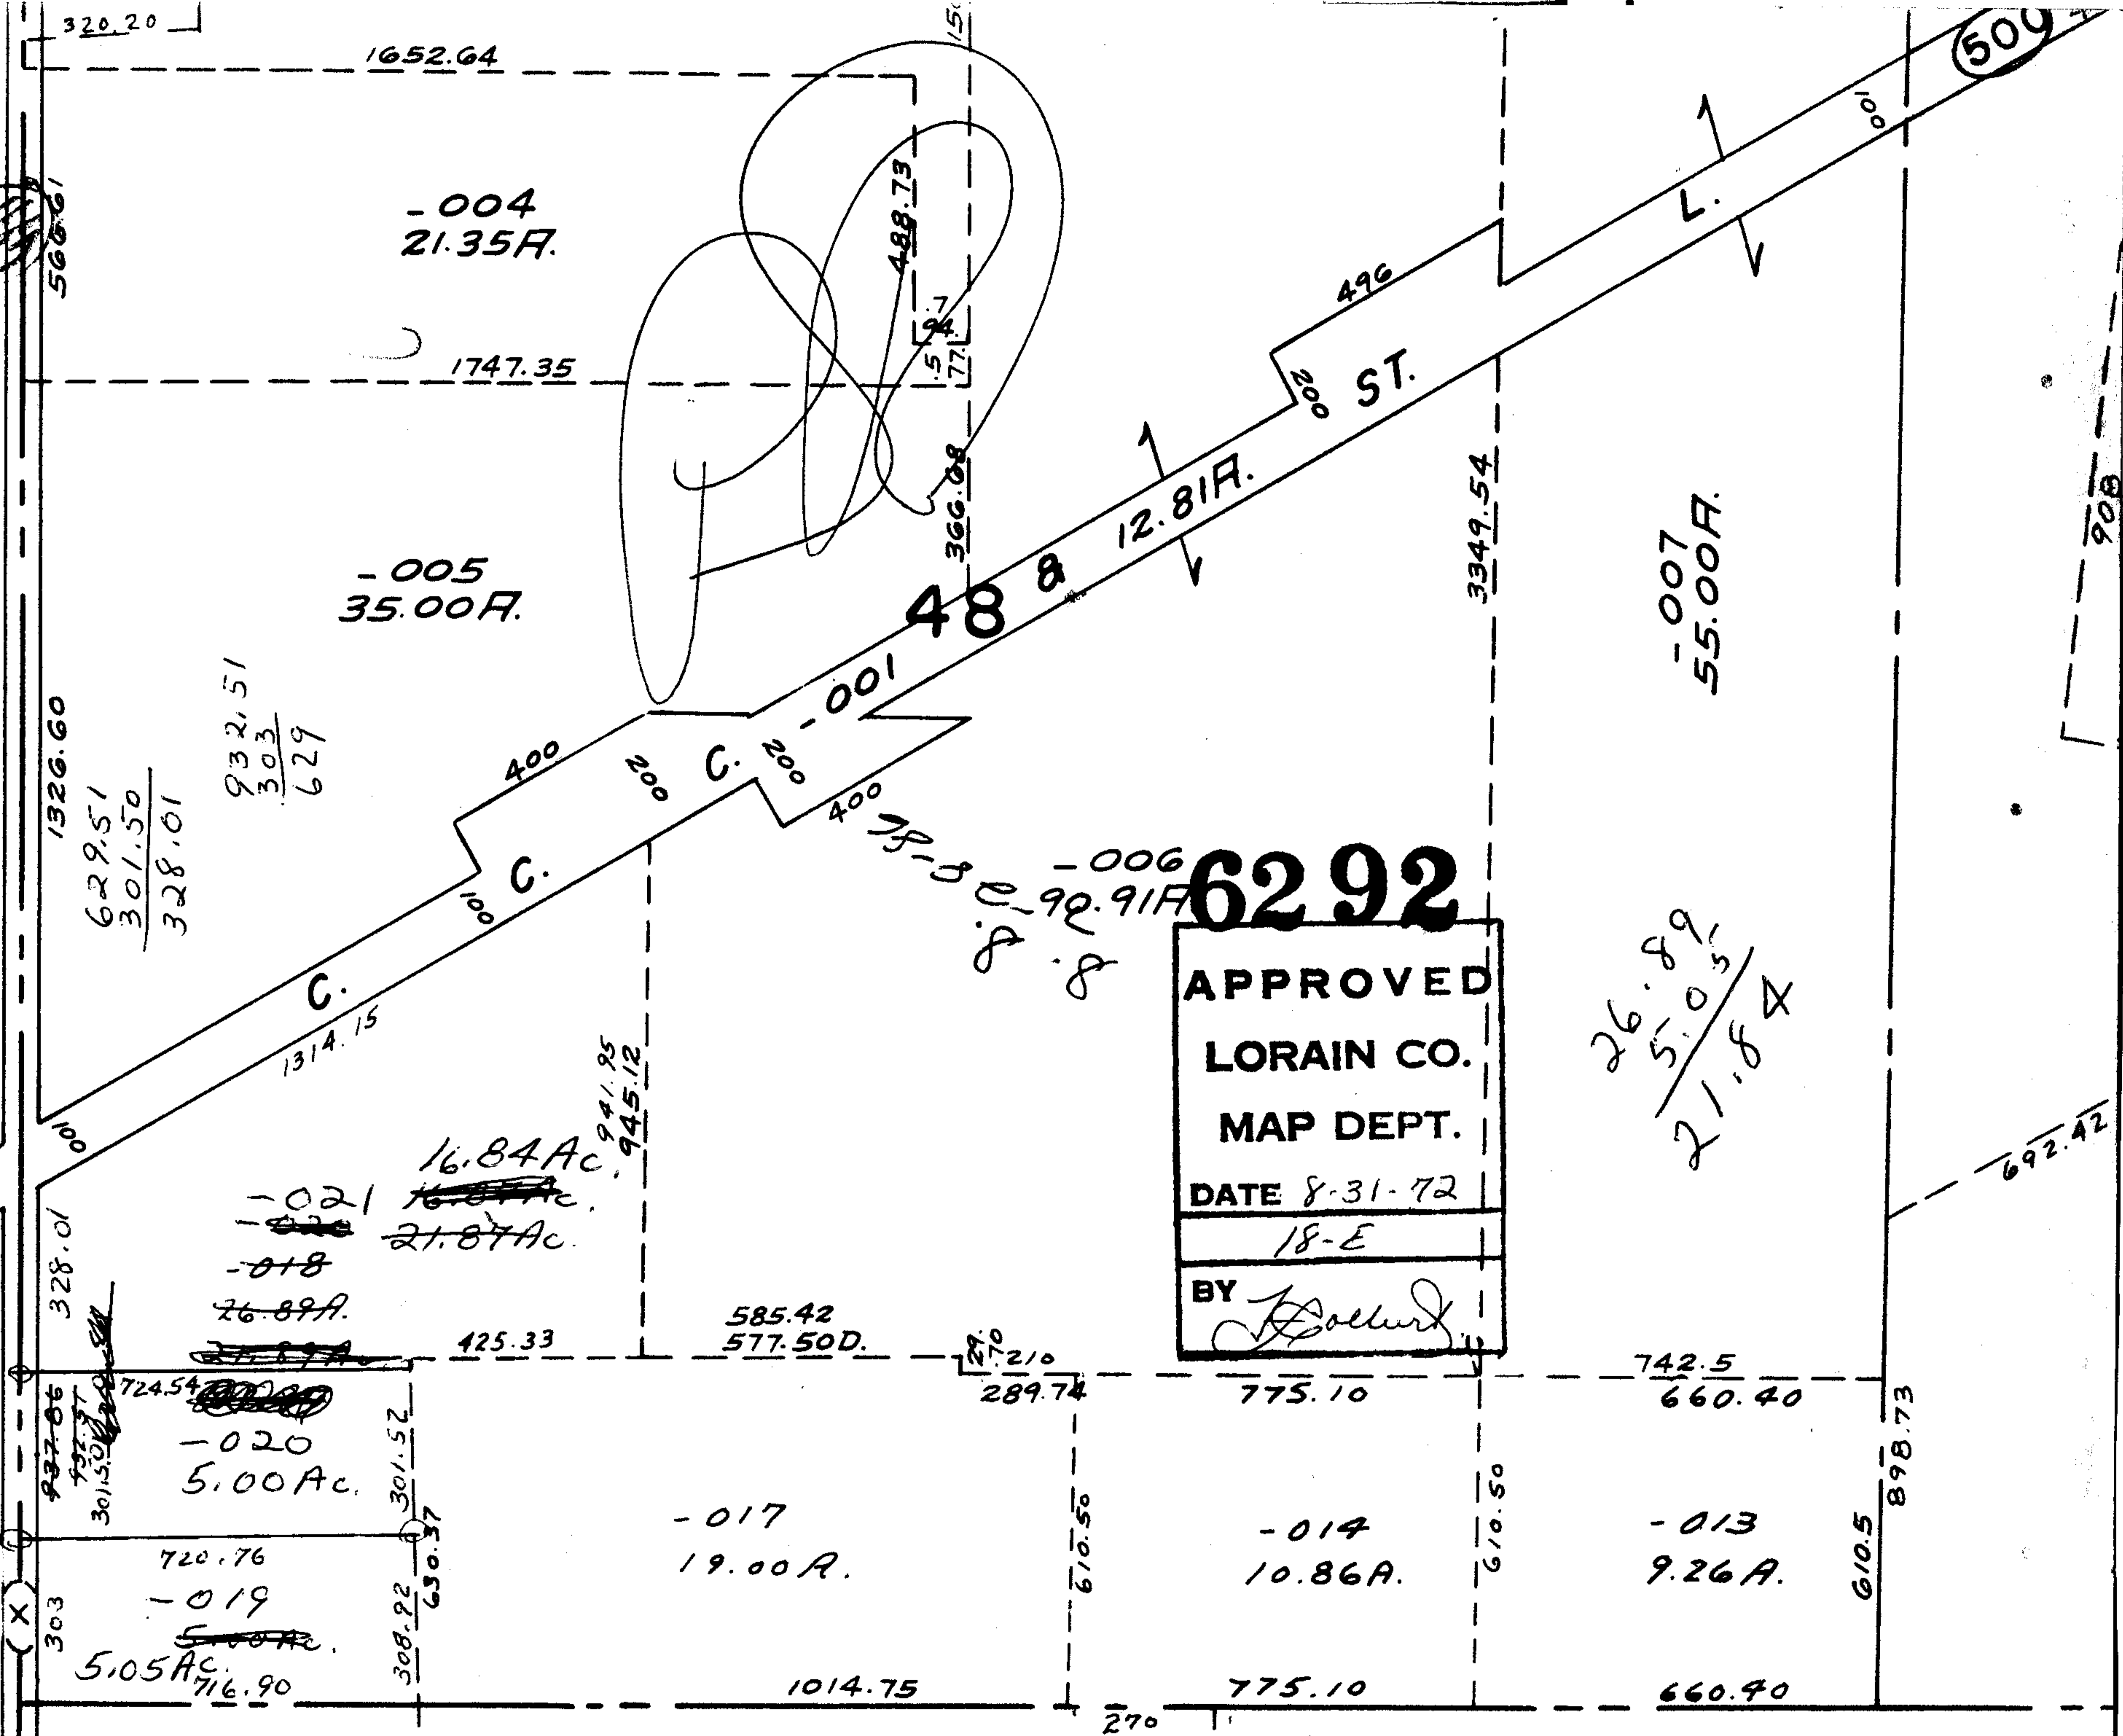

6292

APPROVED
 LORAIN CO.
 MAP DEPT.
 DATE 8-31-72
 18-E
 BY *[Signature]*

Handwritten calculation:

$$\frac{26.89}{21.84} = 1.2317$$

SEE 21-A