


2400

RD 175

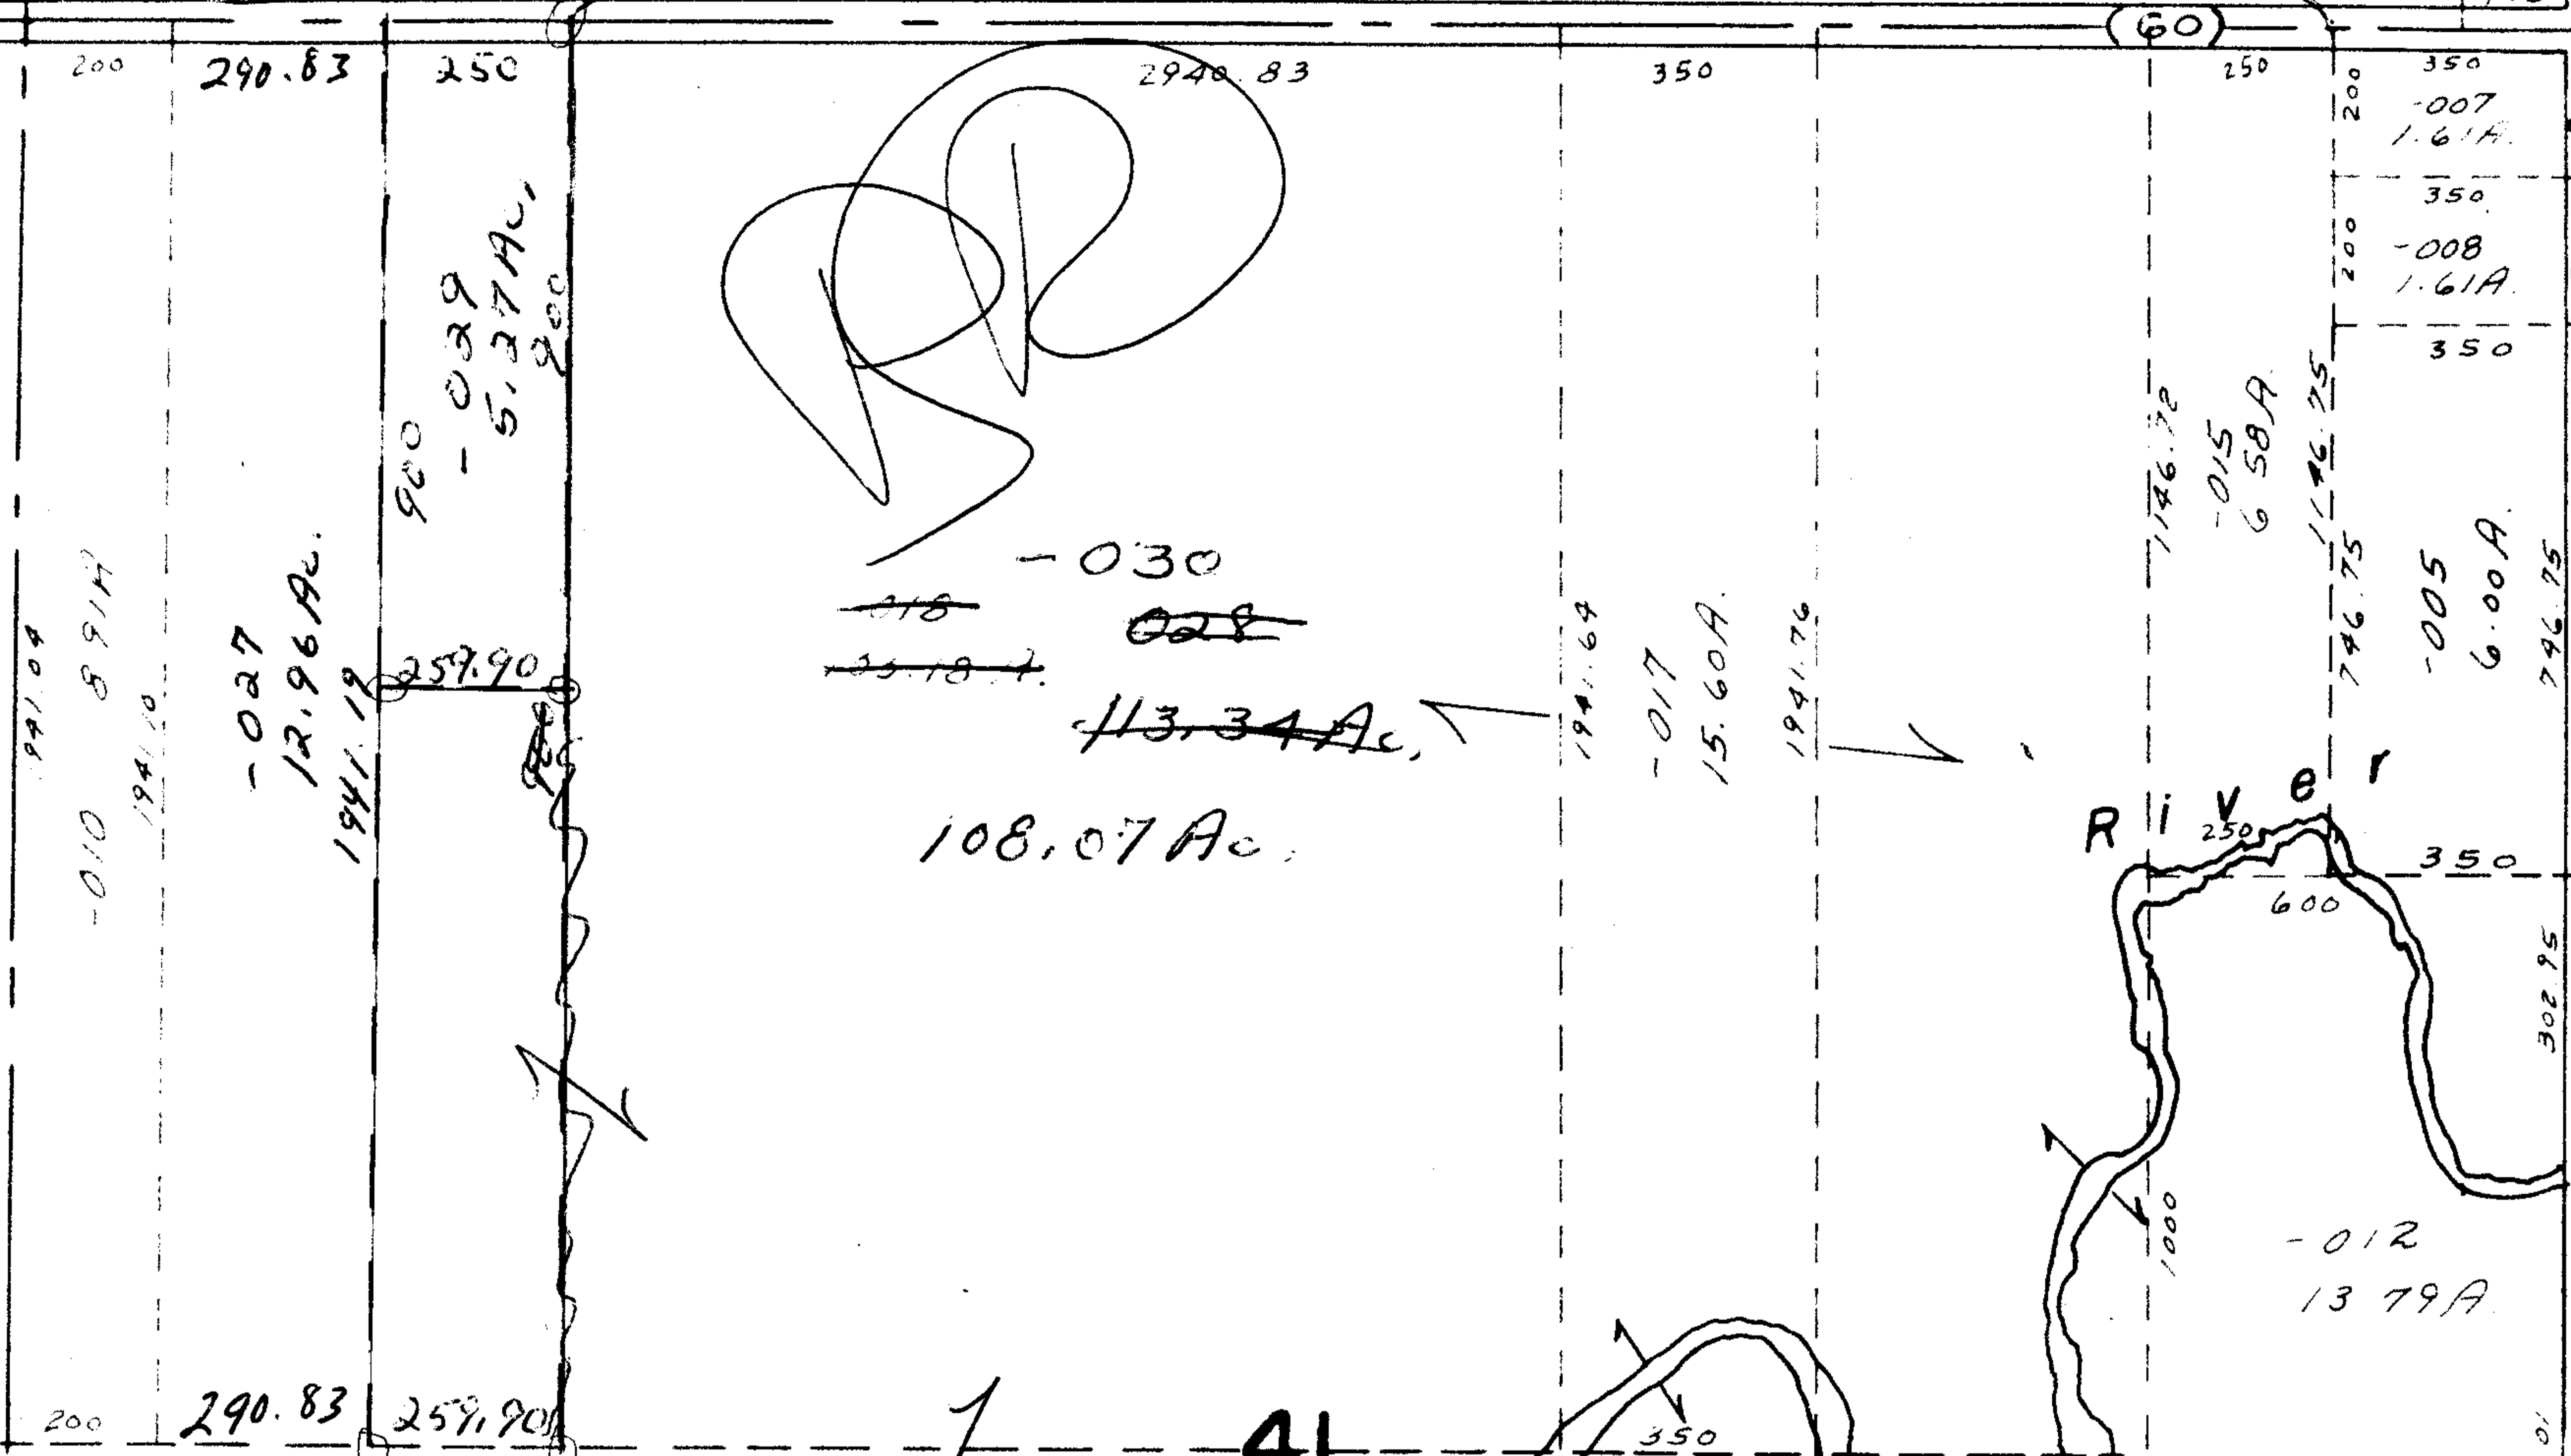

$$\frac{113.34}{5.27} = 108.07$$

41

6301

APPROVED
LORAIN CO.
MAP DEPT.
 DATE 9-7-72
 18-A
 BY *[Signature]*

SEE 18-B



OK

6301

18-A