


17-07-007-000-  
003 -017  
~~7568 AC~~  
67.24 AC

4417.64

363

-008  
.91 A.

99

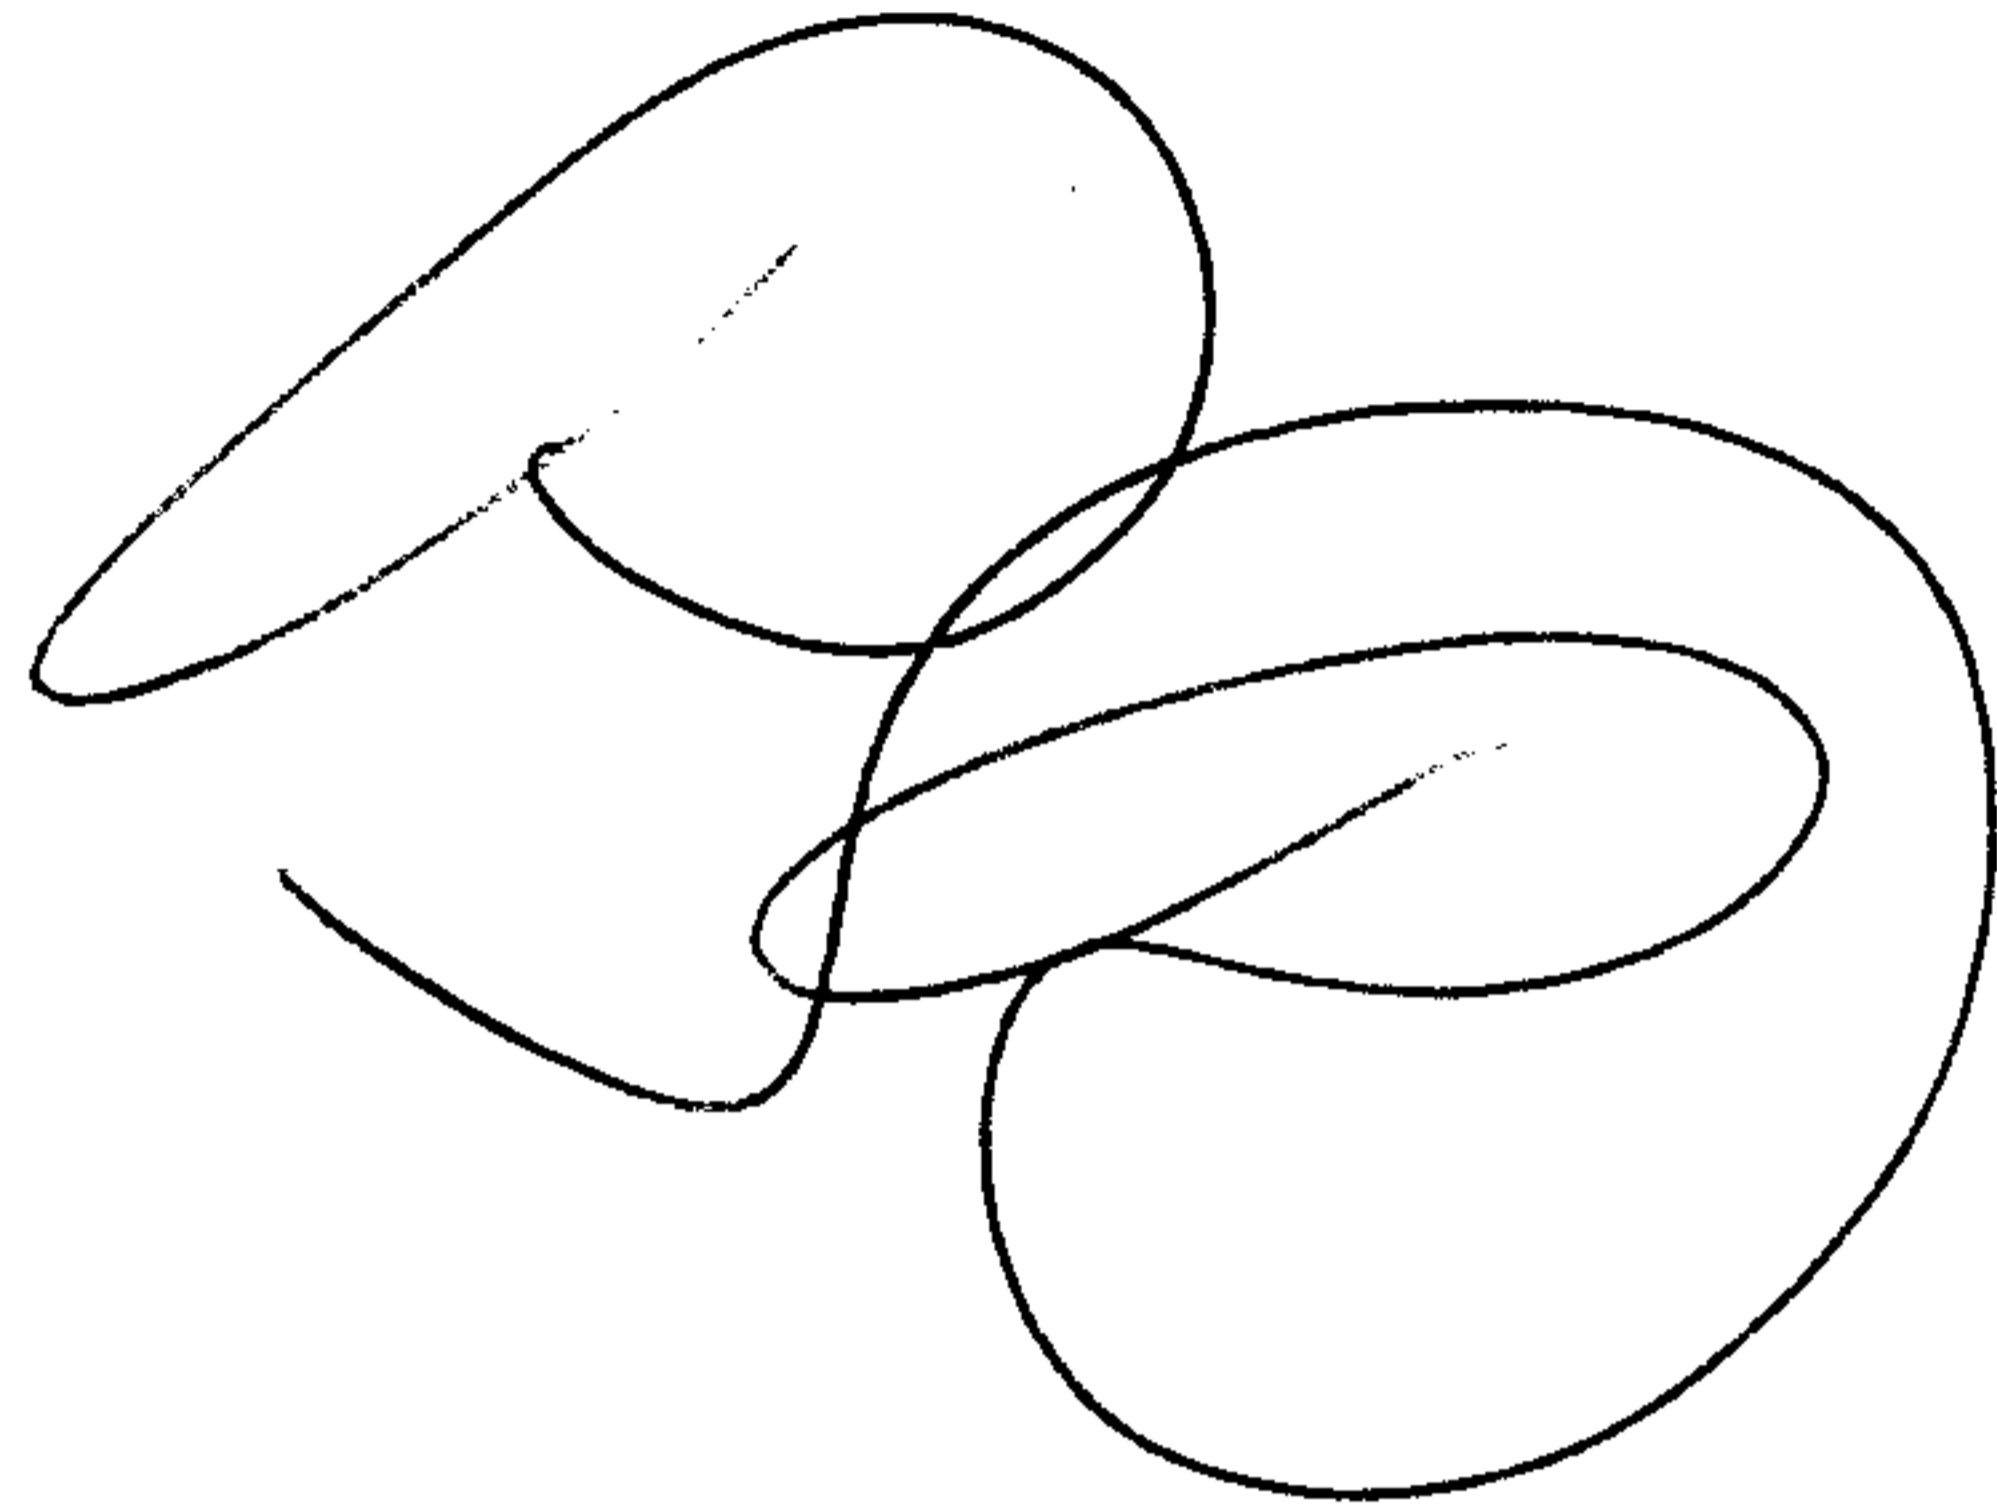

123.15  
125.29  
148.50  
396.94

-009  
2.59 A.

17-07-007-000-009  
Evans  
22 Rods

-016  
8.44 AC

753.41

6312  
APPROVED  
LORAIN CO.  
MAP DEPT.  
DATE 9-13-72  
17-07-007B  
BY LW Hall

7-25-86 h.

363  
123.15 125.29

-010  
1.06 A.

-011  
.75 A.

68  
116.0  
-013  
.91 A.

59.20

-014  
.50 A.

126.6  
148.5

Pt. -012  
Pt. 1.32 A.



RD.

ASHLAND - KIPTON

533.40

146.83

125.29  
420.62

60

Handwritten notes and scribbles at the bottom right corner.