


MADDOCK 350.88
350.76 RD.



6315
0/12

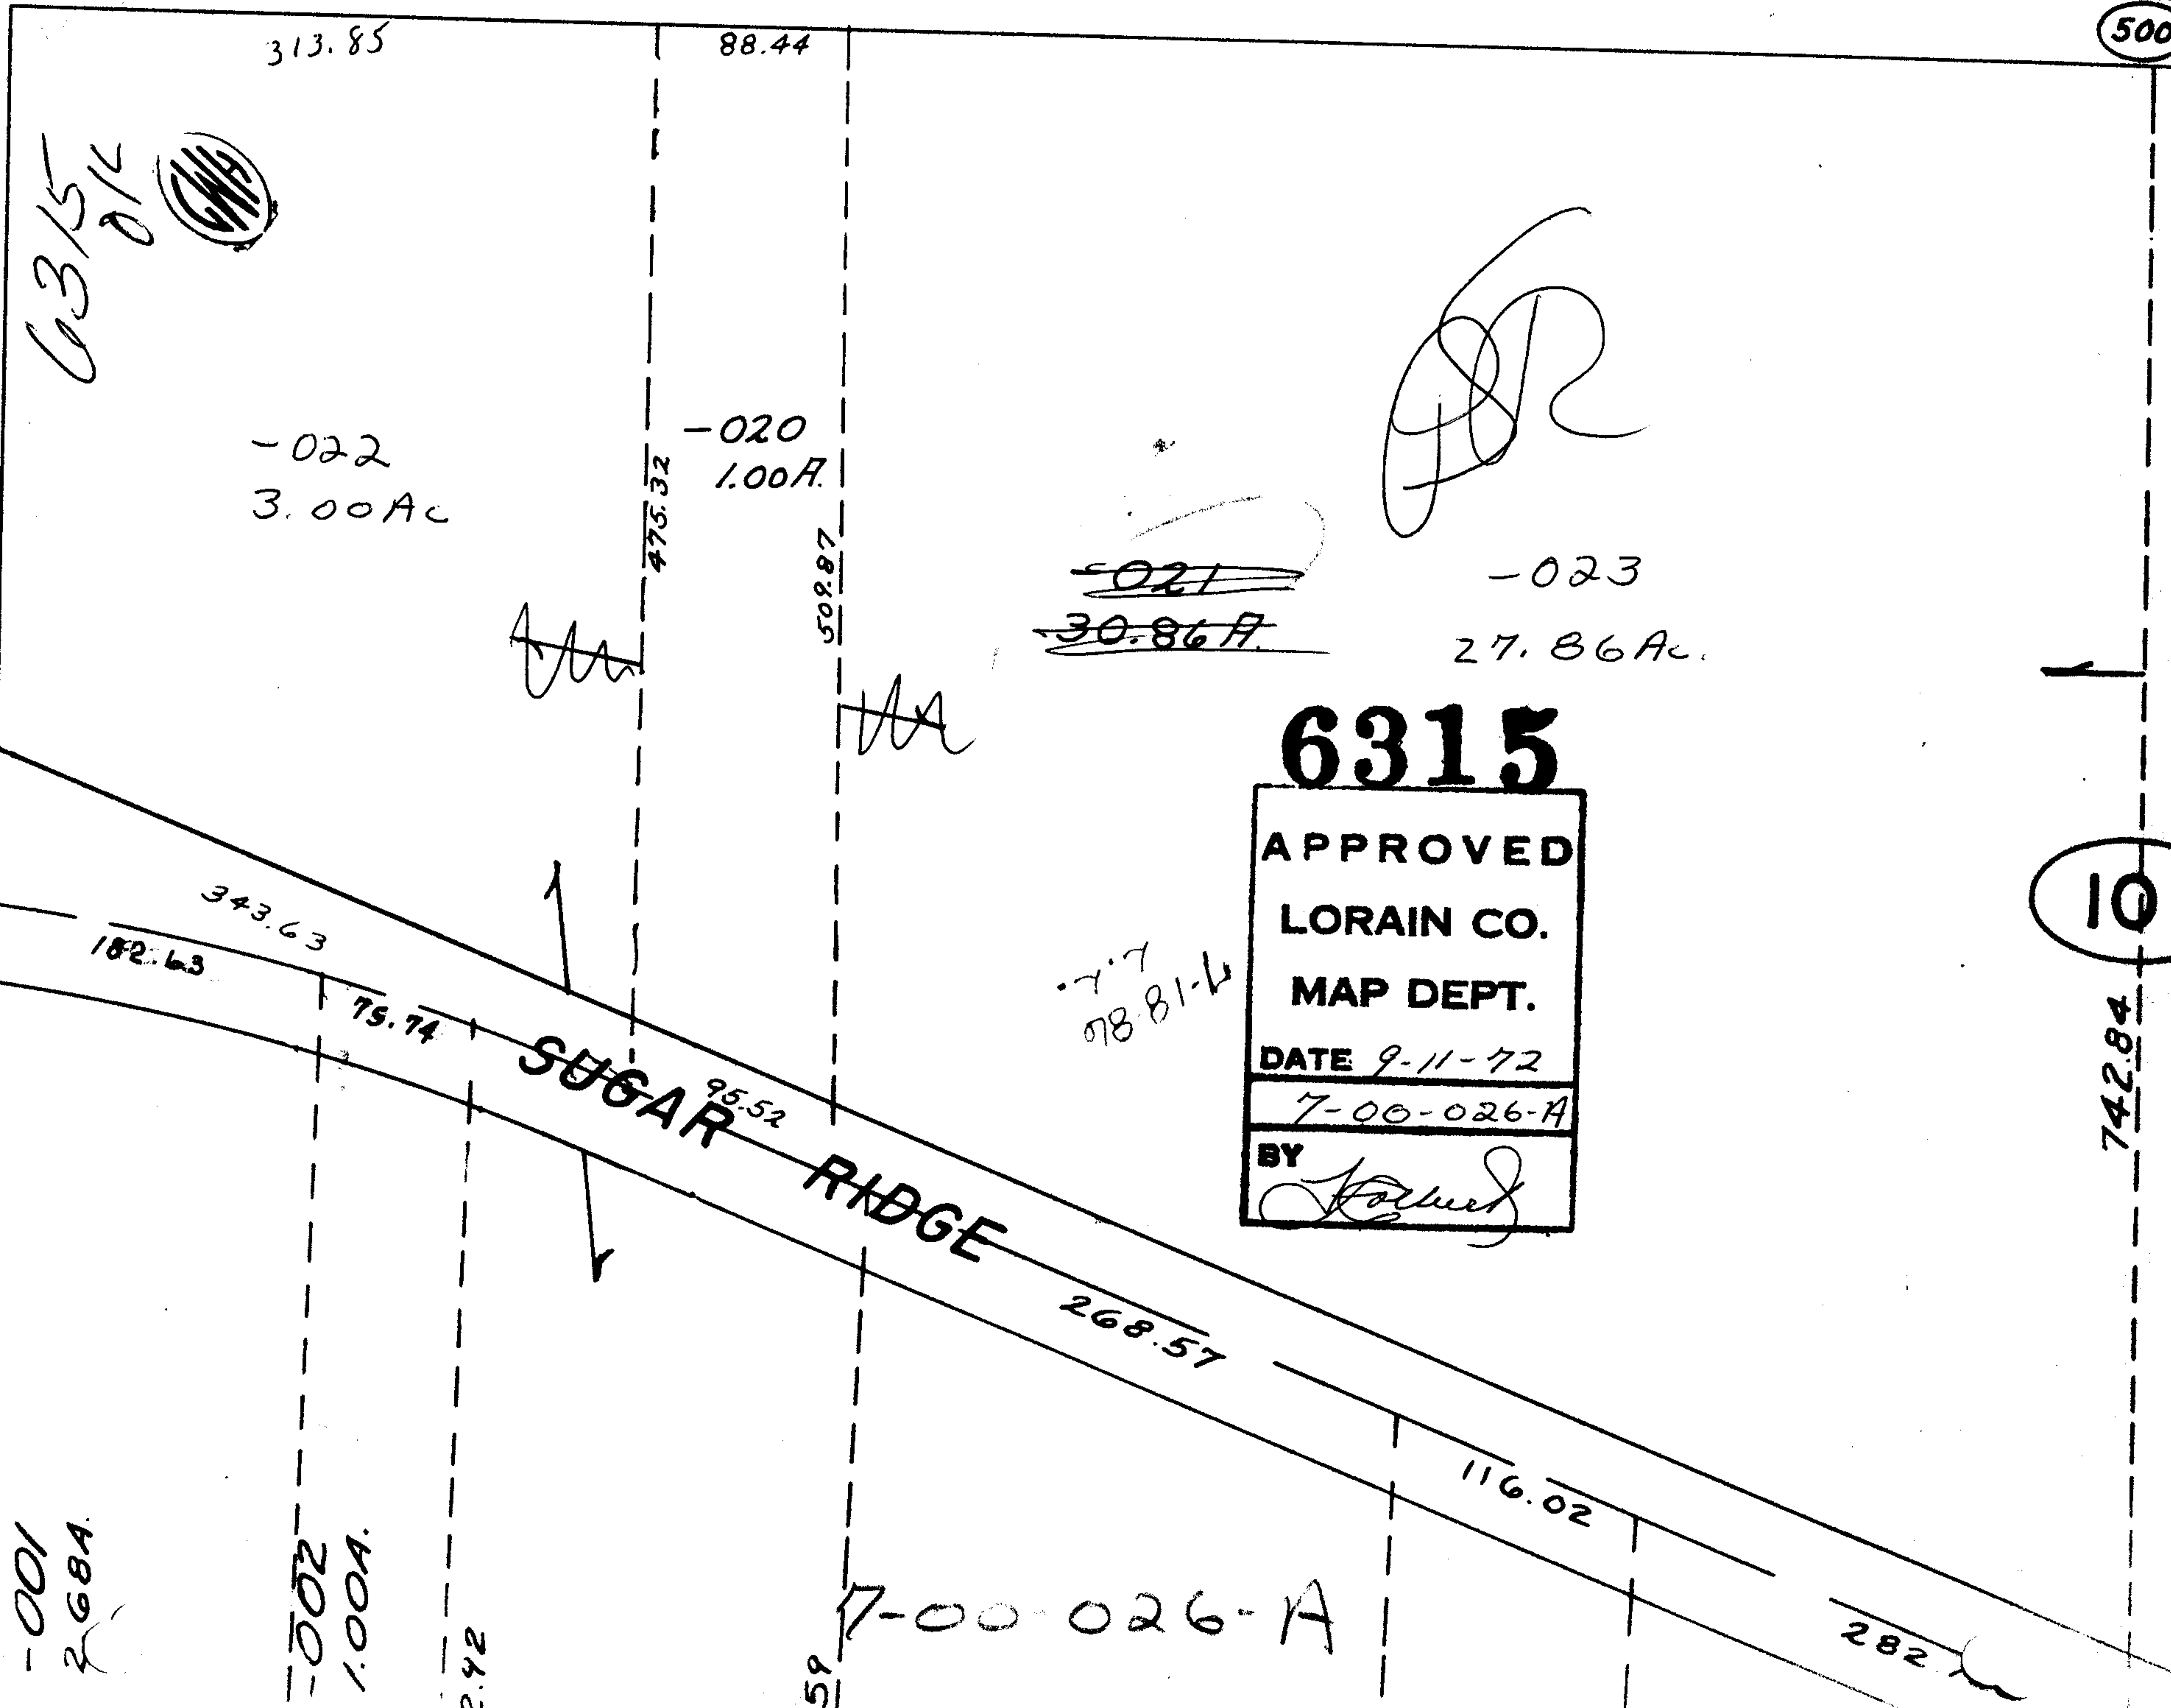

-022
3.00 Ac

-020
1.00 Ac

[Signature]

~~-021~~
~~30.86 Ac~~

-023
27.86 Ac

6315

APPROVED
LORAIN CO.
MAP DEPT.
DATE 9-11-72
7-00-026-A
BY *[Signature]*

7.7
08-81-4

SUGAR RIDGE

101

74.52

-001
2.68 Ac

-002
1.00 Ac

2.42

59

7-00-026-A

116.02

282

742.84

500