


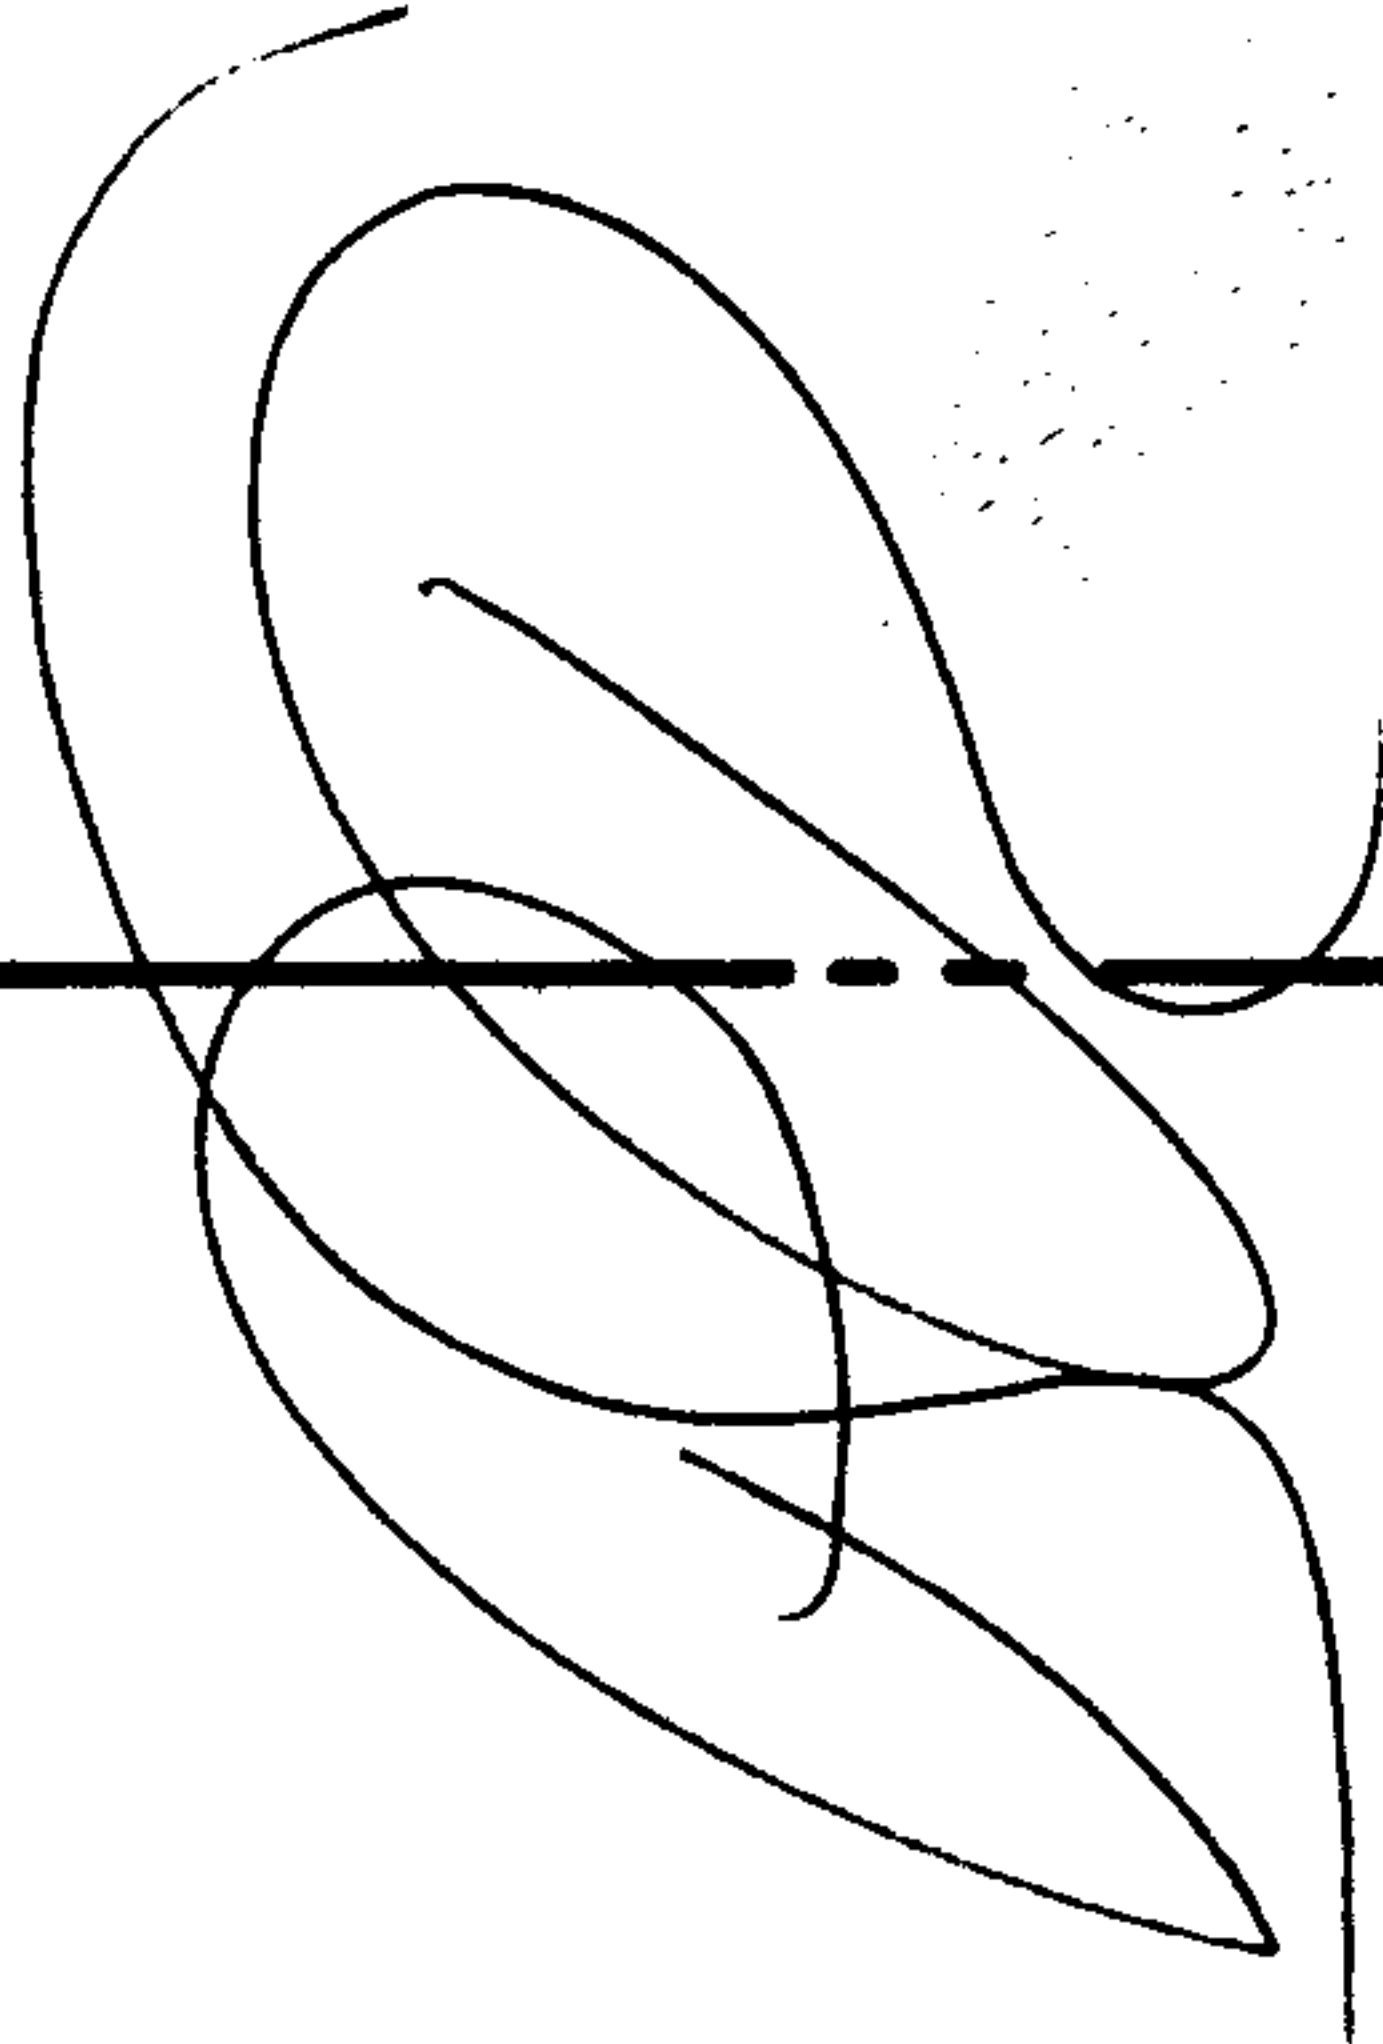
-002  
50.00 A.

-004  
49.00 A.

29.91  
5.09  
-----  
24.82

6320  
OK  


967.23  
-005  
5.09 Ac.  
971.77



-002  
68.00 A.

8

8

~~-001  
37.50 A.~~

-006  
24.82 Ac.

-002  
39.00 A.

ROWELL 1501.68

6320

Austin

APPROVED

RD.

LORAIN CO.

MAP DEPT.

DATE 9-12-72

13-H

BY

*Loeber*

-002  
73.00 A.

-001  
70.00 A.

13-H