


6333

1941.04
-010 8.91A
1941.10



6333

APPROV
LORAIN
MAP DE
DATE 9-15-72
18A
BY L.W. HAY

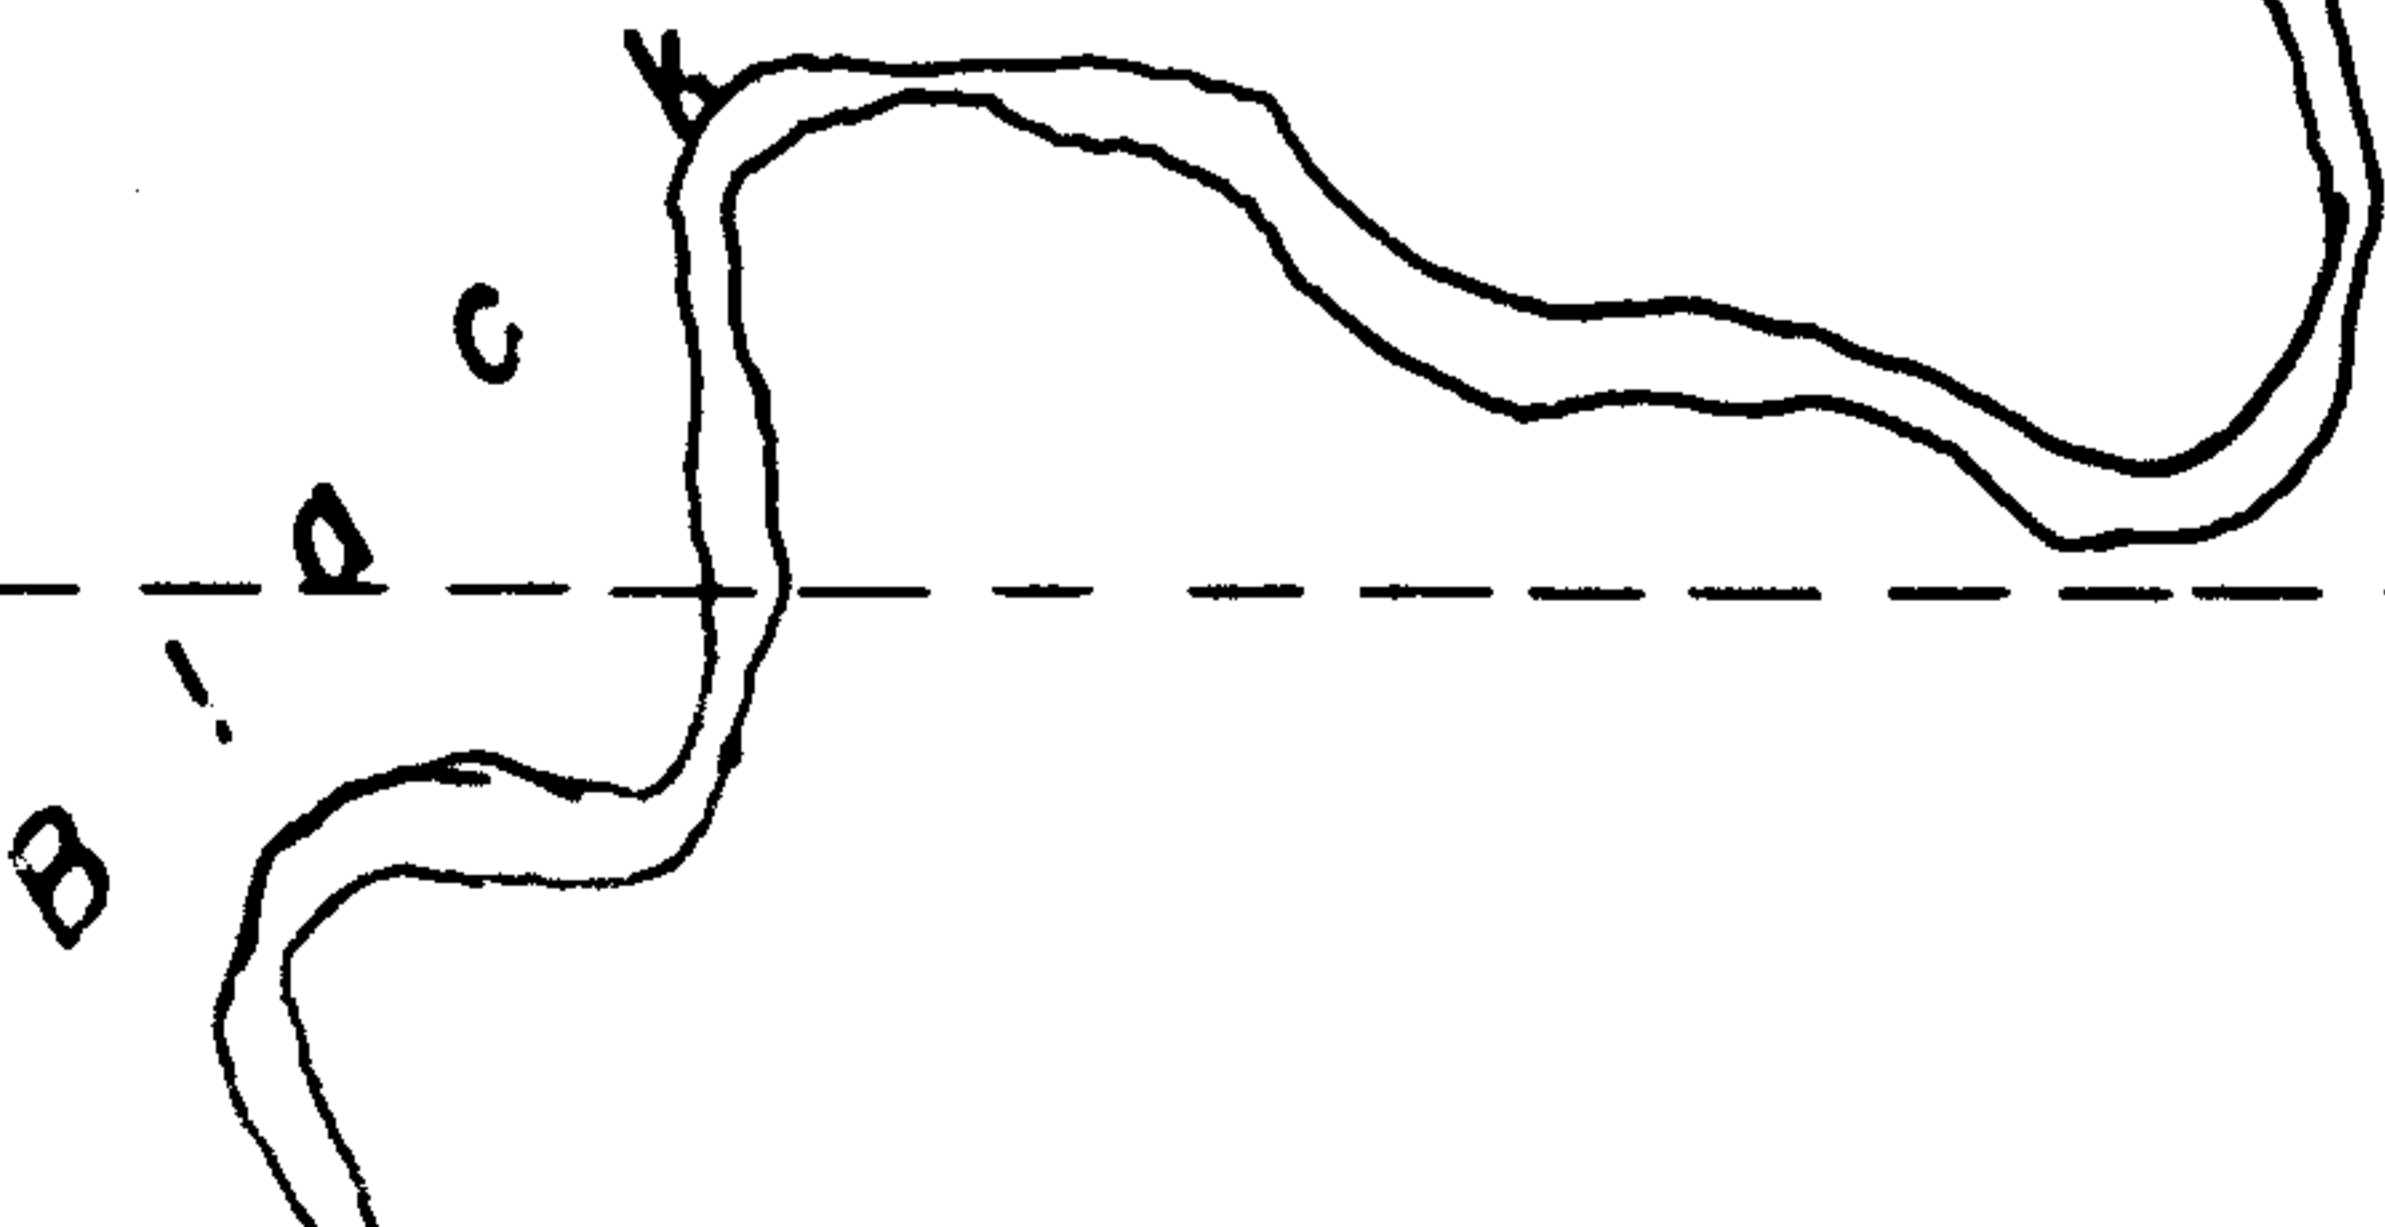

900
-031
5.16 AC
900

~~032~~ - 032
103.18 A. *OK*

108.07 AC
102.91 AC

41

2150

2940.83

350

1941.64

-017
15.60A.

1941.76

-013
71.32A

R I V E R

-012
13.79A

-005
6.00A.

-015
6.58A.

-007
1.61A.

-008
1.61A.

601.34

697.01

796.75

796.75

796.75

(60)

RD

175

SEE 18-B

18A