


-002
68.00 A.



6335

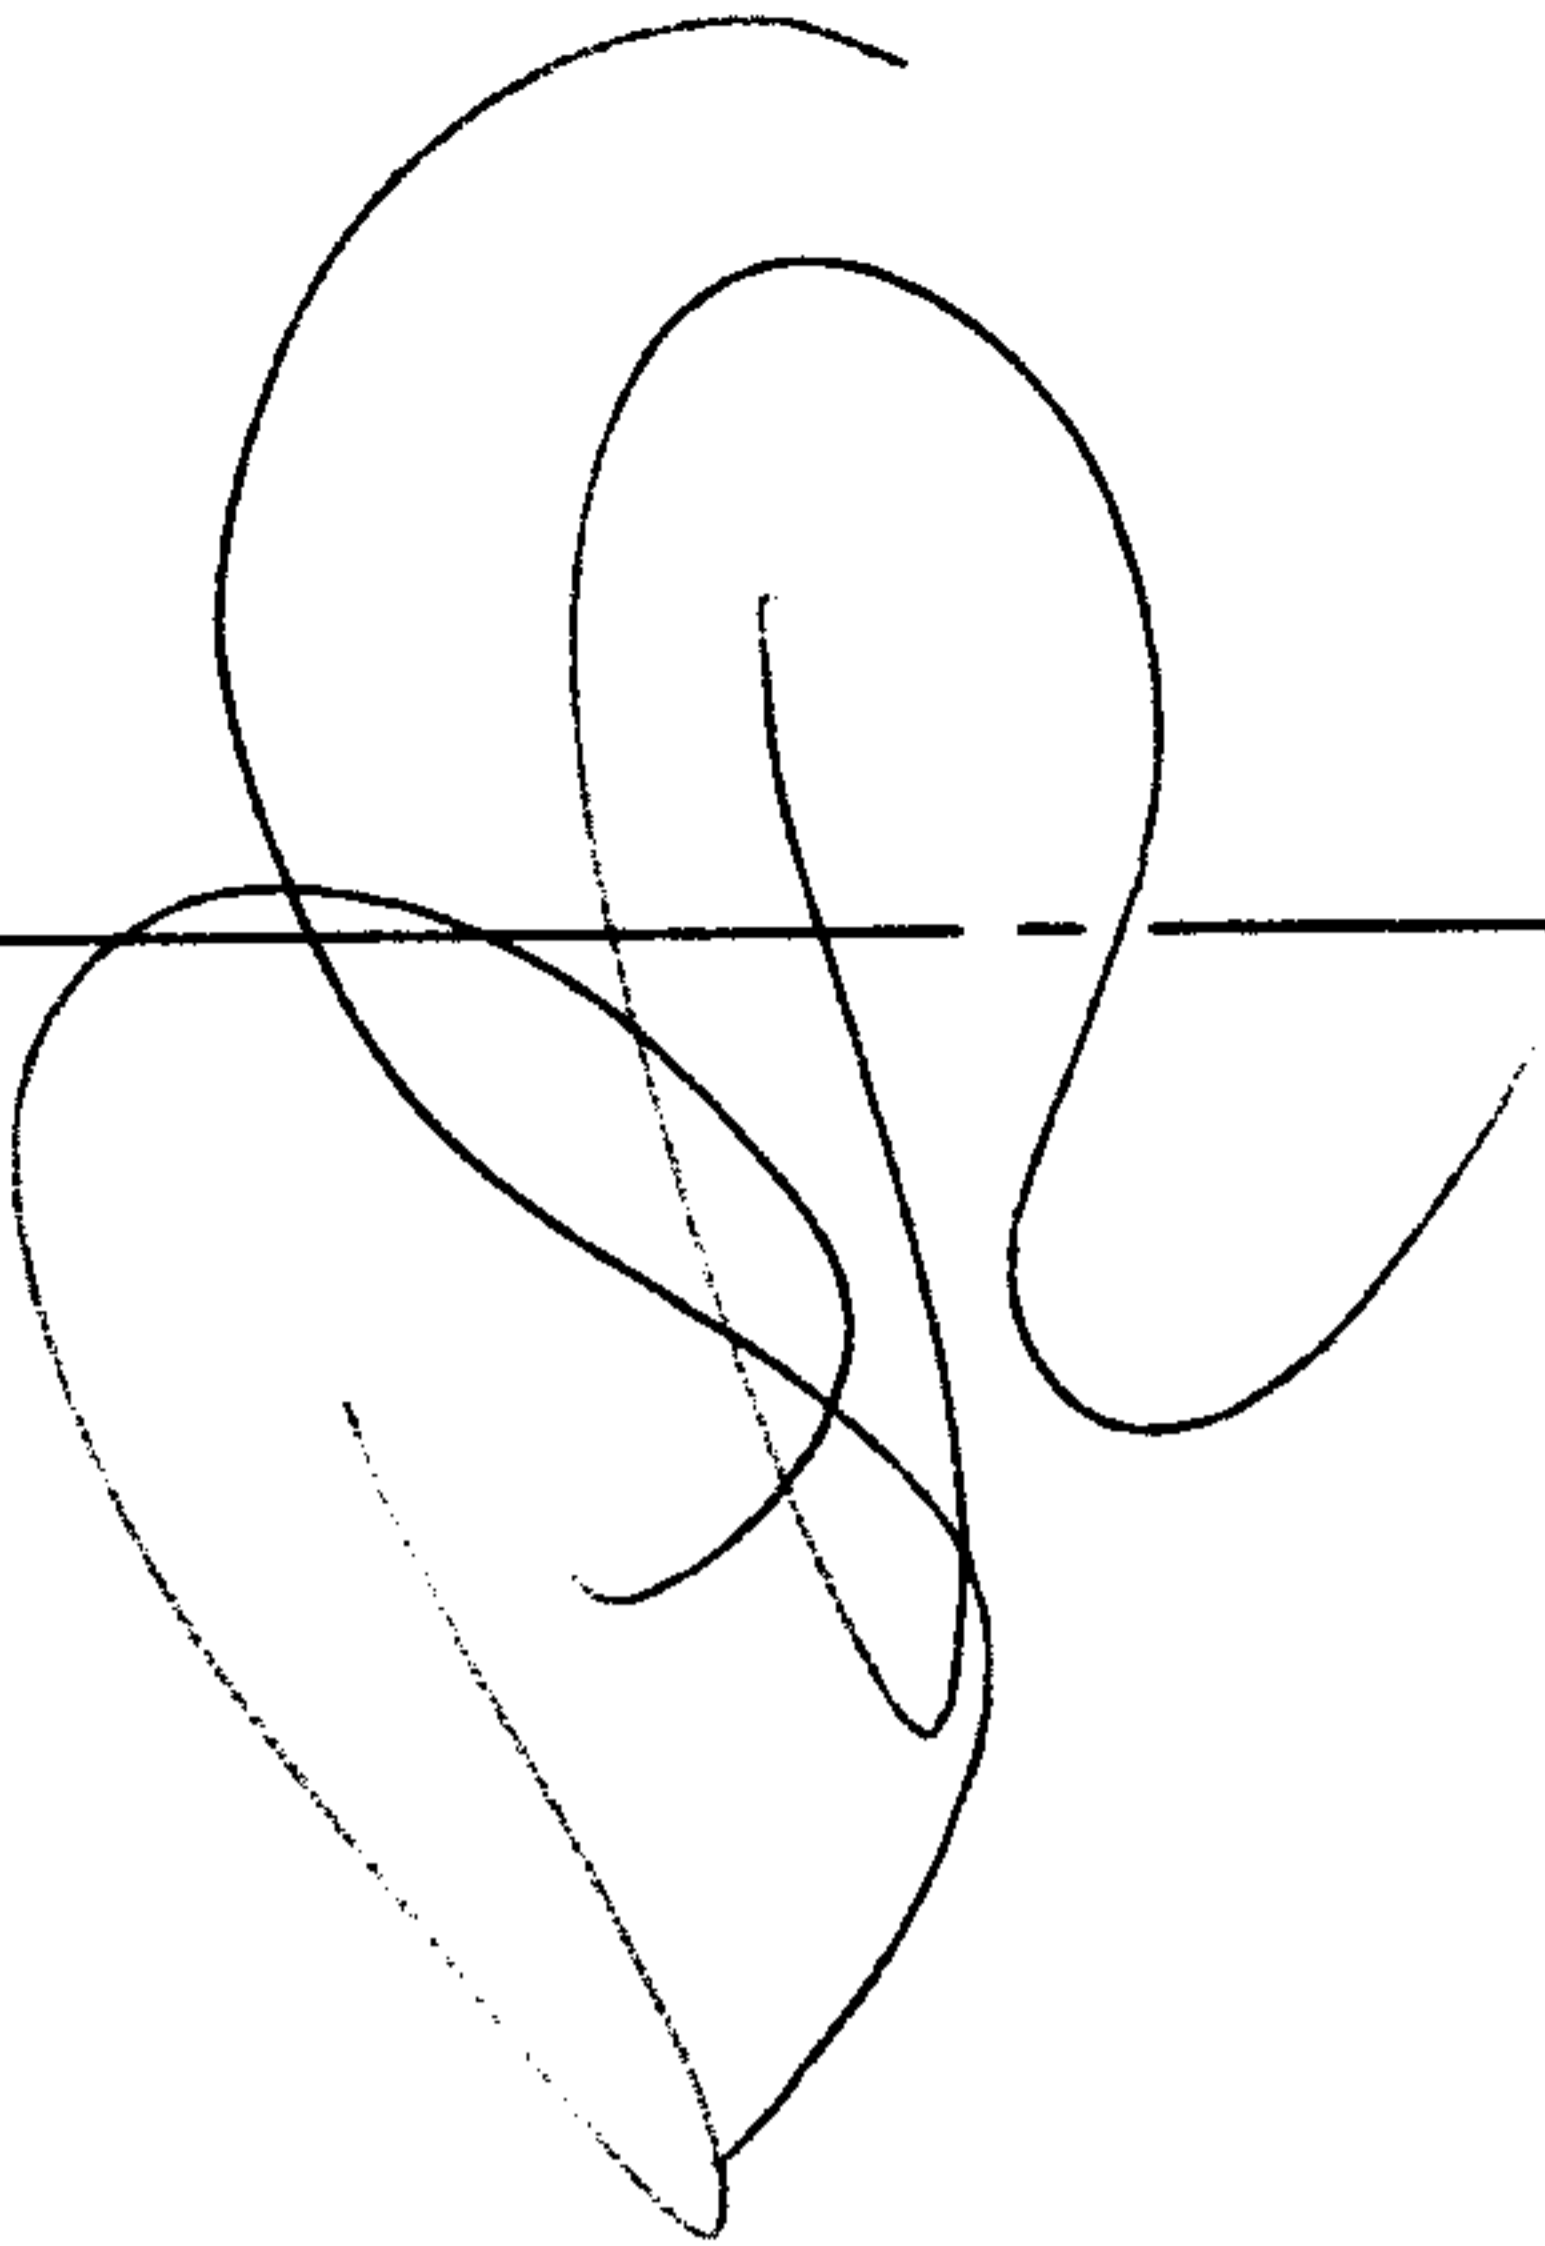

OK

-005

40.36 A

-003
14.50 A.

-007
~~-001~~
~~41.00 A.~~
108.53 Ac.

6335

31

APPROVED
LORAIN CO.
MAP DEPT.
DATE 9-19-72
17-H
BY *[Signature]*

398.55

-004
10.14 A.

1040

841.70

498.65

587.35

312.47 346.67
-006 2.47 A.
342.01 312.54

1408.30 RD.

442.2
277.20 165.004
-005 198
198 759

17-H

814.79

670.81

732 165
-011 227.2
-012 50A
71A
165 LIBB 132

111
2.47
108.53

-001
10.00 A.

663.90

664.20
663.70

-005
21.66 A.

945.61
946.10

35.20 A

64
33

1055 36
1089

T

A

90