


SEE 9-00-003



6351
OK

105

1320.12

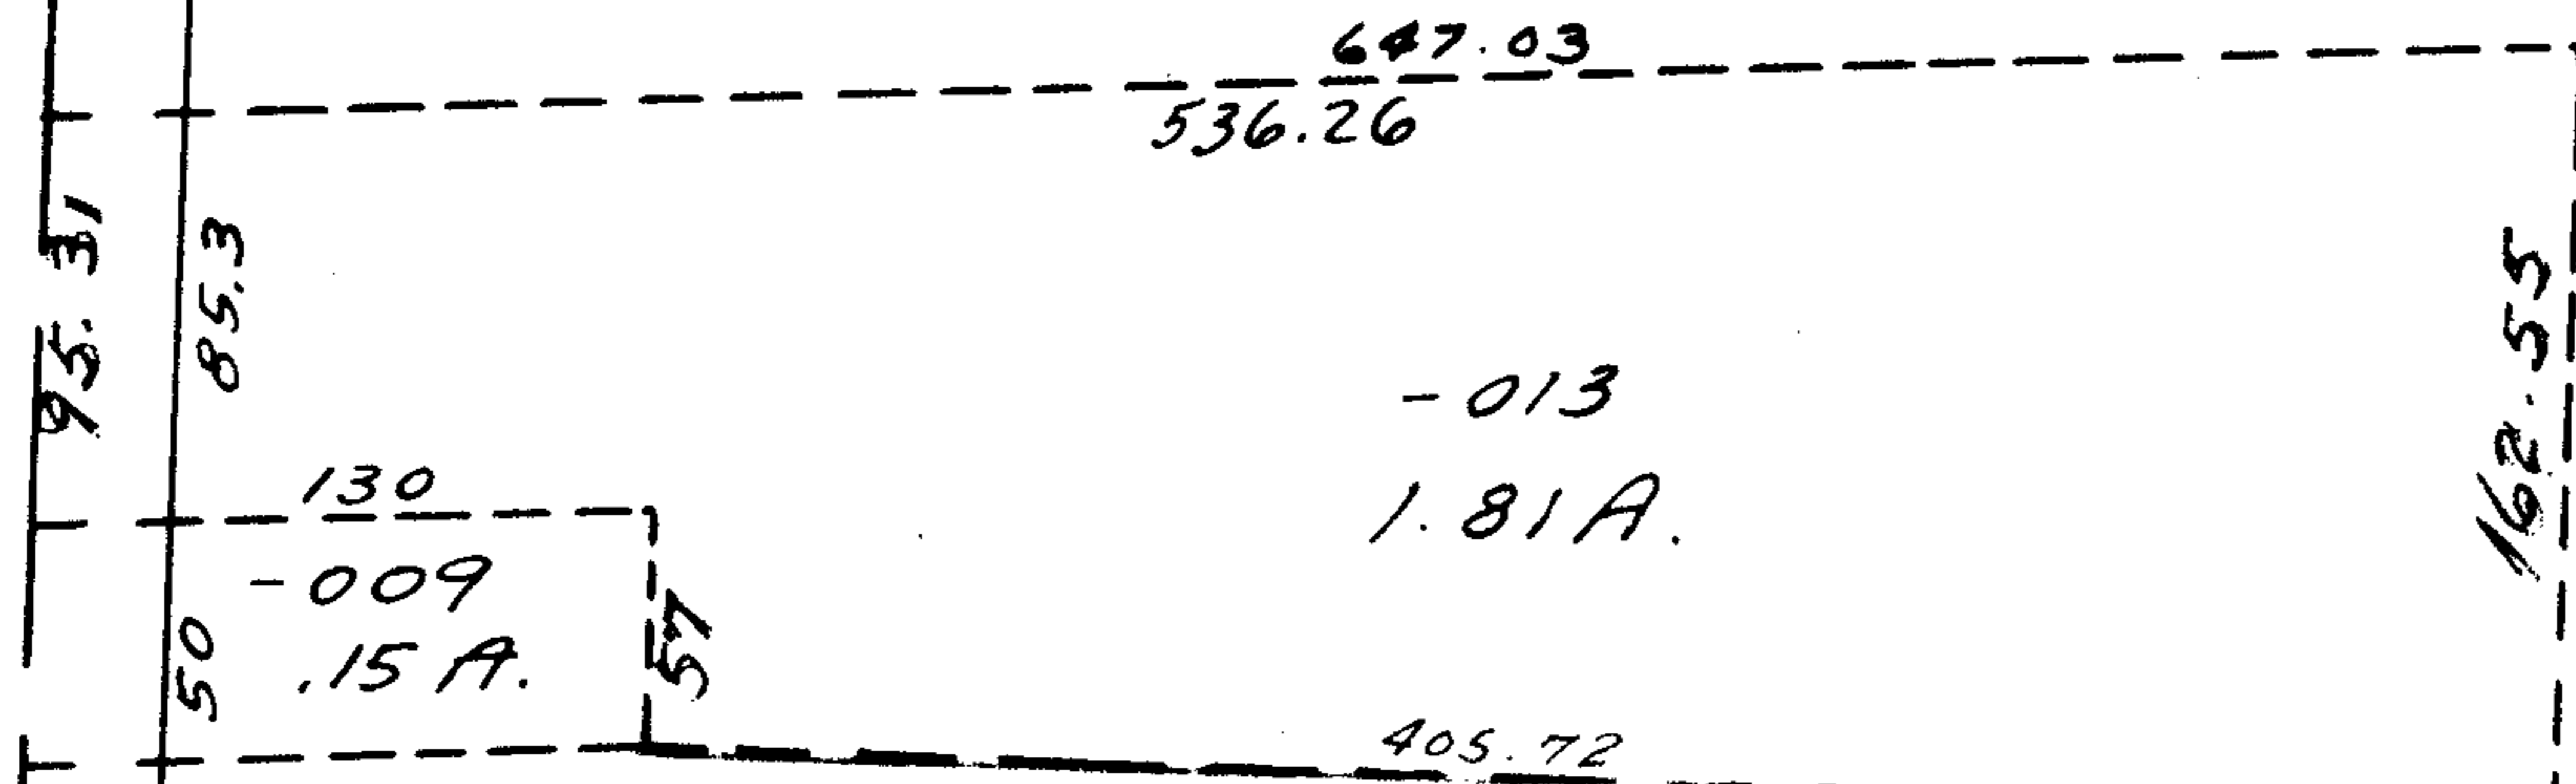

161.15



6351

APPROVED
 LORAIN CO.
 MAP DEPT.
 DATE 9-21-72
 9-00-003-B
 BY *[Signature]*

-019
~~-017~~
~~5.46 A.~~
 4.23 Ac.

S. B. S. E.

546
123
23
A. 23

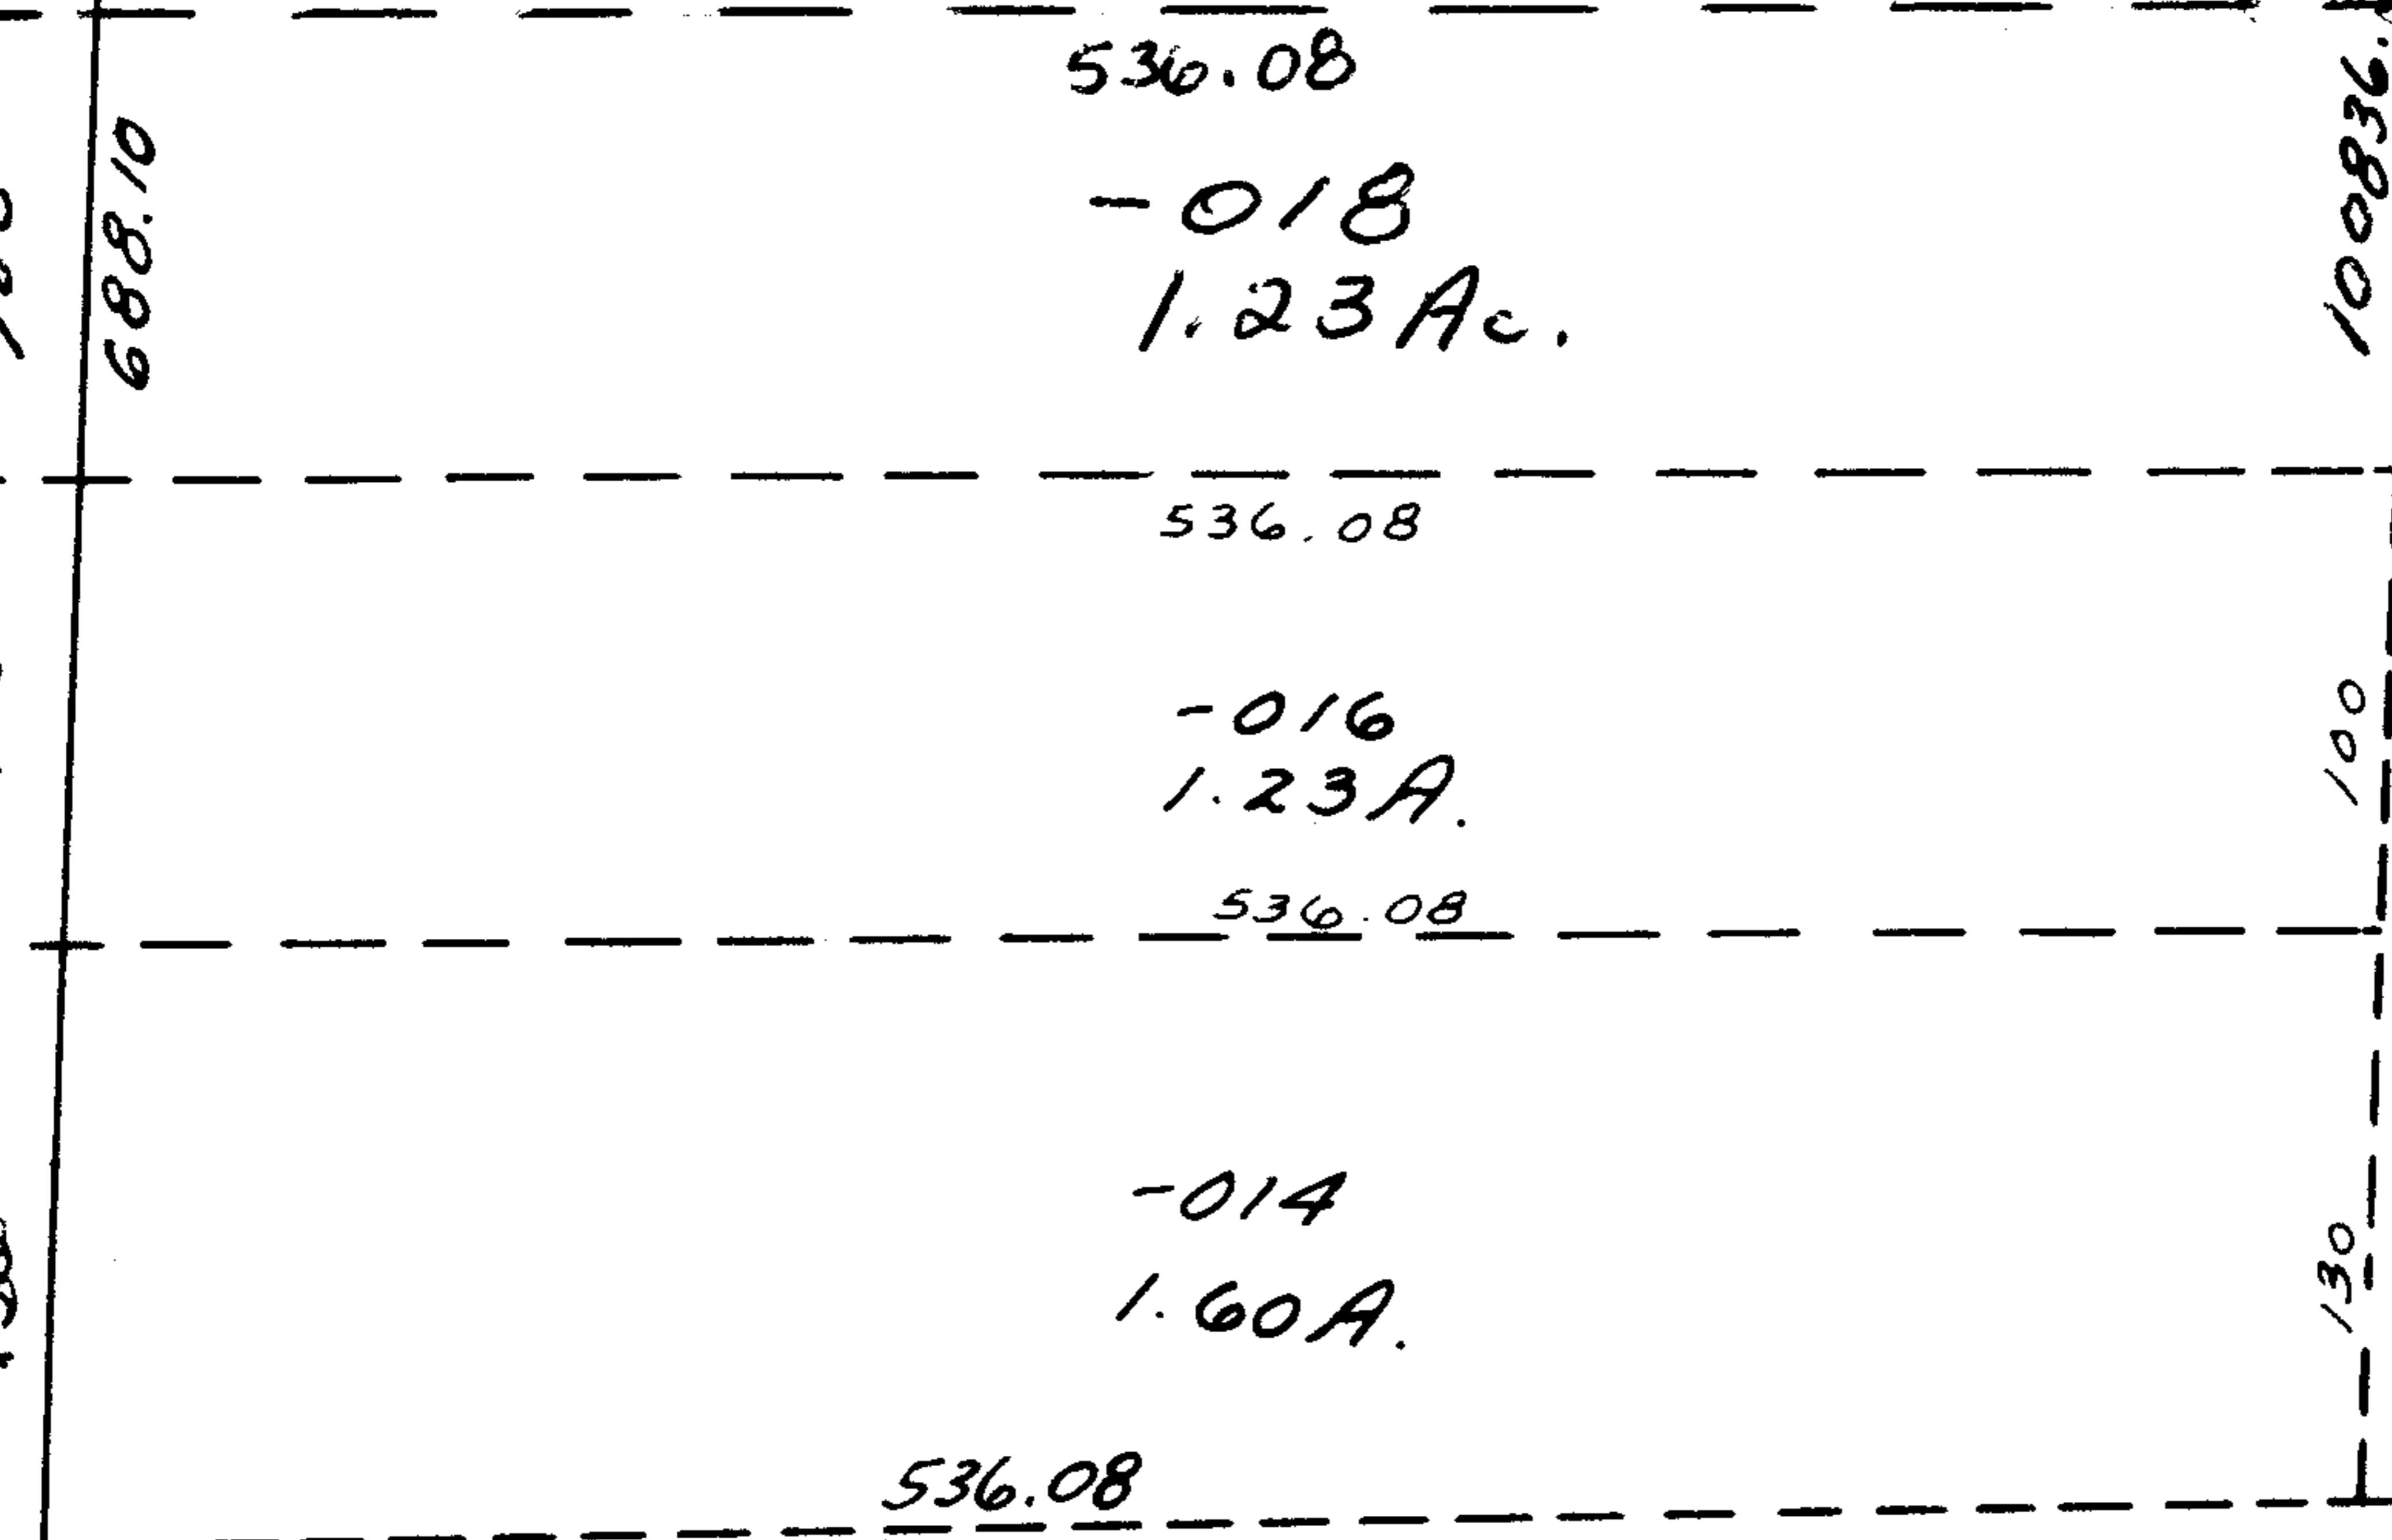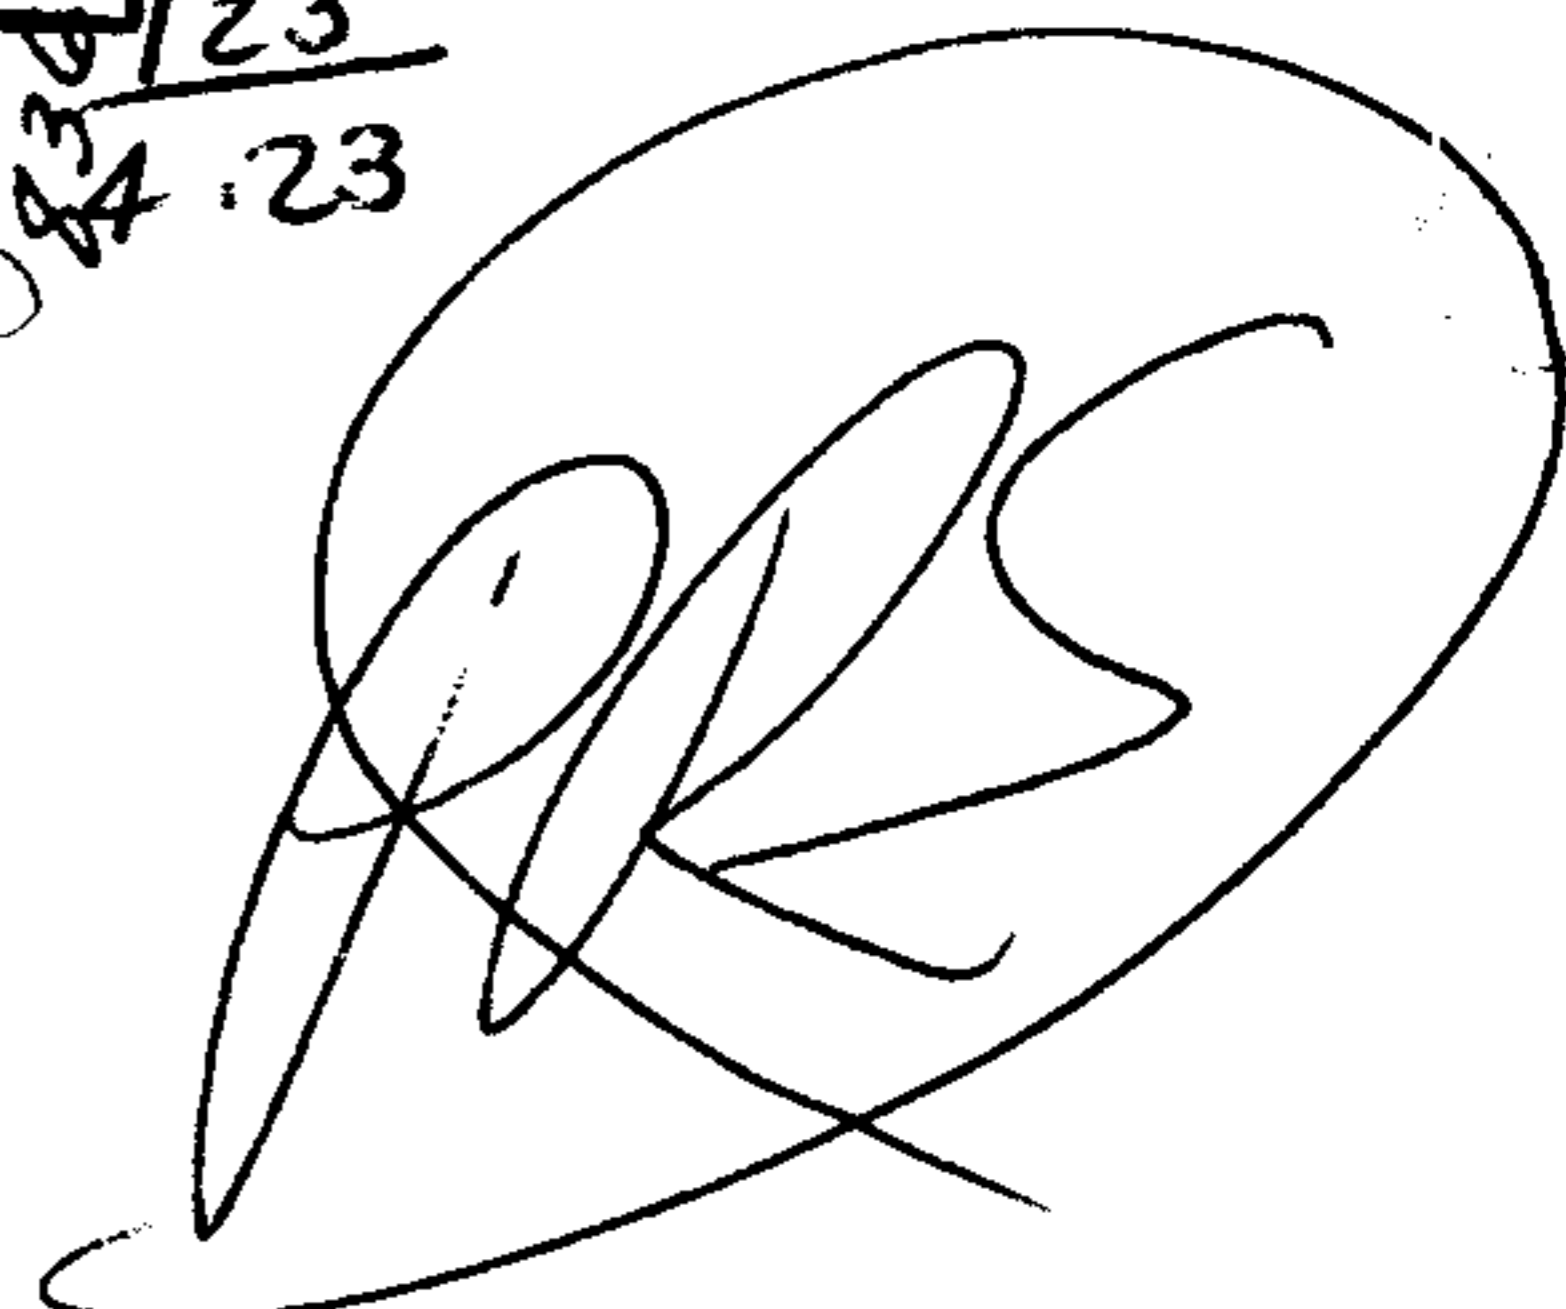

TH AMHERST

9-00-003-B