

6362




972.70

*[Large handwritten signature]*

6362

APPROVED  
 LORAIN CC  
 MAP DEPT.  
 DATE 9-26-72  
 12-00-061B  
 BY L W Hall

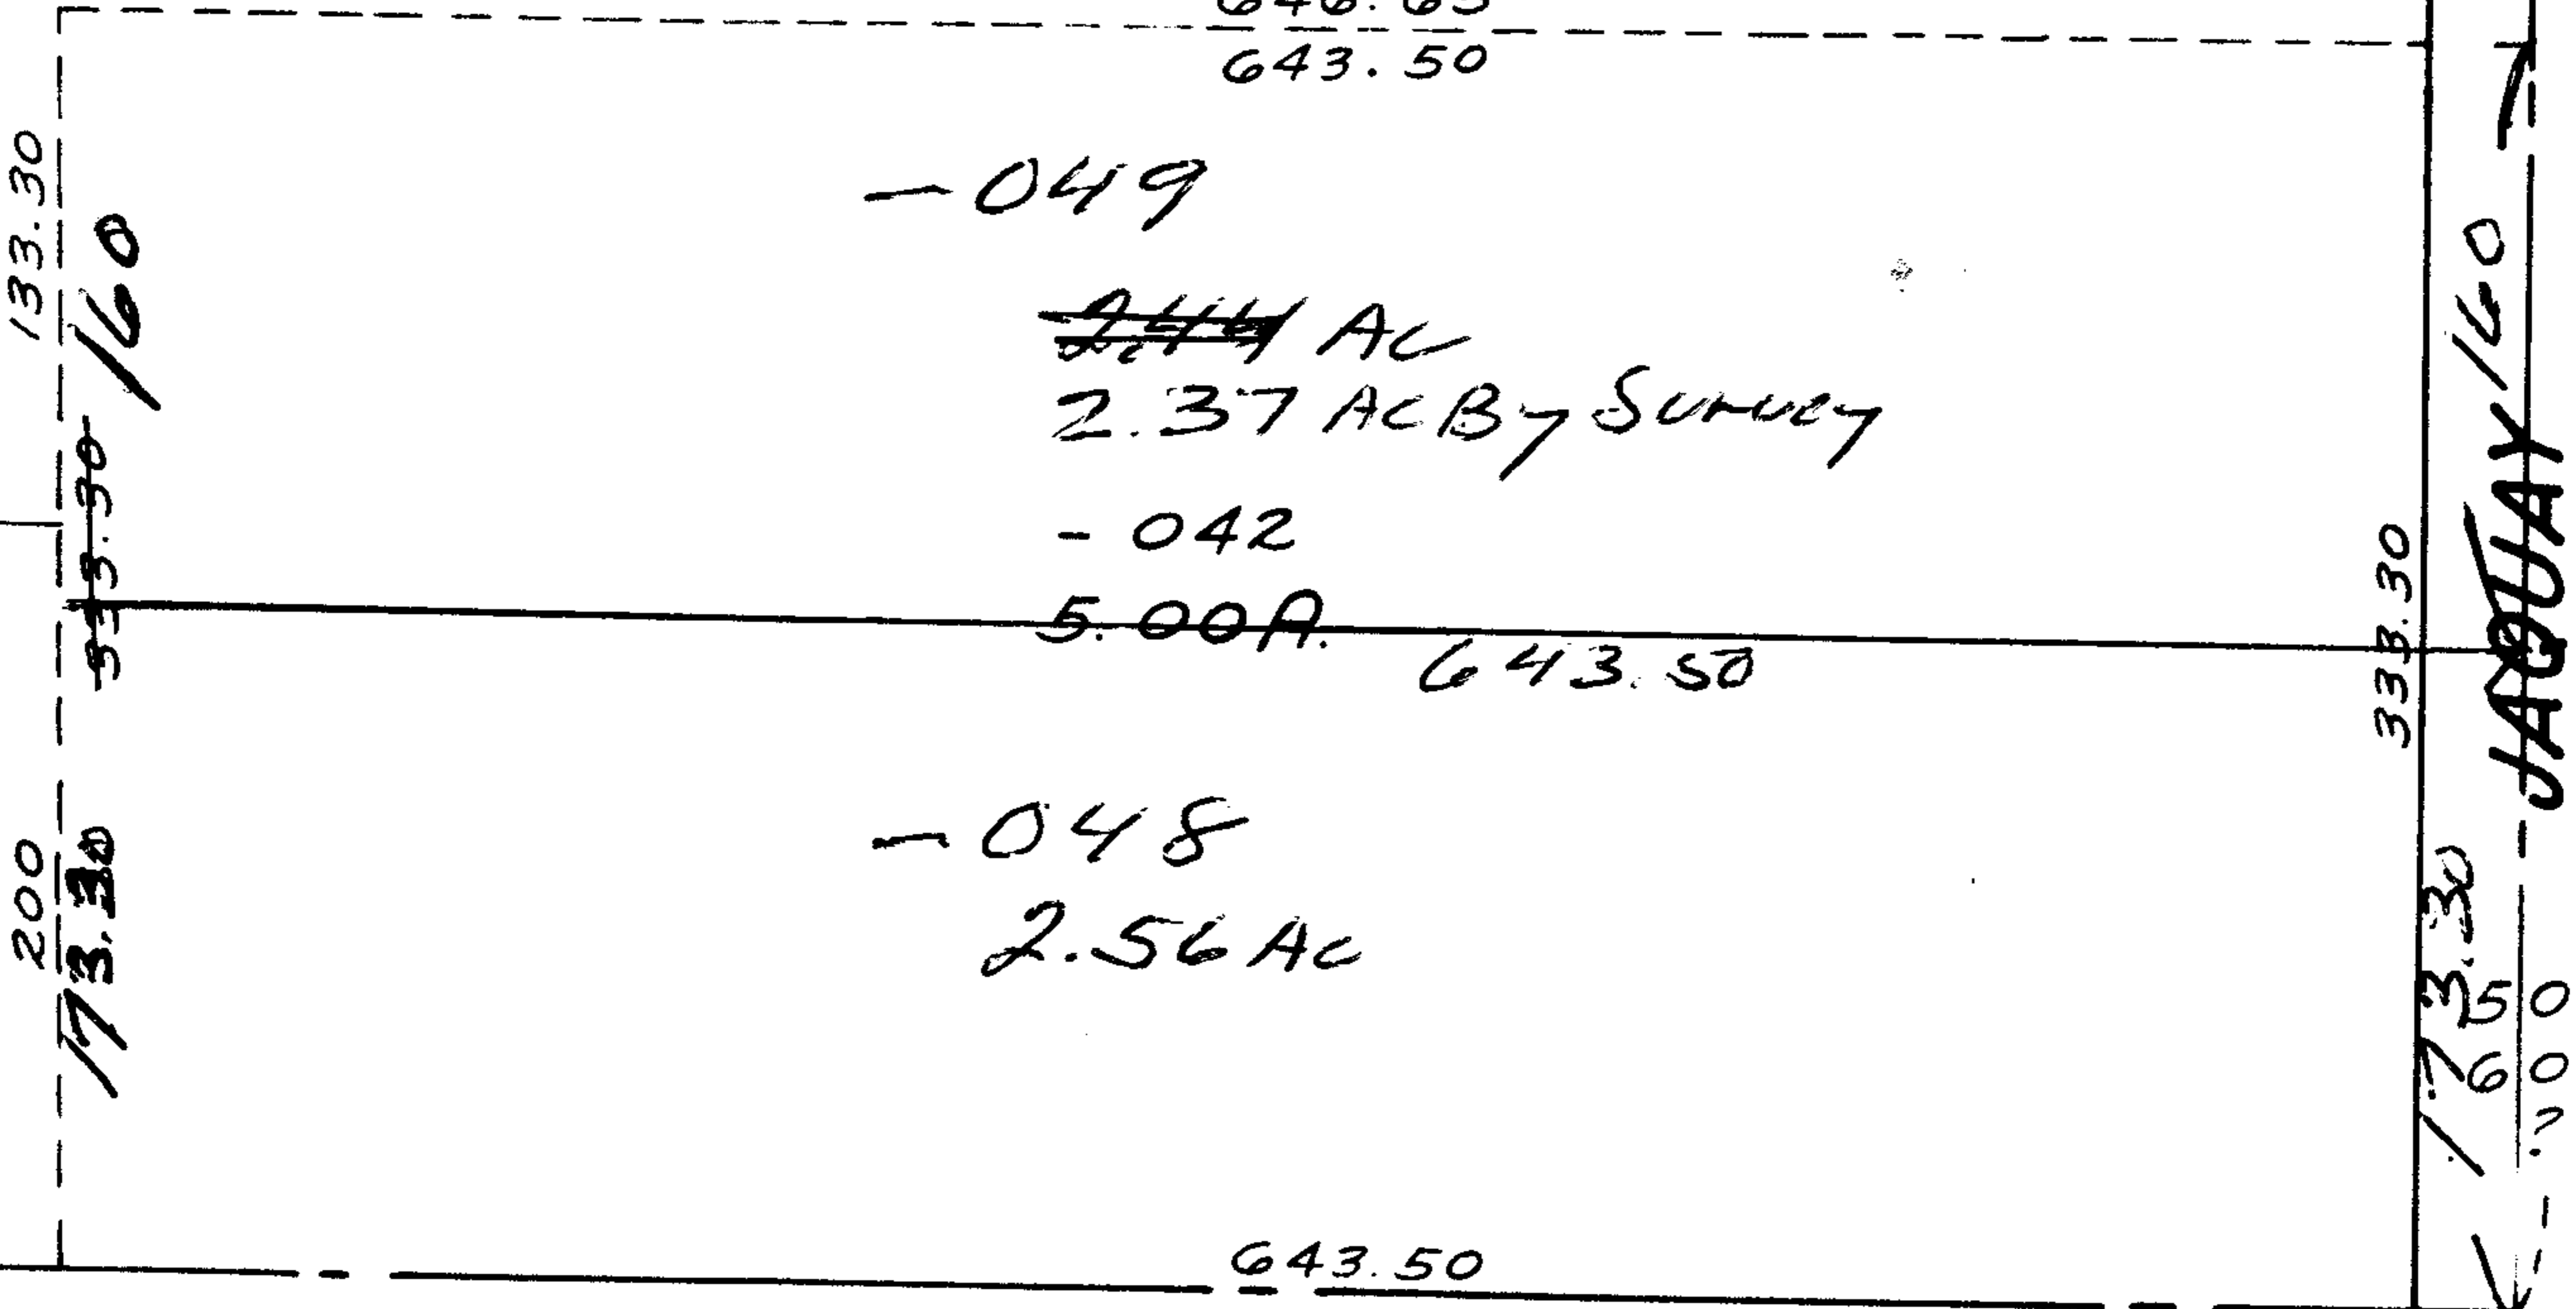

12-00-062-B

12-00-061B

ELY. PT. LOT 61