


6363

SEL

SEE 5-00-082-B

West Ridge 693.72

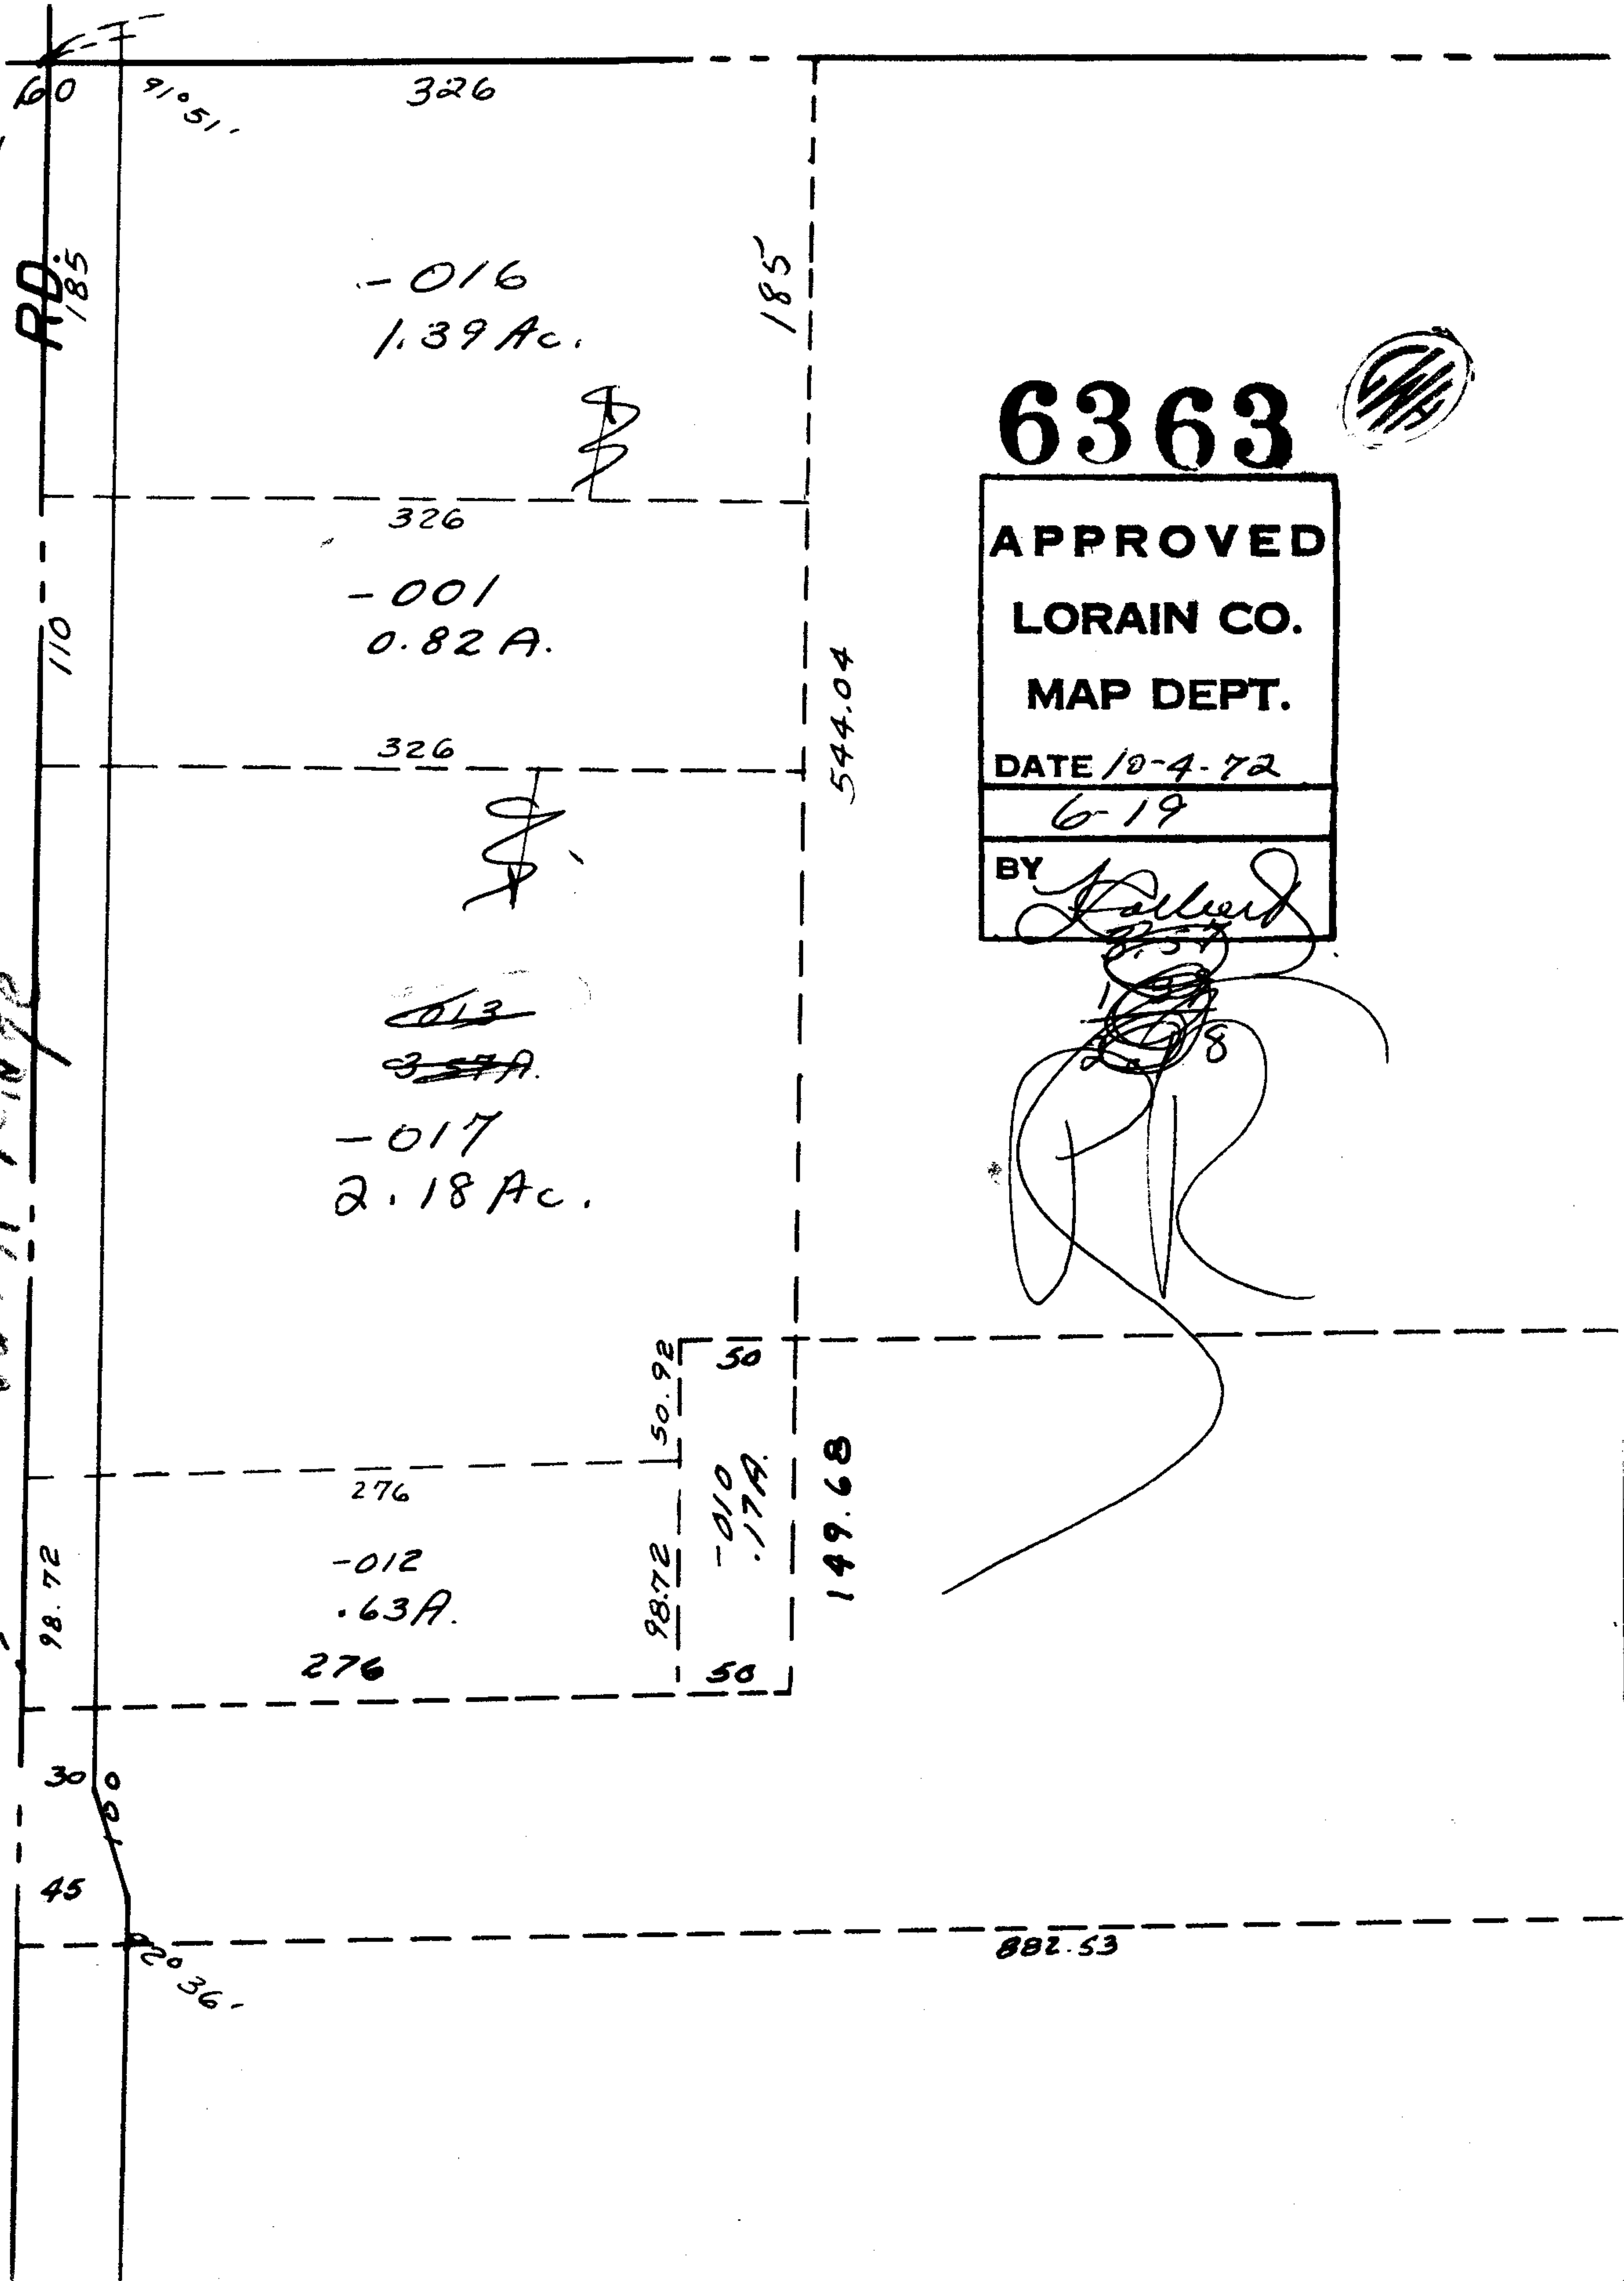

6363

APPROVED
LORAIN CO.
MAP DEPT.

DATE 10-4-72

6-19

BY *Fuller*

Handwritten signature and scribbles