


6365

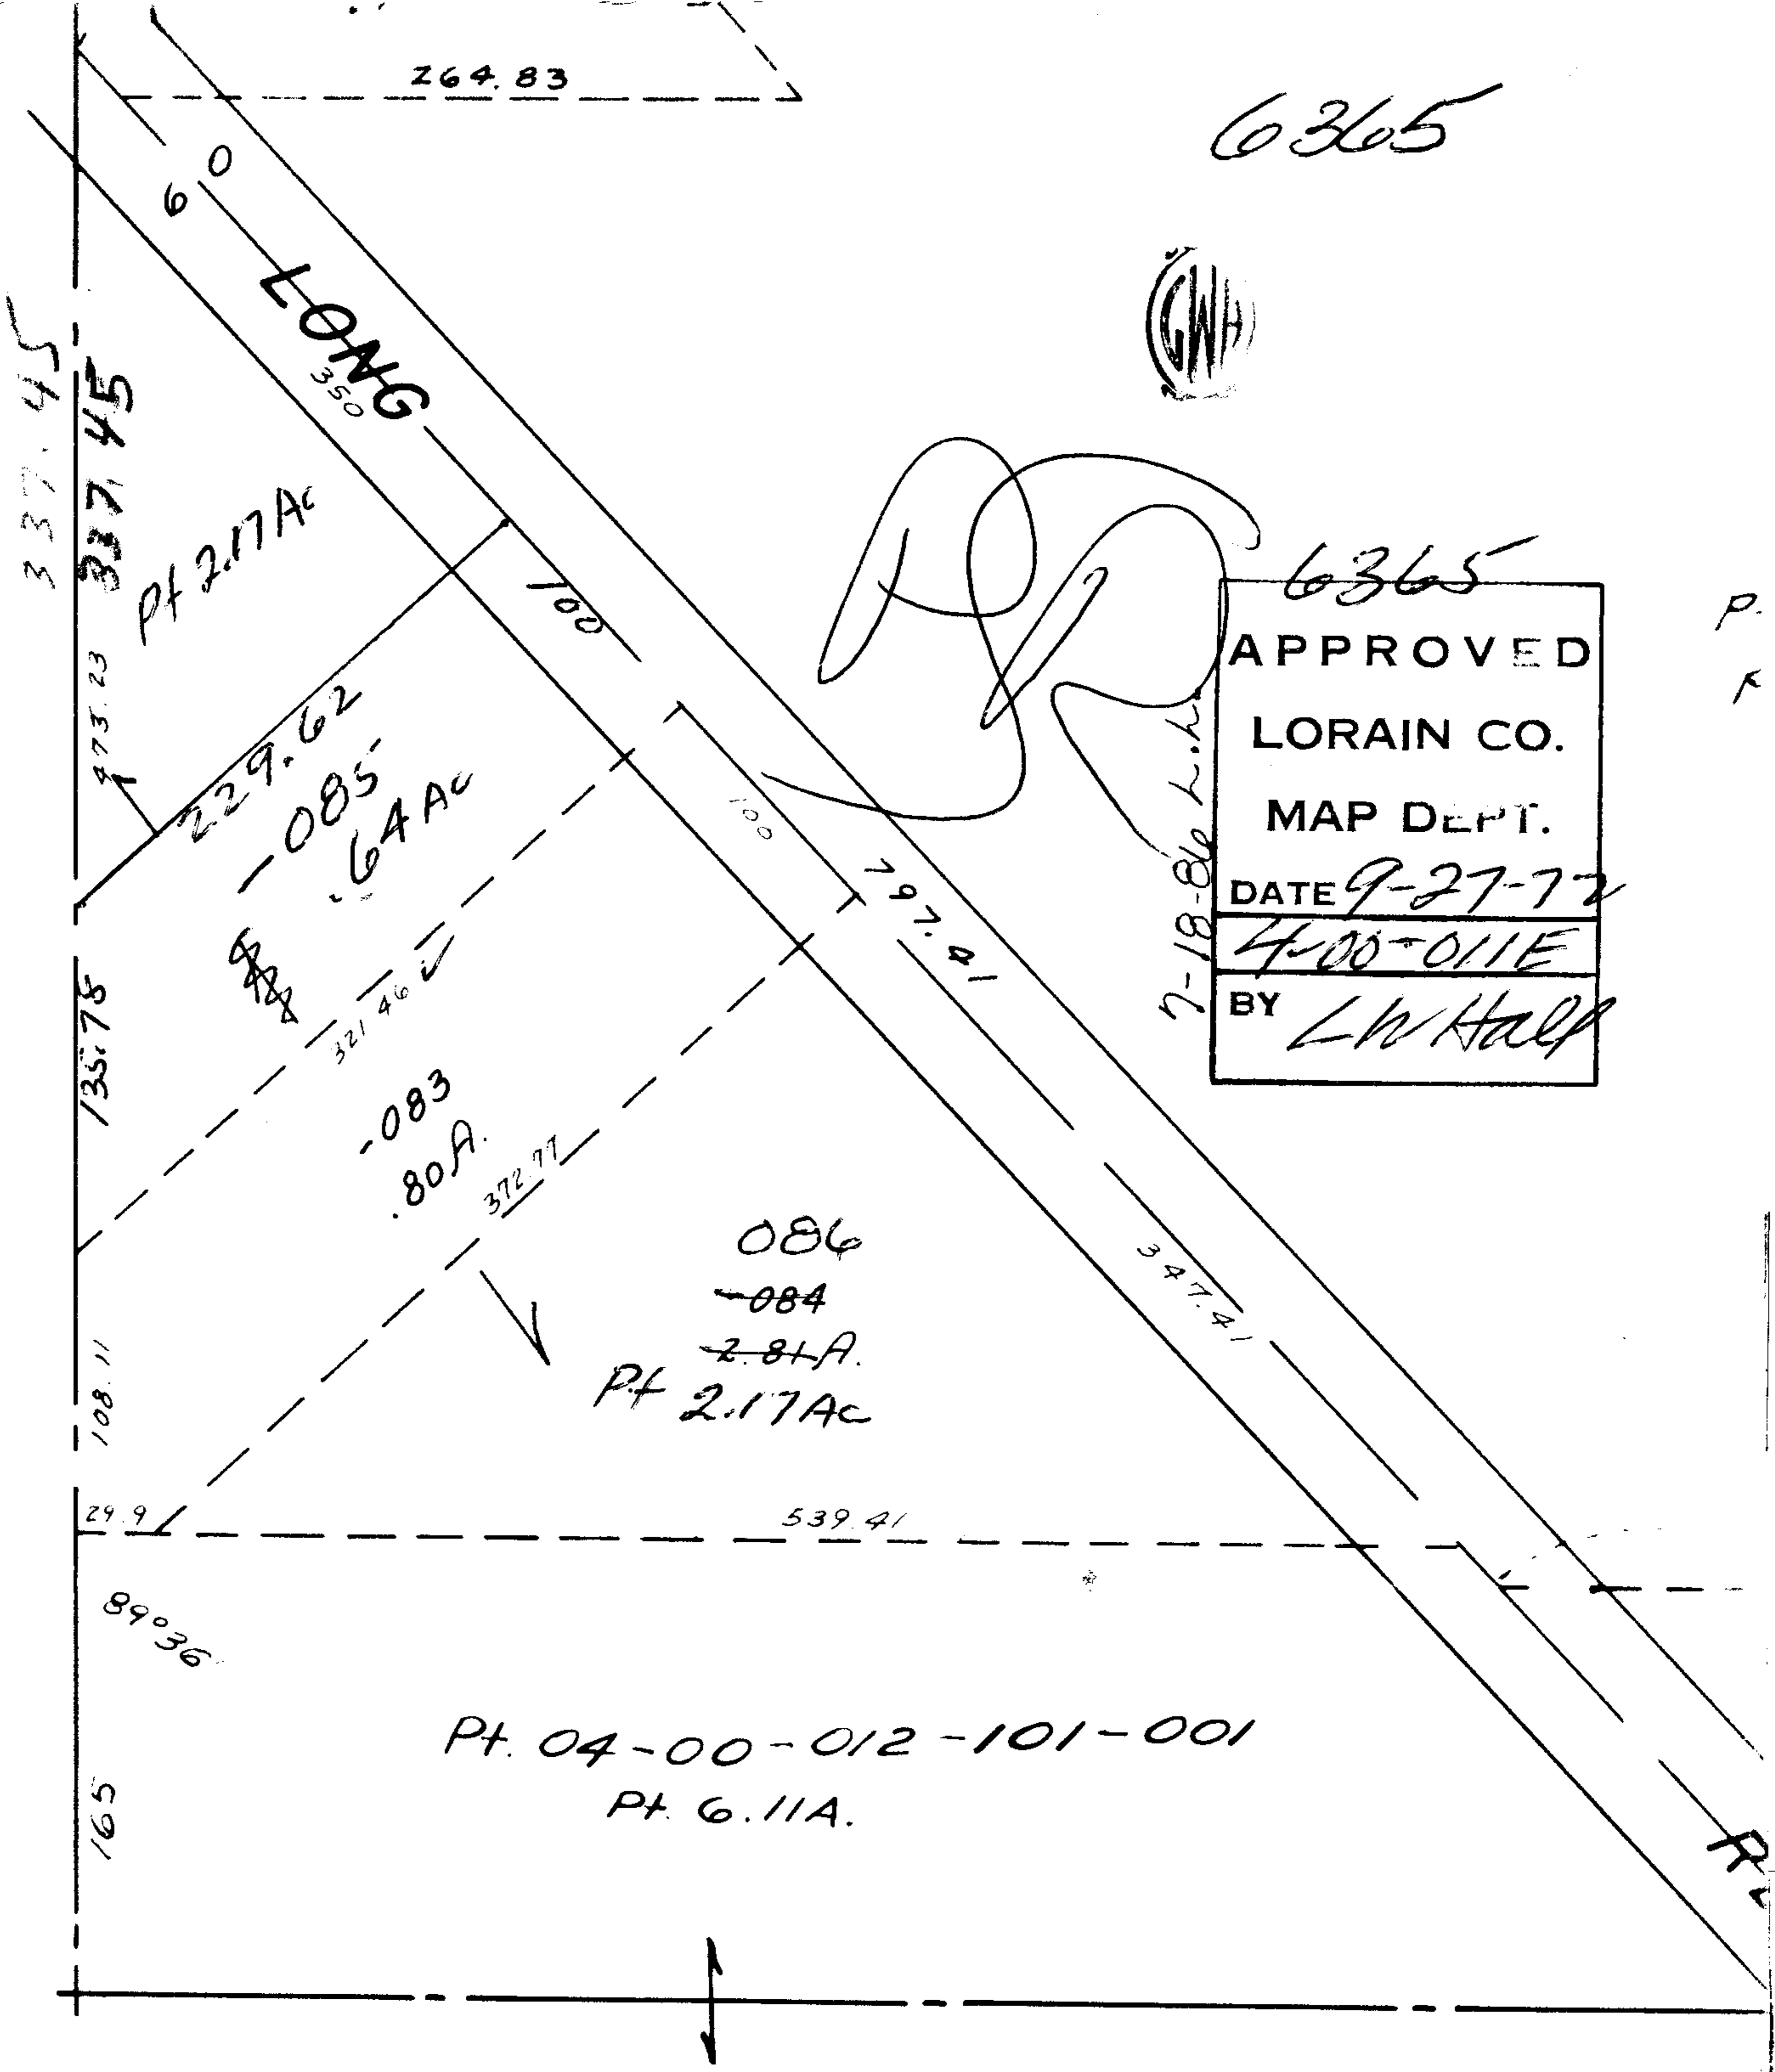

6365  
 APPROVED  
 LORAIN CO.  
 MAP DEPT.  
 DATE 9-27-77  
 4-00-011E  
 BY L.W. HALL

SEE

4-00-011E

# AVON VILLAGE

SCALE: 1" = 100'