

.82A.


359.56

6367




300

R.D. 014-D

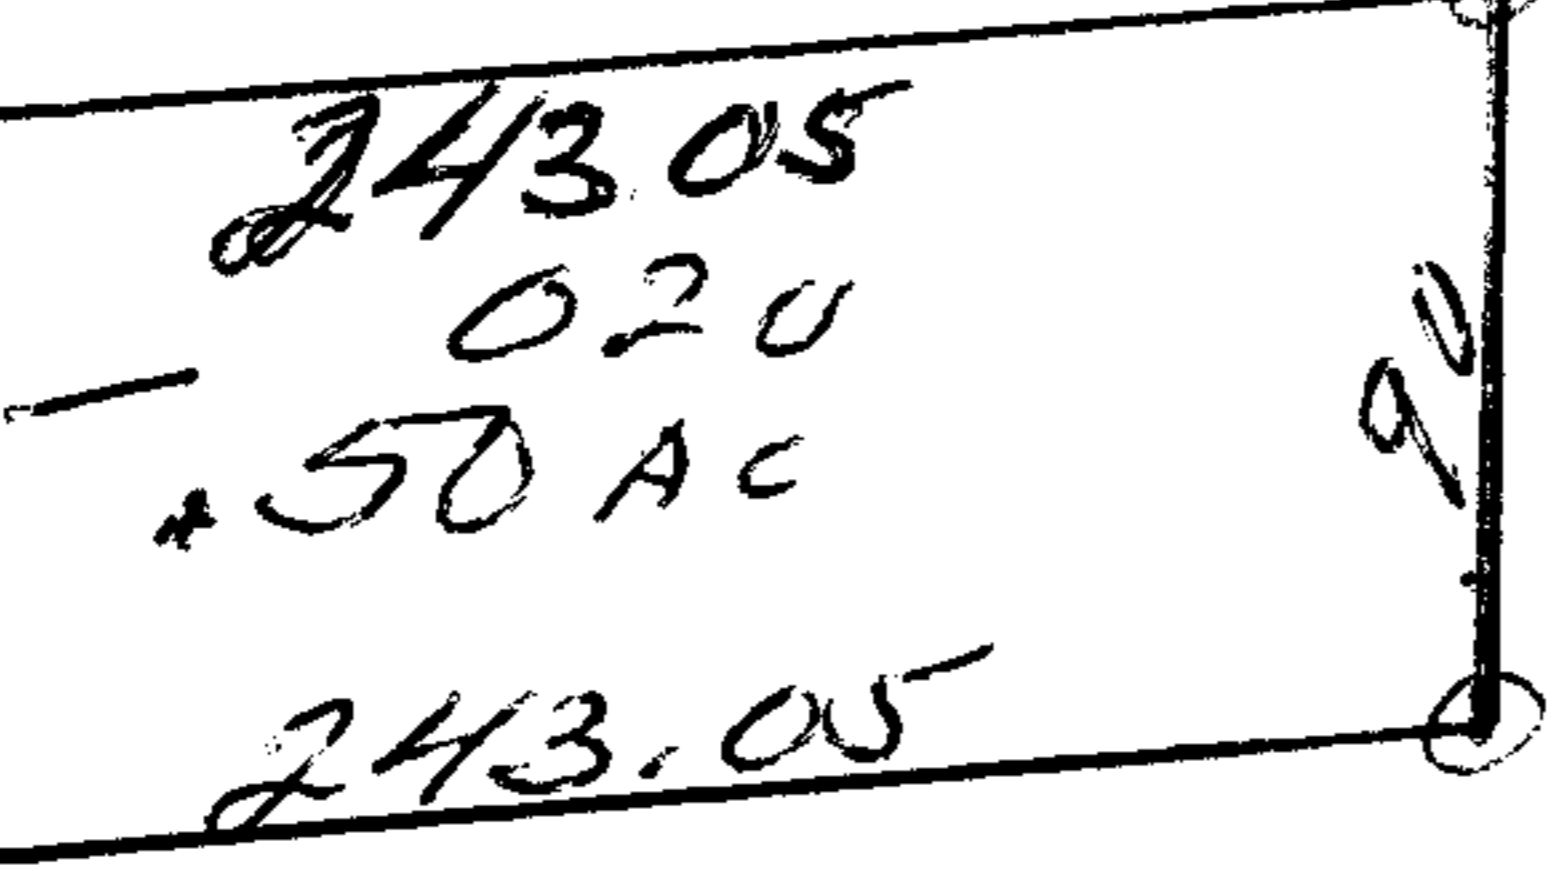


~~020021~~
~~019~~
~~34.30 AC~~
 33.80 AC

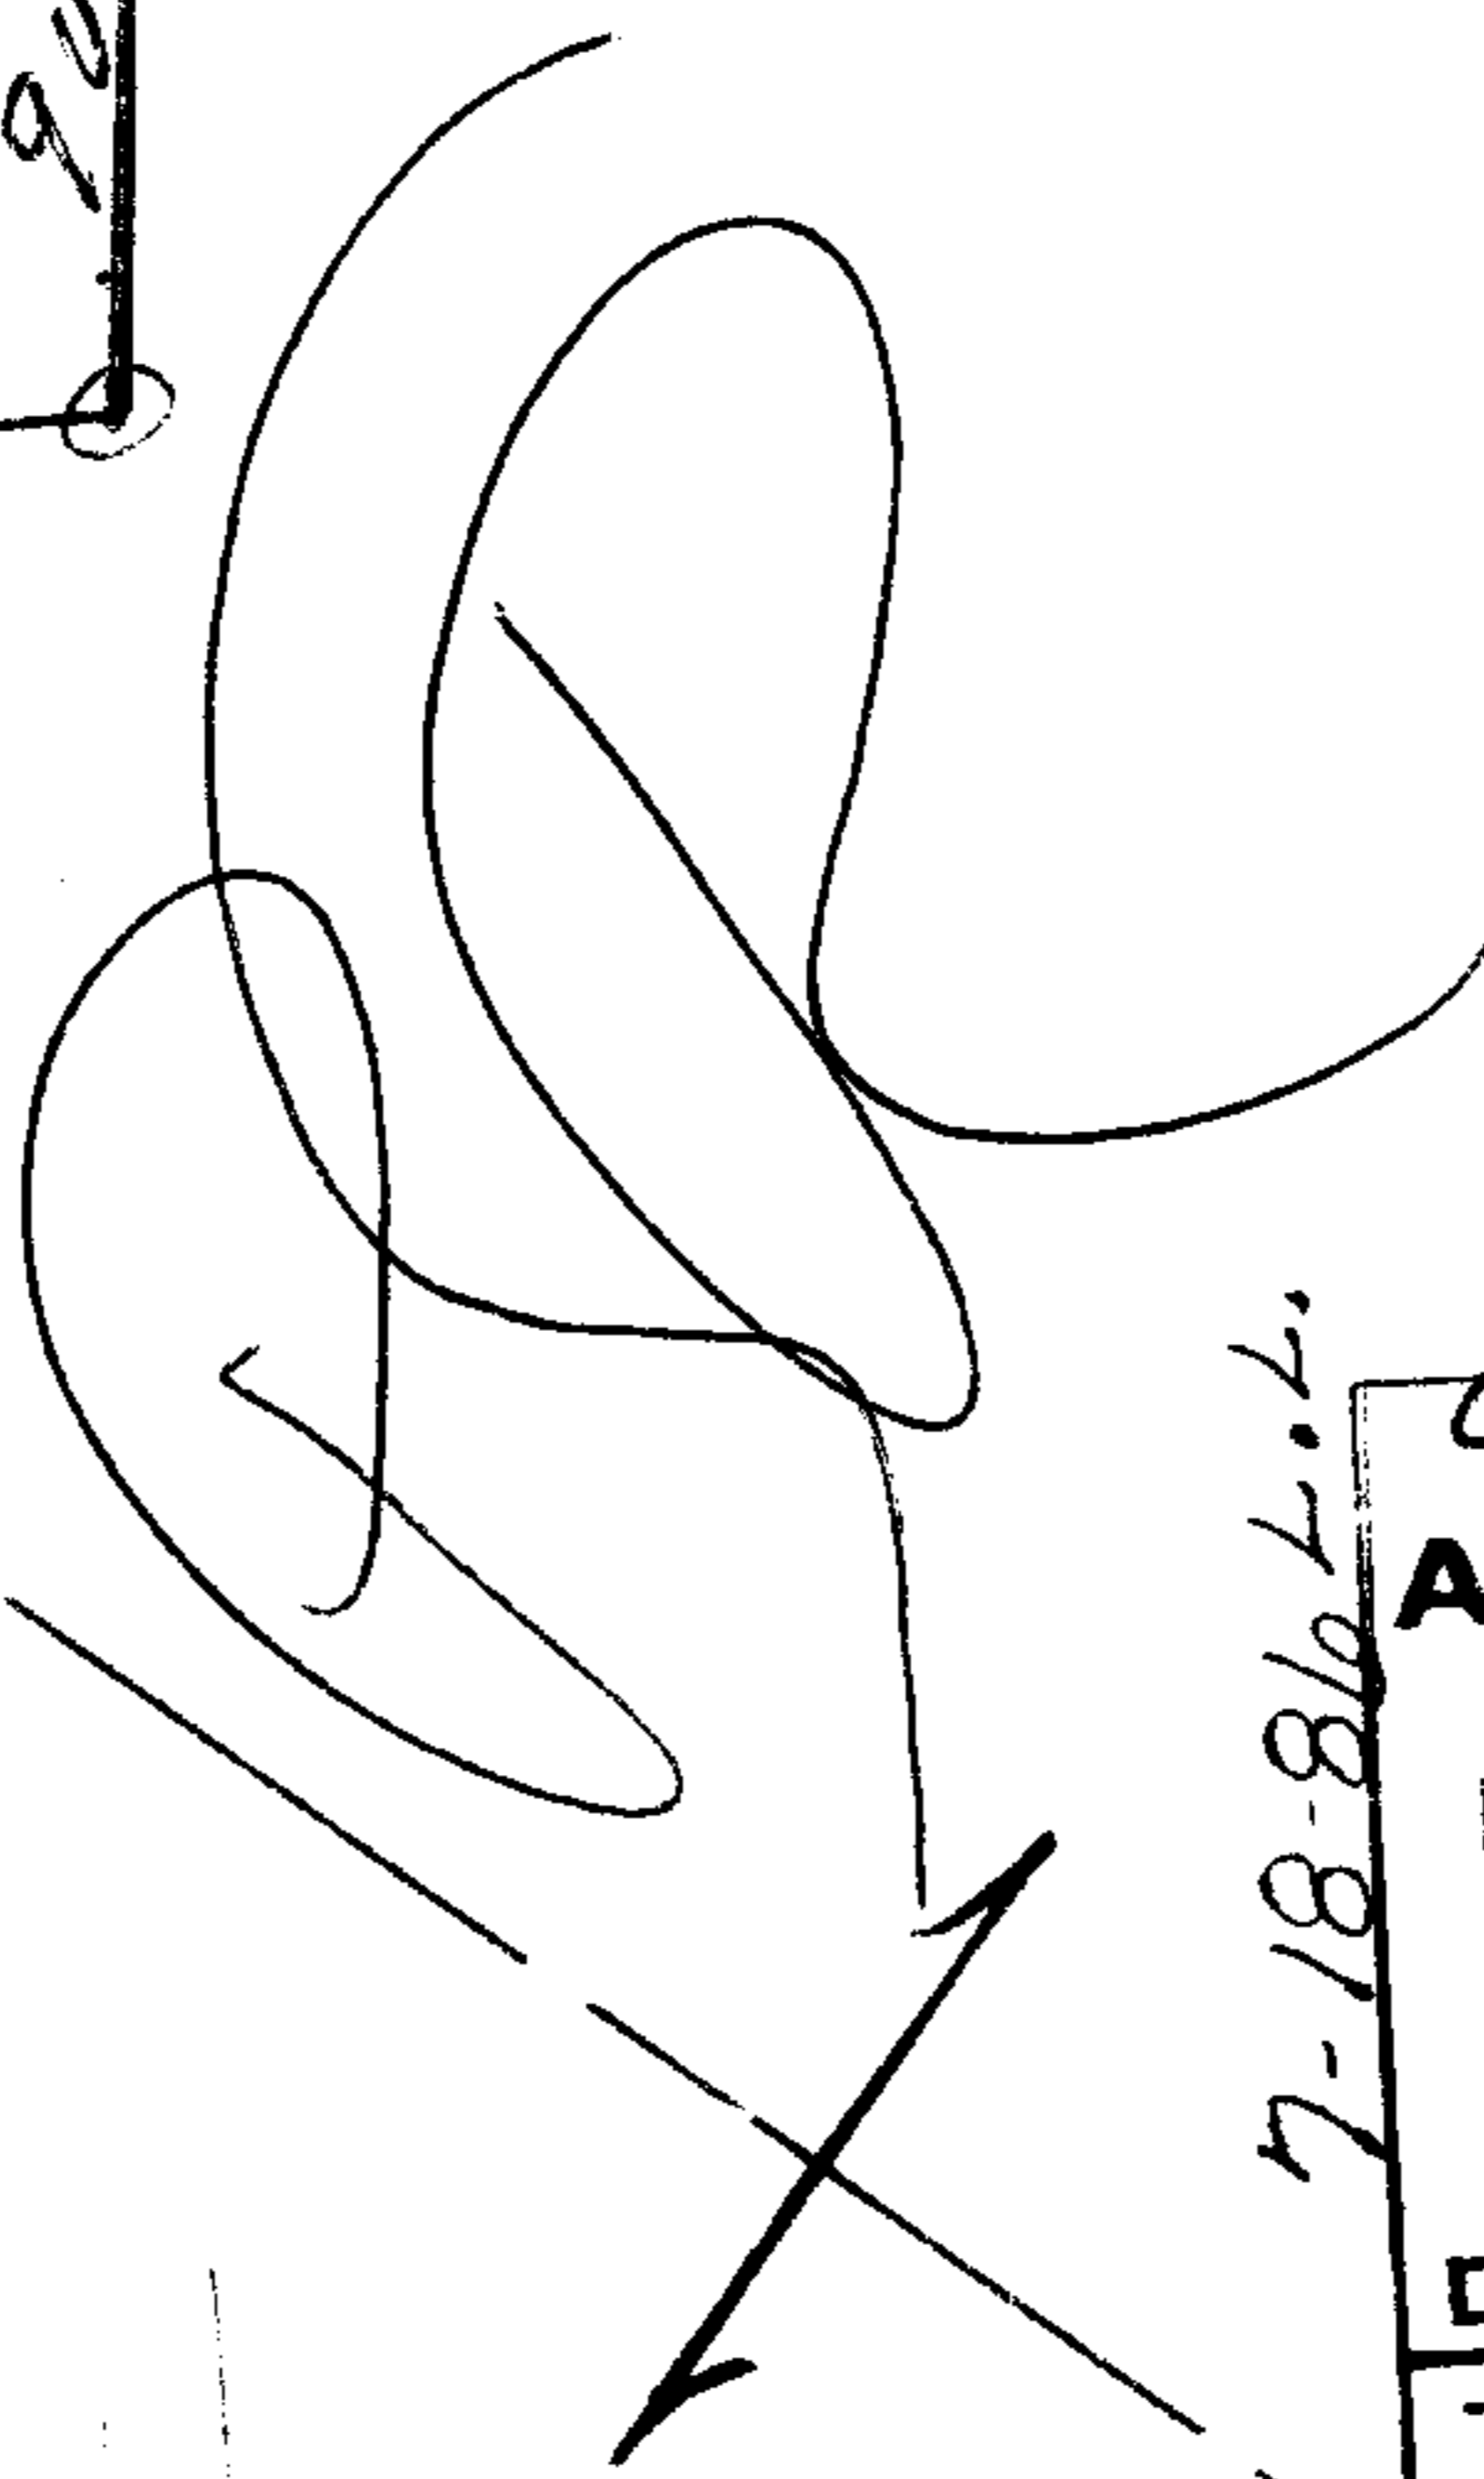

7-18-86 L.L.

6367
 APPROVED
 LORAIN CO.
 MAP DEPT.
 DATE 9-27-86
 7-00-014 B+D
 BY L.W. Hall

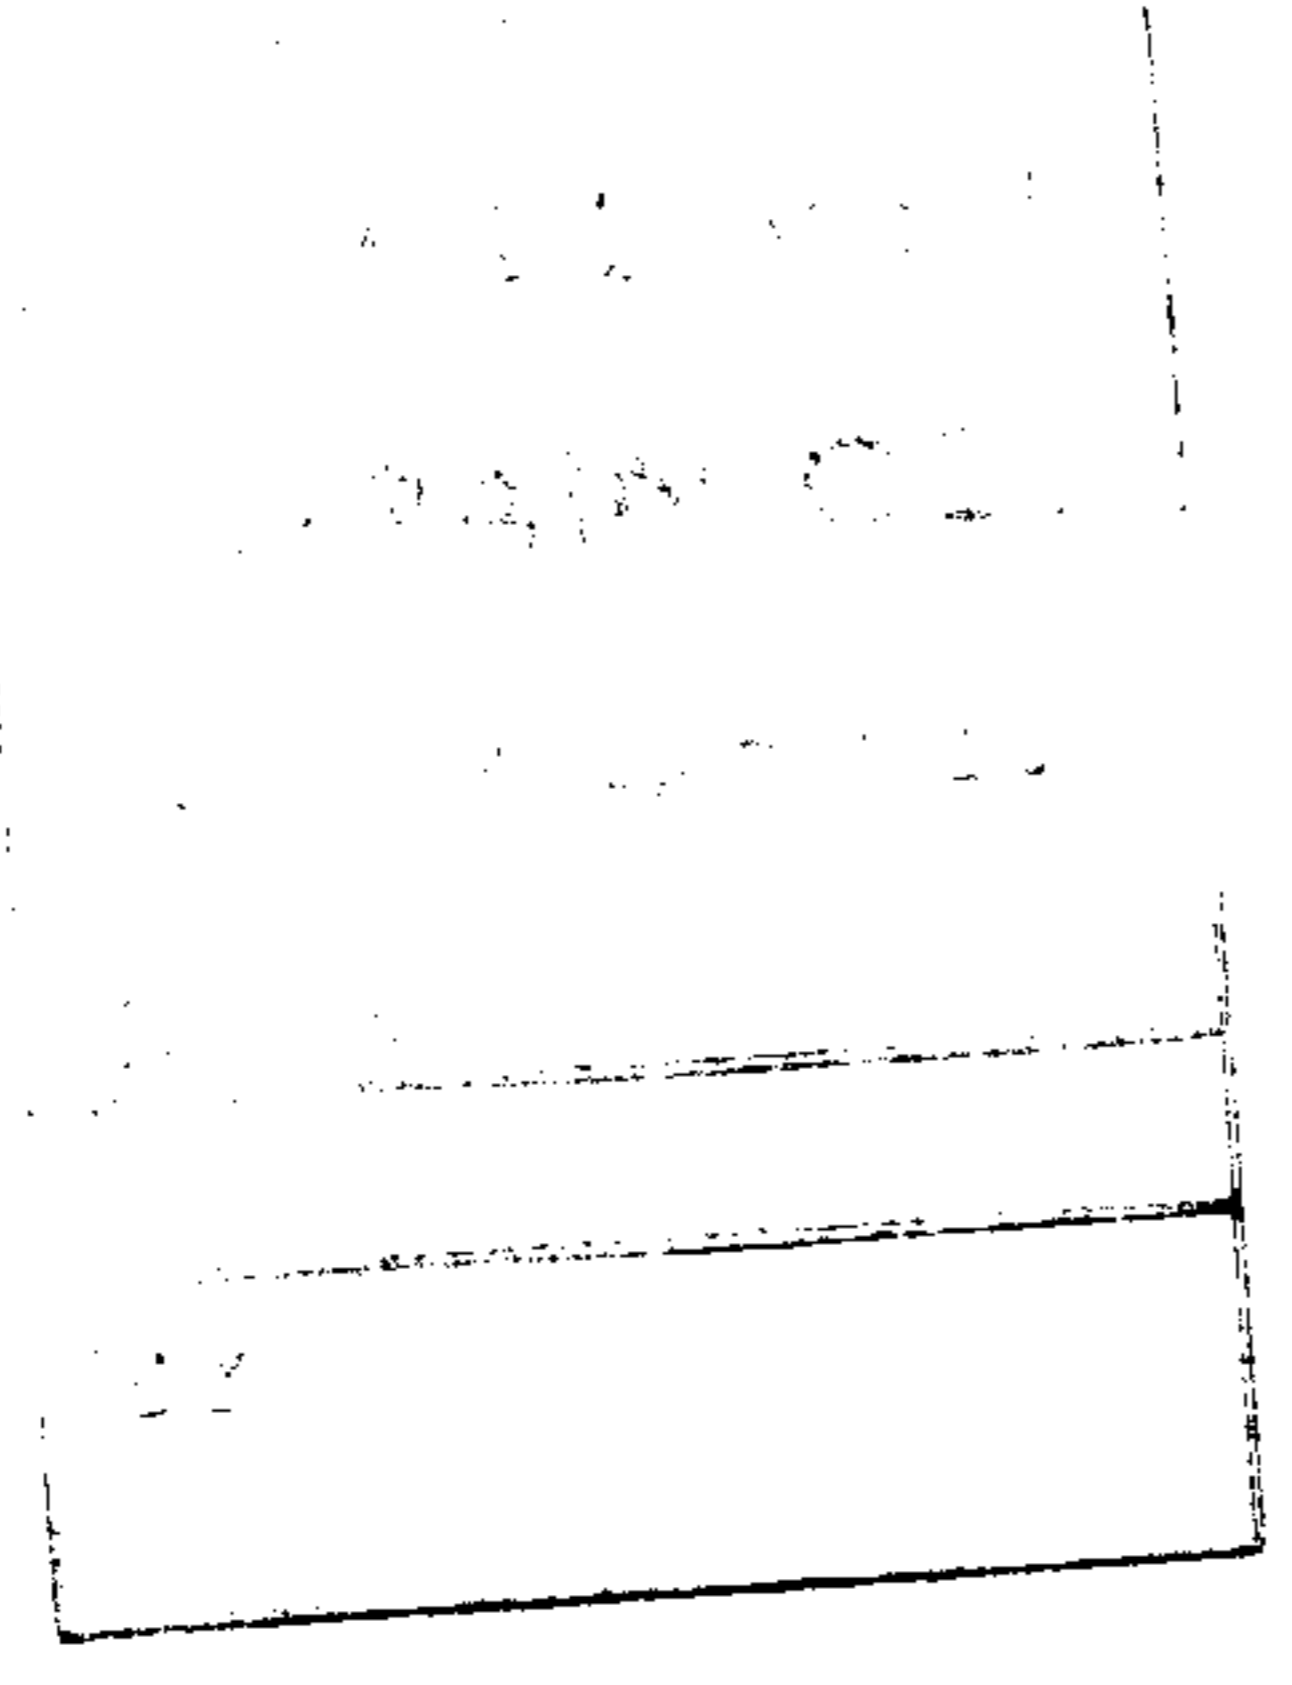

7-00-014-D

Road Rd

615, 83

Butterket Ridge Rd

7-00-014 B

BUTTE