


63 ~~88~~ - 508

22



To Fred Tm Co Sr  
187.75  
187.75  
To Fred Tm Co Jr

# NEW LONDON - EASTERN

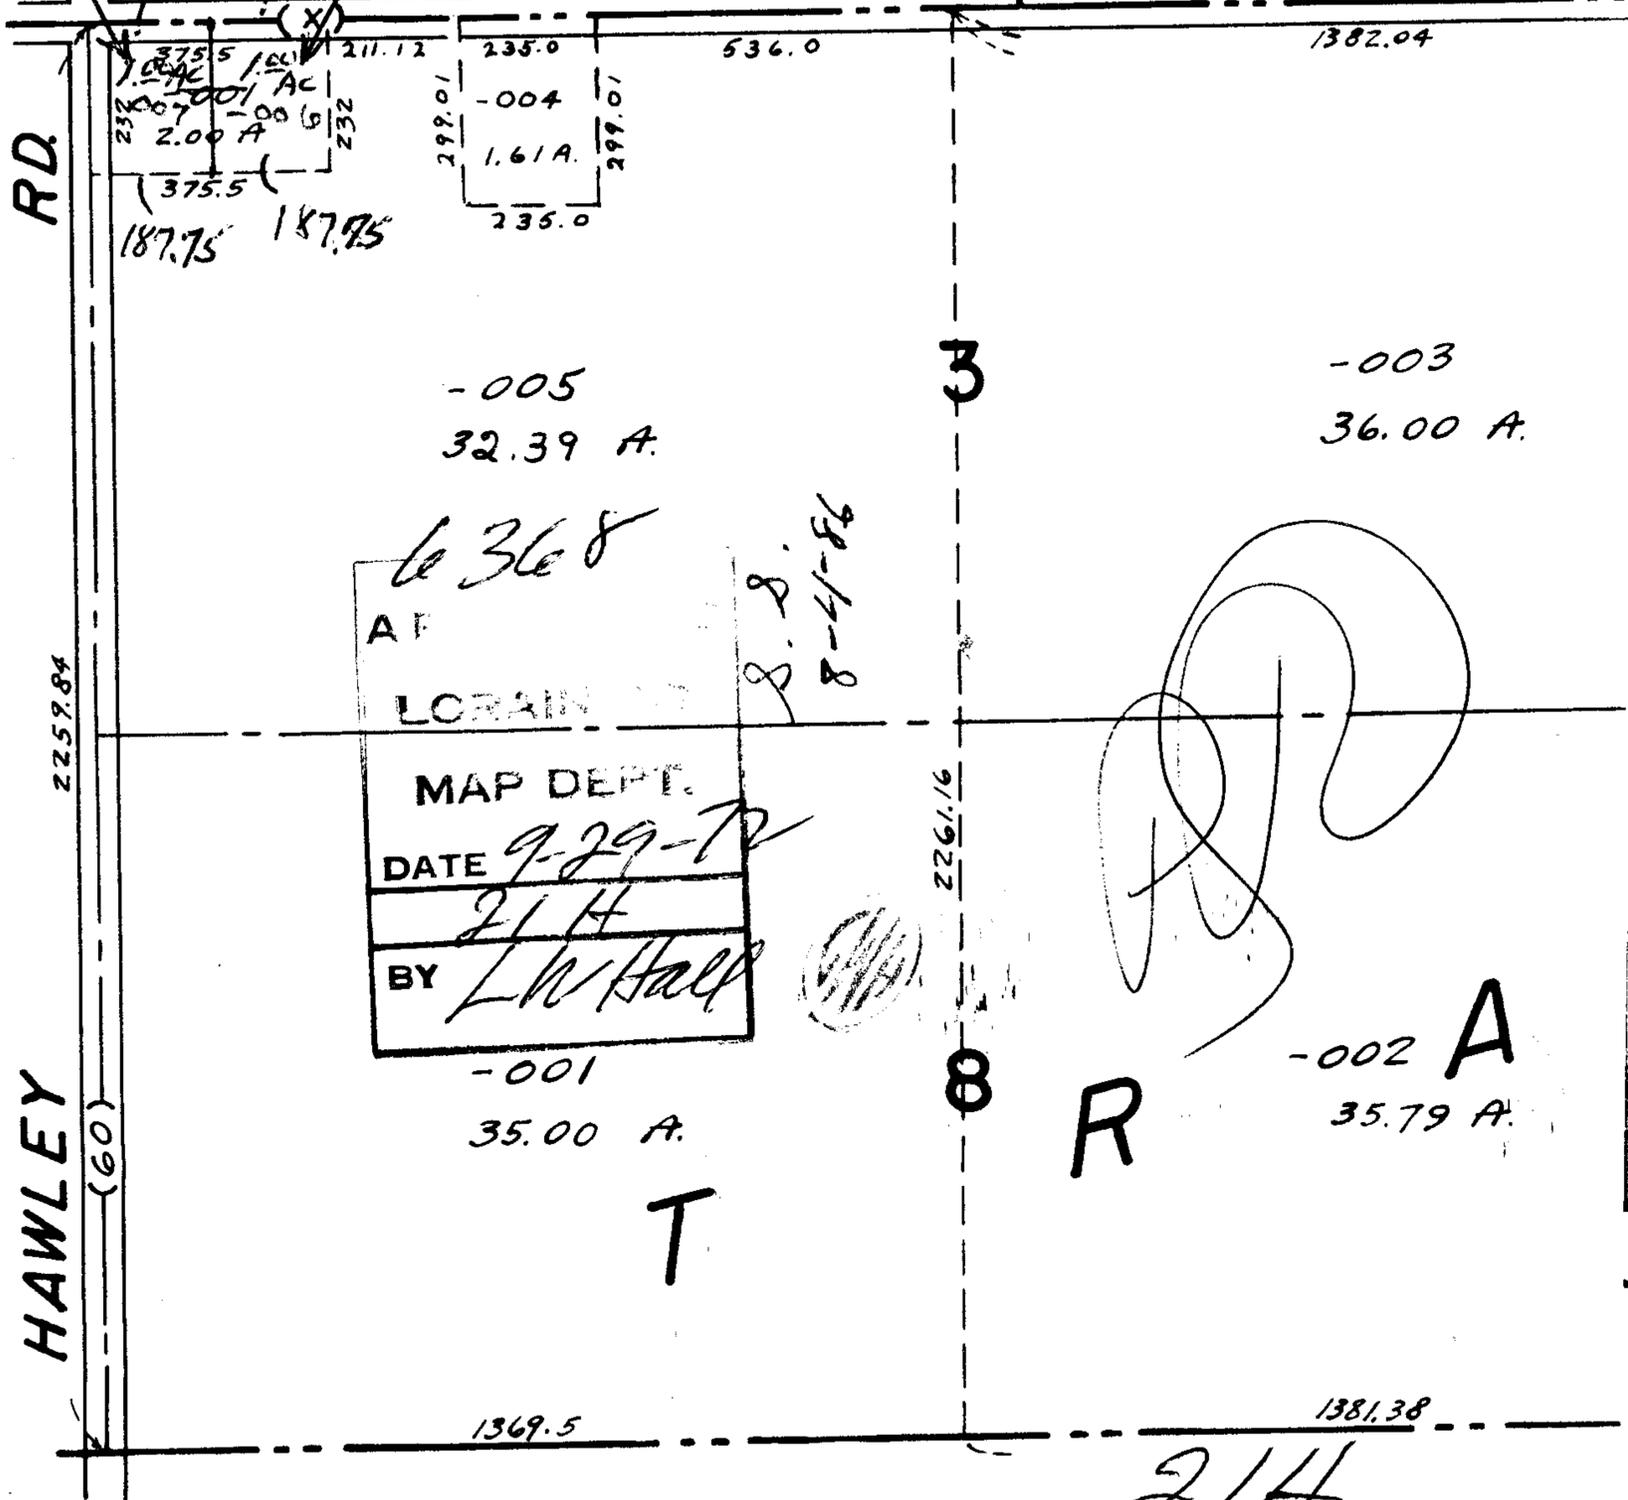

# HUNTINGTON TW

SCALE: 1" = 400'