



132
24
108

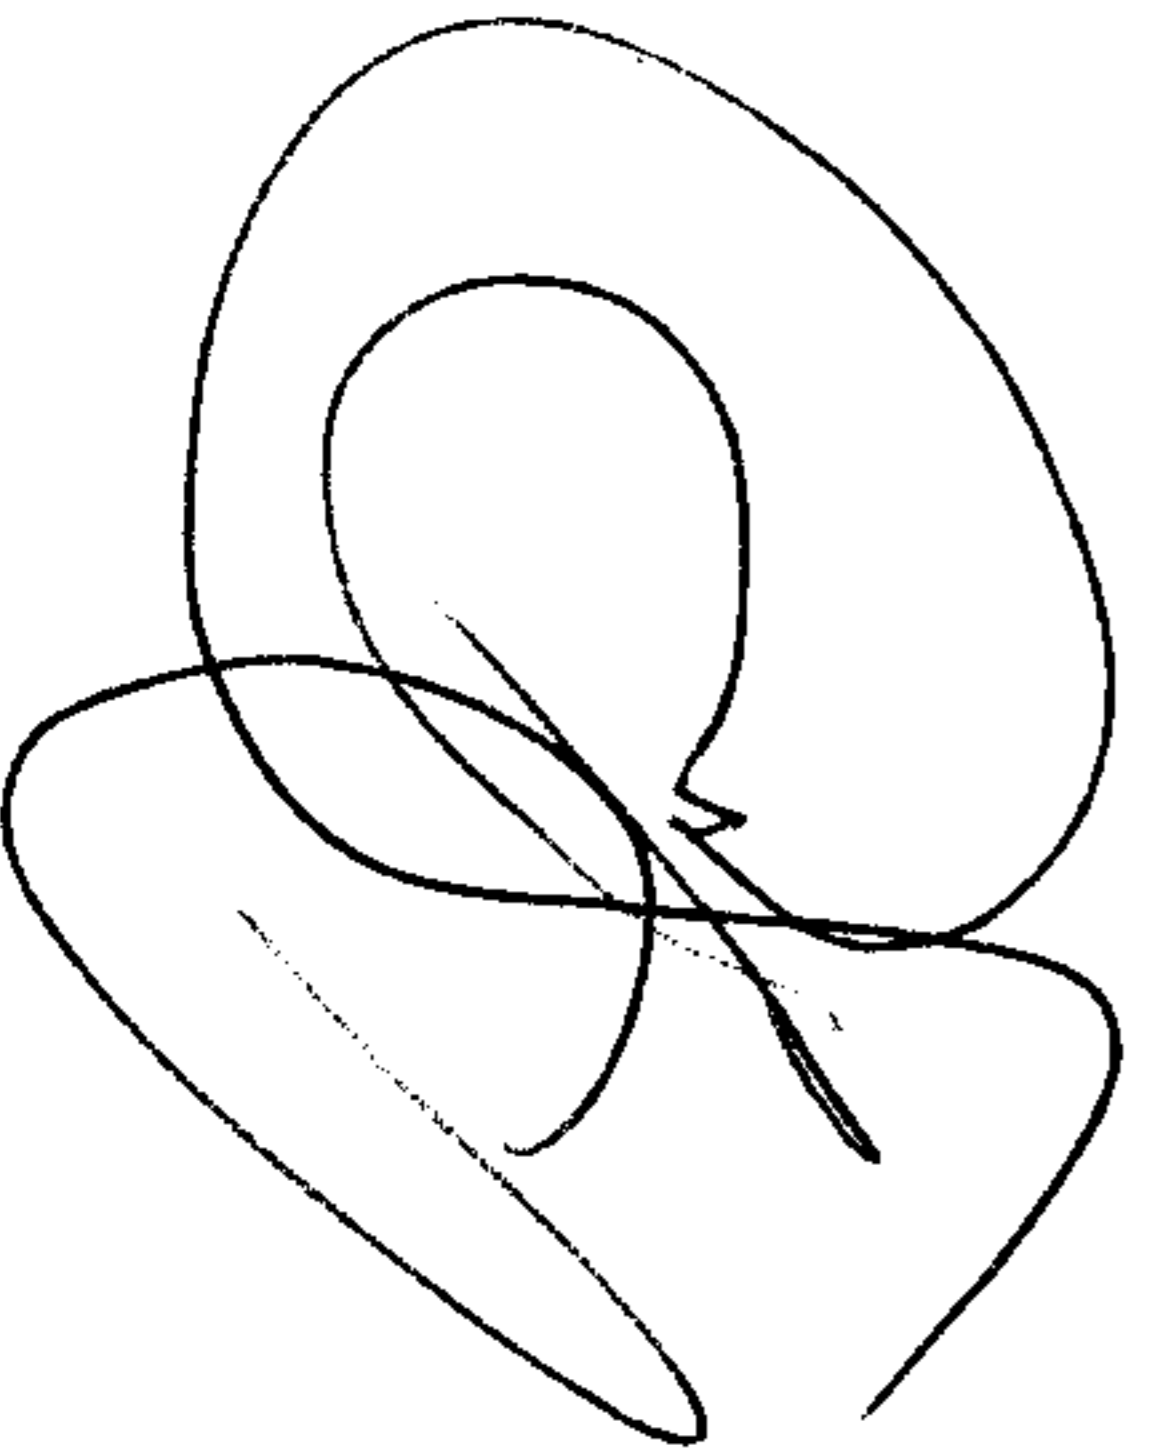

6372
APPROVED
LORAIN CO.
MAP DEPT.
DATE 9-29-72
18-00-021D
BY F.W. Hall

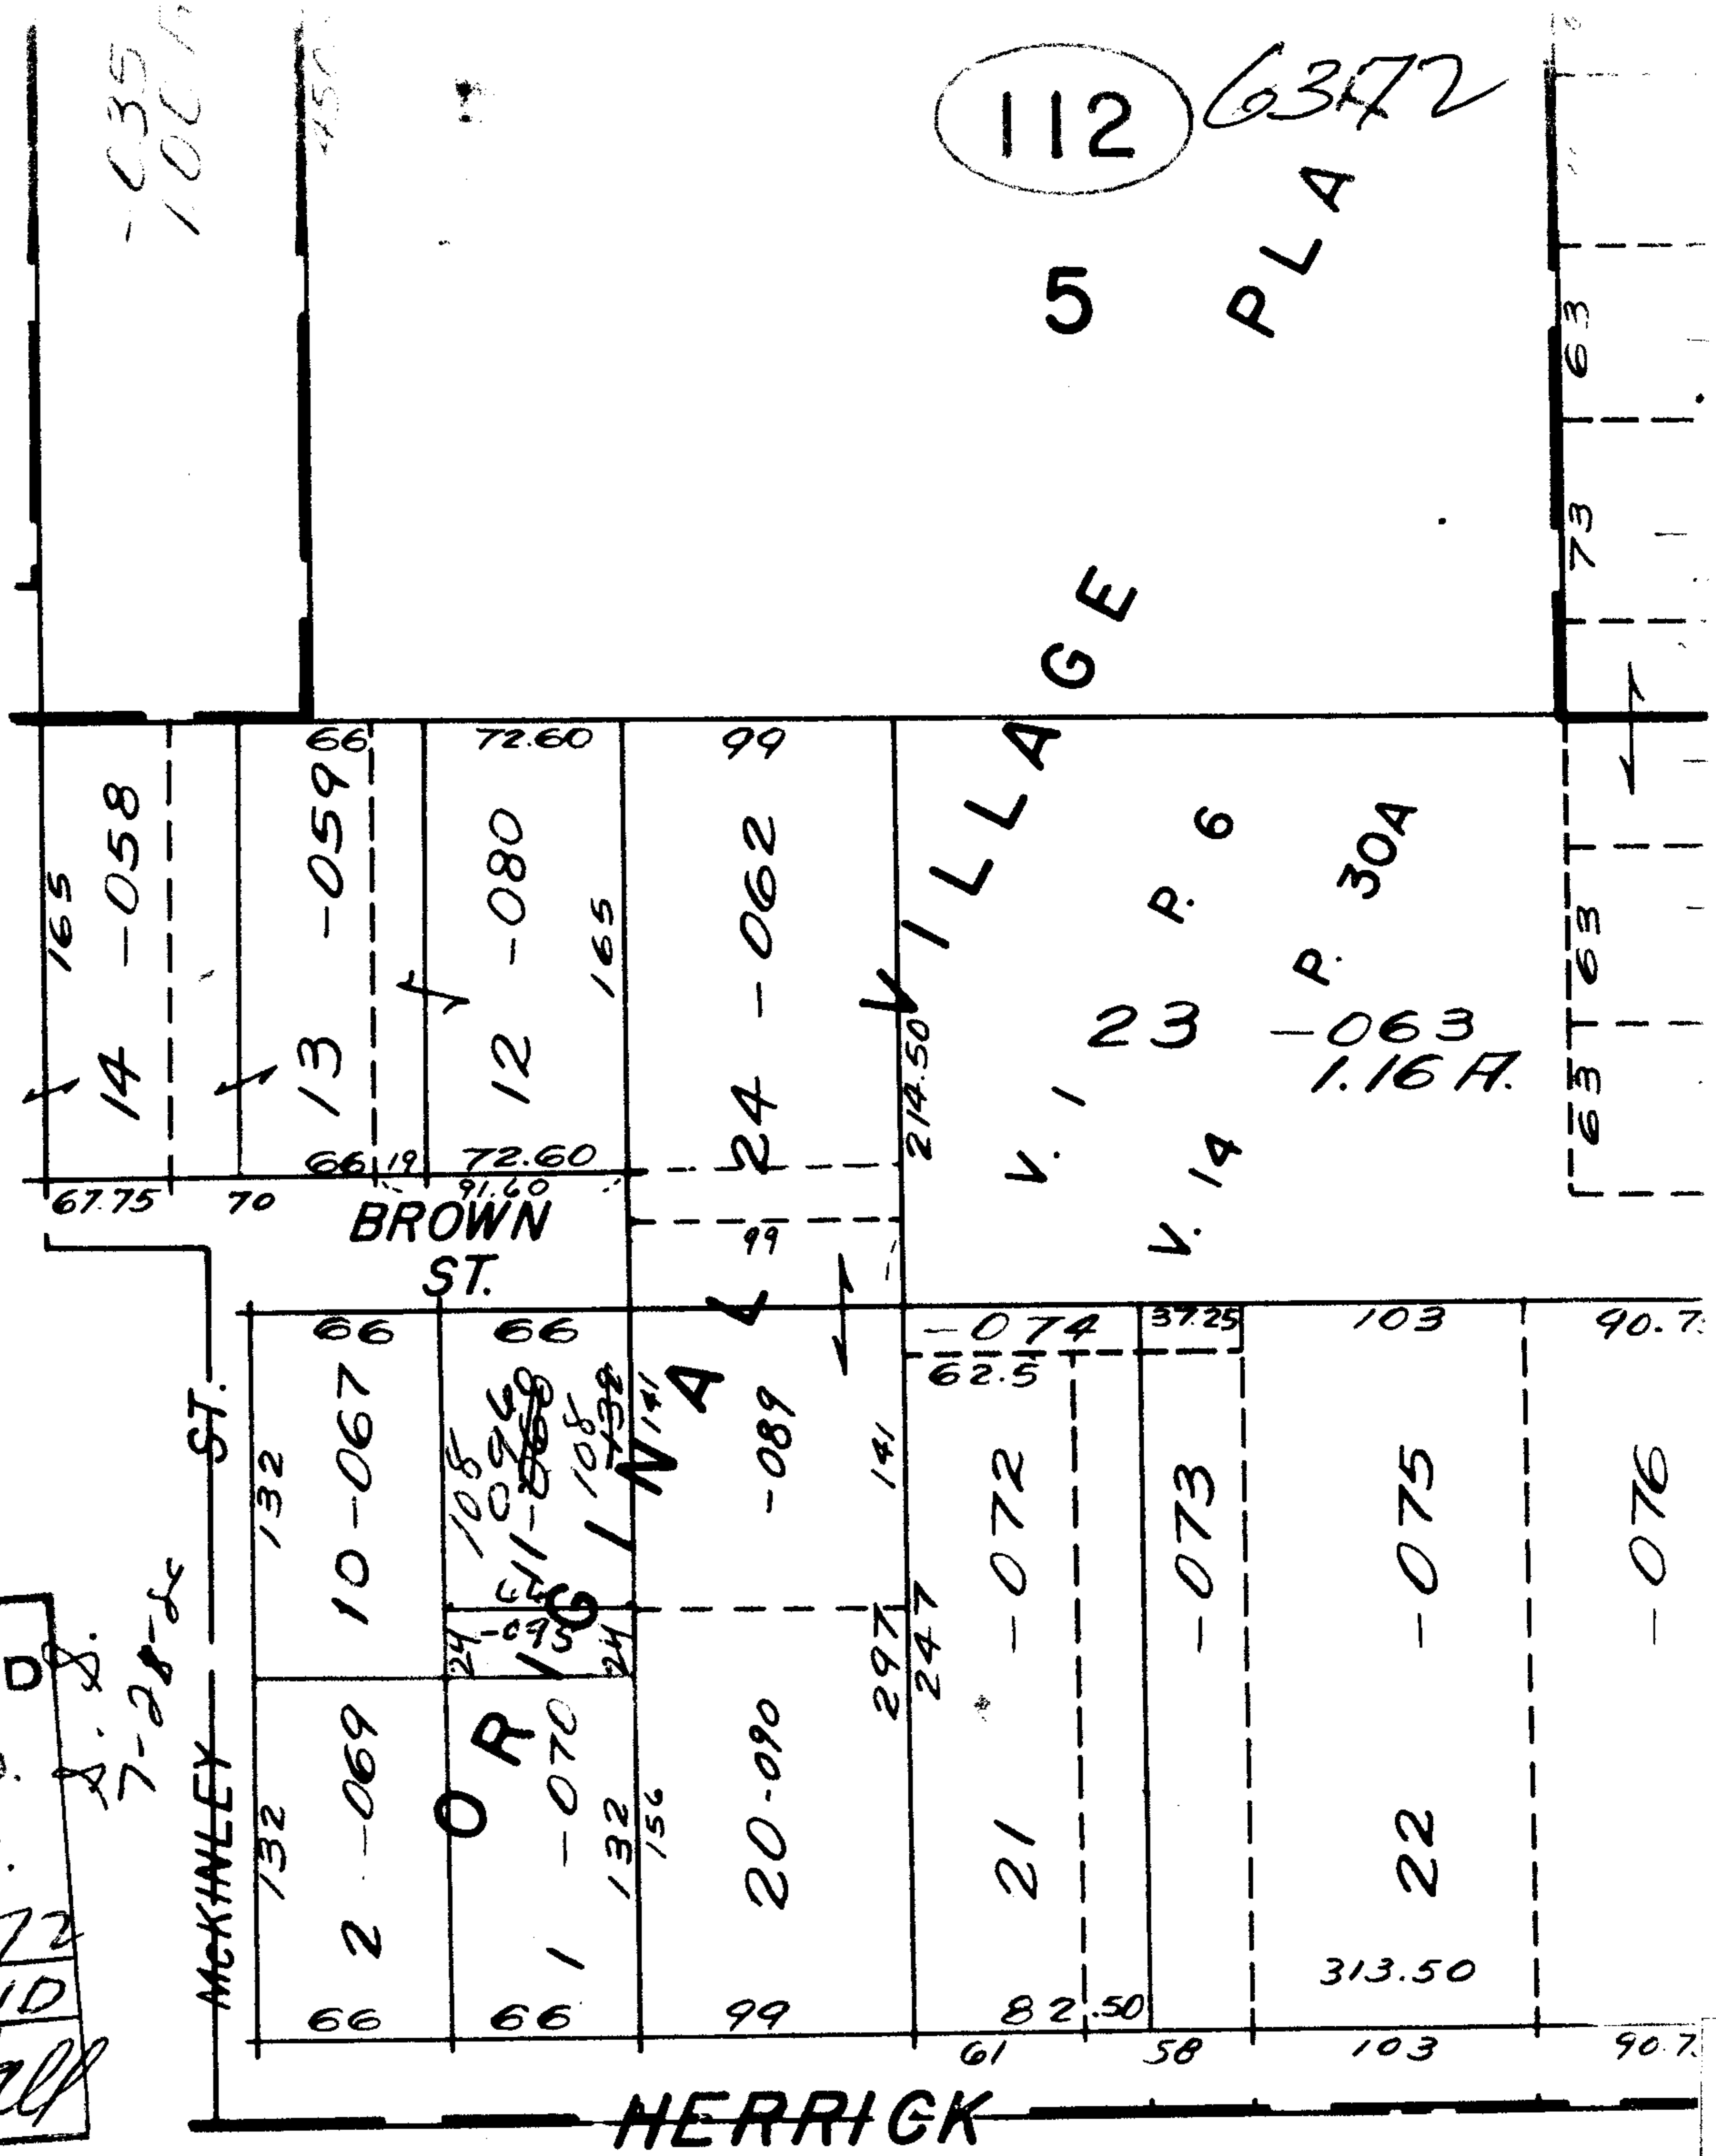

112
5
6372
PLA

18-00 021D

WELLINGTON
SCALE: 1" = 100'