

6386
HARTMAN
2
PG.
1-017
288.5
108
96.95
58.29


1.20 A.
517.40
1051.67
534.21

~~-033~~
~~-029~~
~~48.33 Ac.~~
17.45 Ac.

303
~~-032~~
380
88 Ac.

6386
APPROVED
LORAIN CO.
MAP DEPT.
DATE 10-5-72
16-00-019-04D
BY *[Signature]*

[Handwritten signature]
79856-L

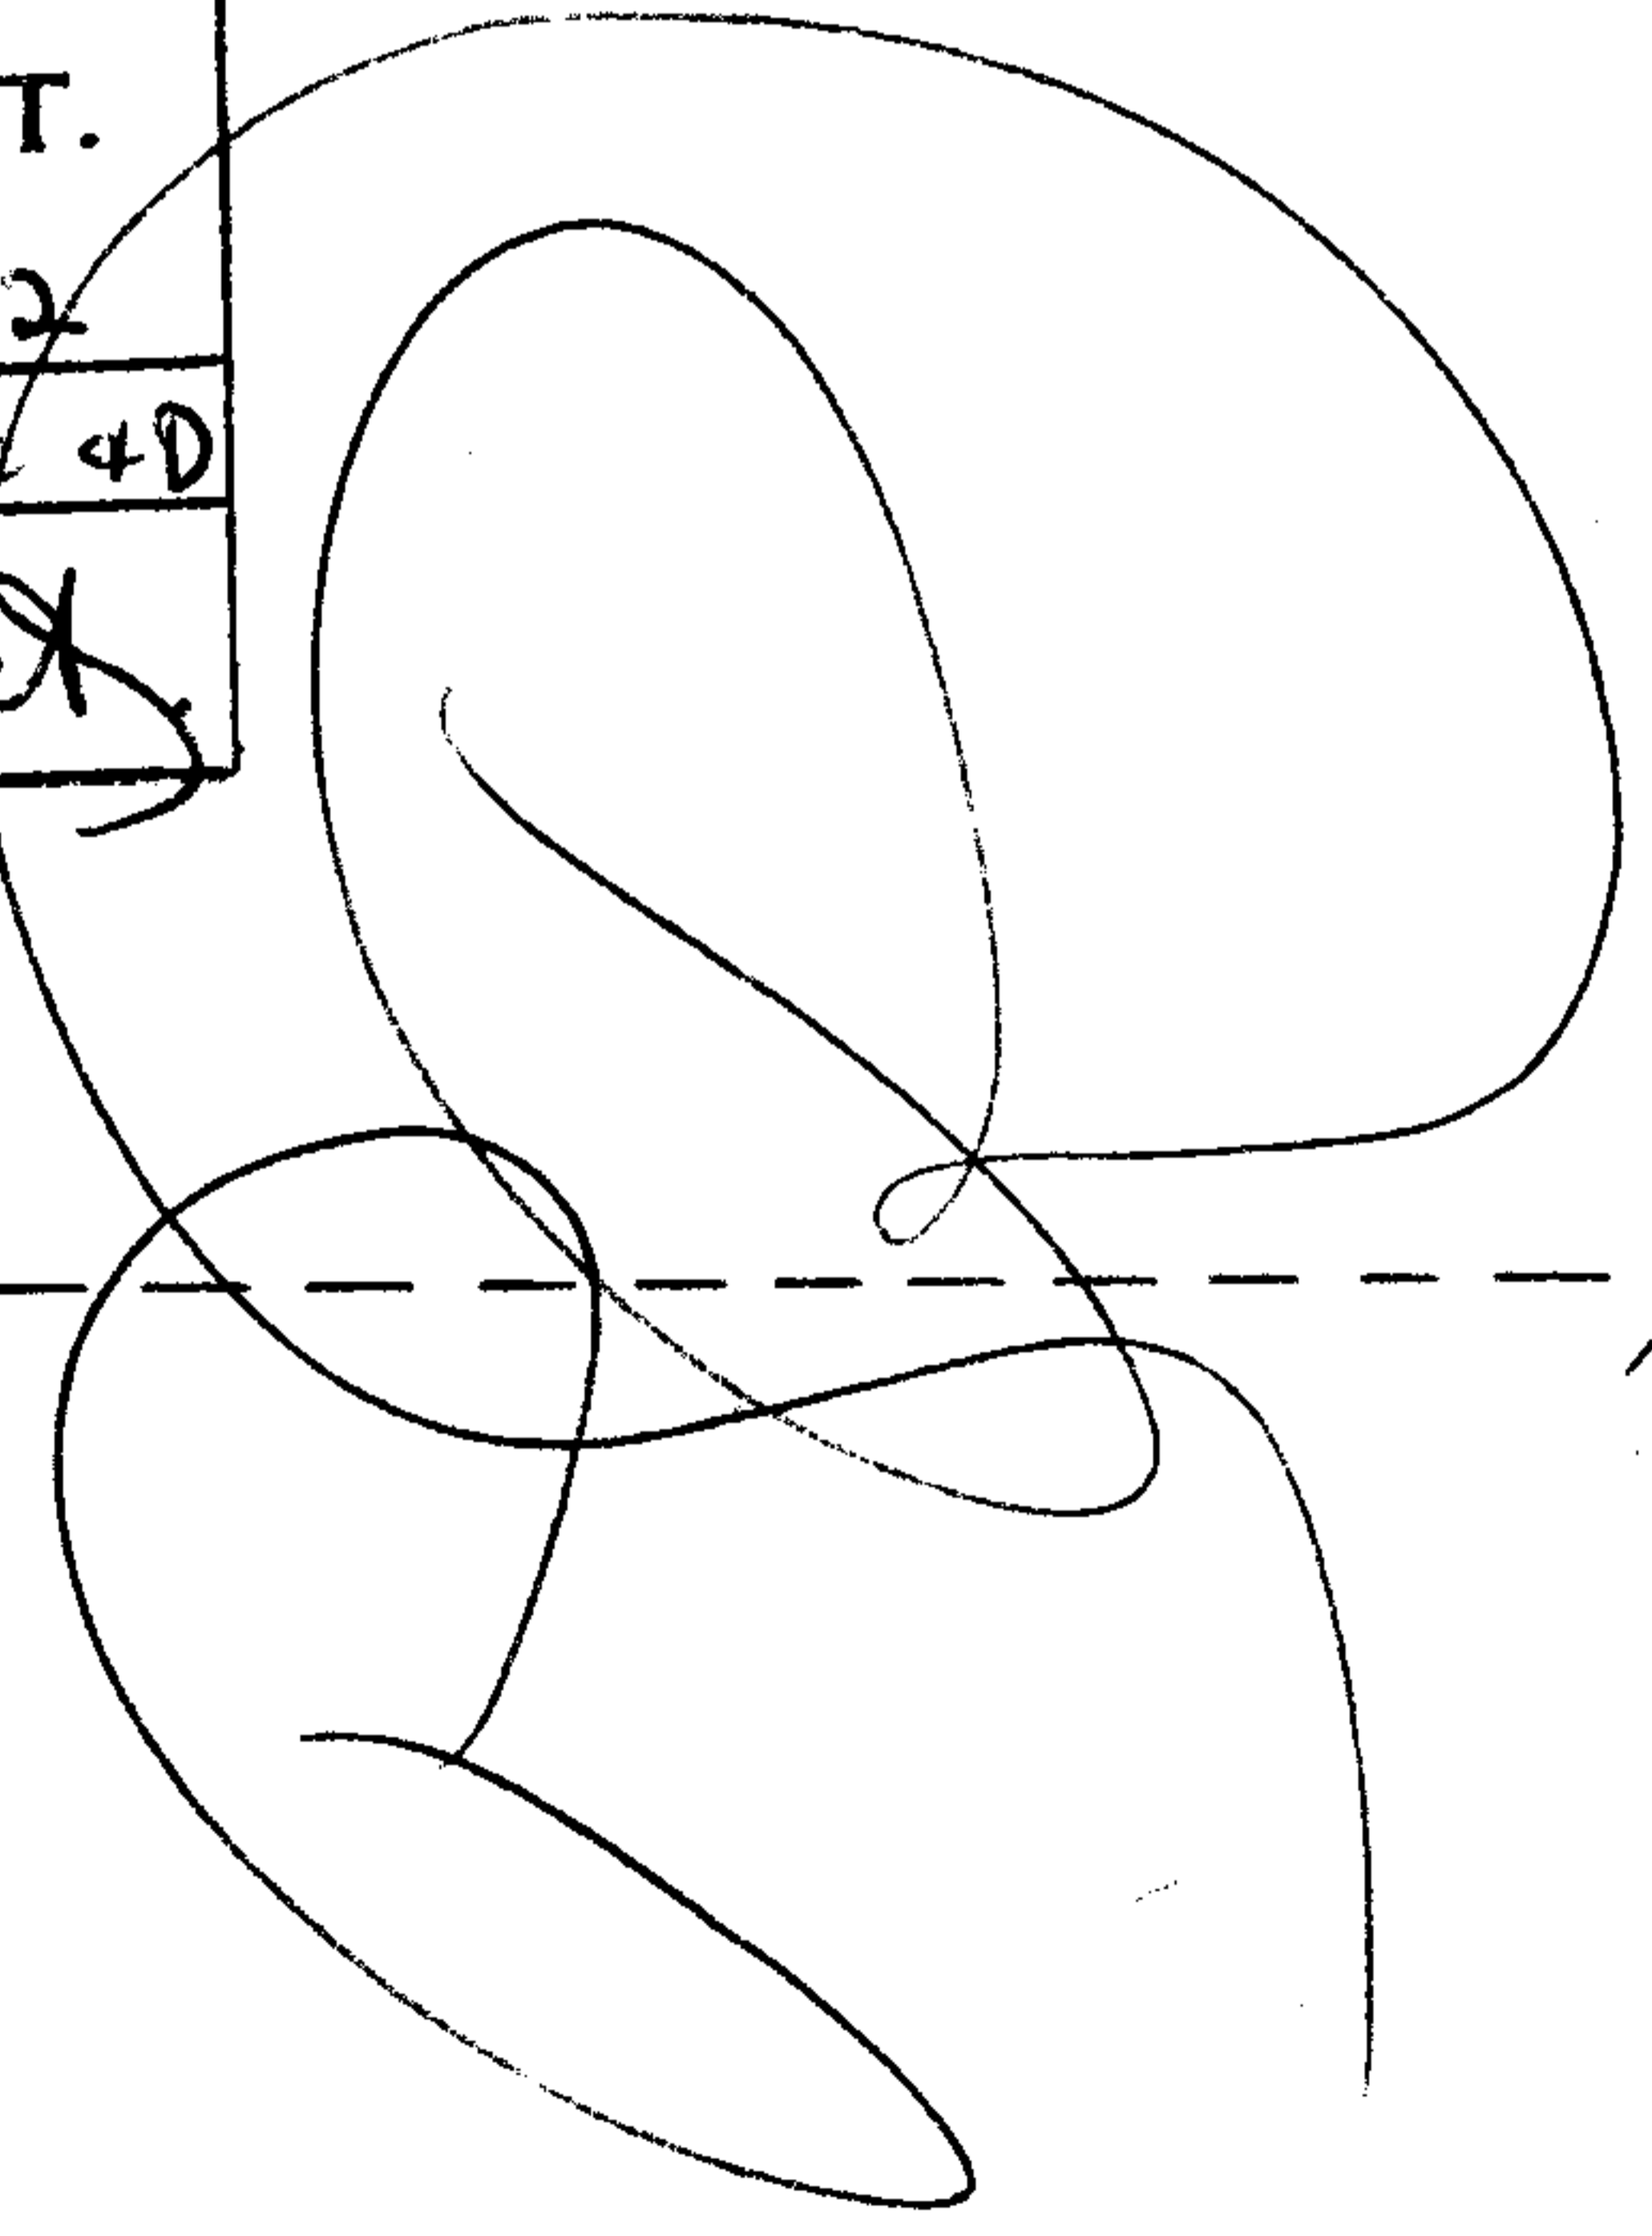

342
180

300
1611.30
1311.30
-009
1.37 A.
168.8
40726

1611.30
1311.30