


6394

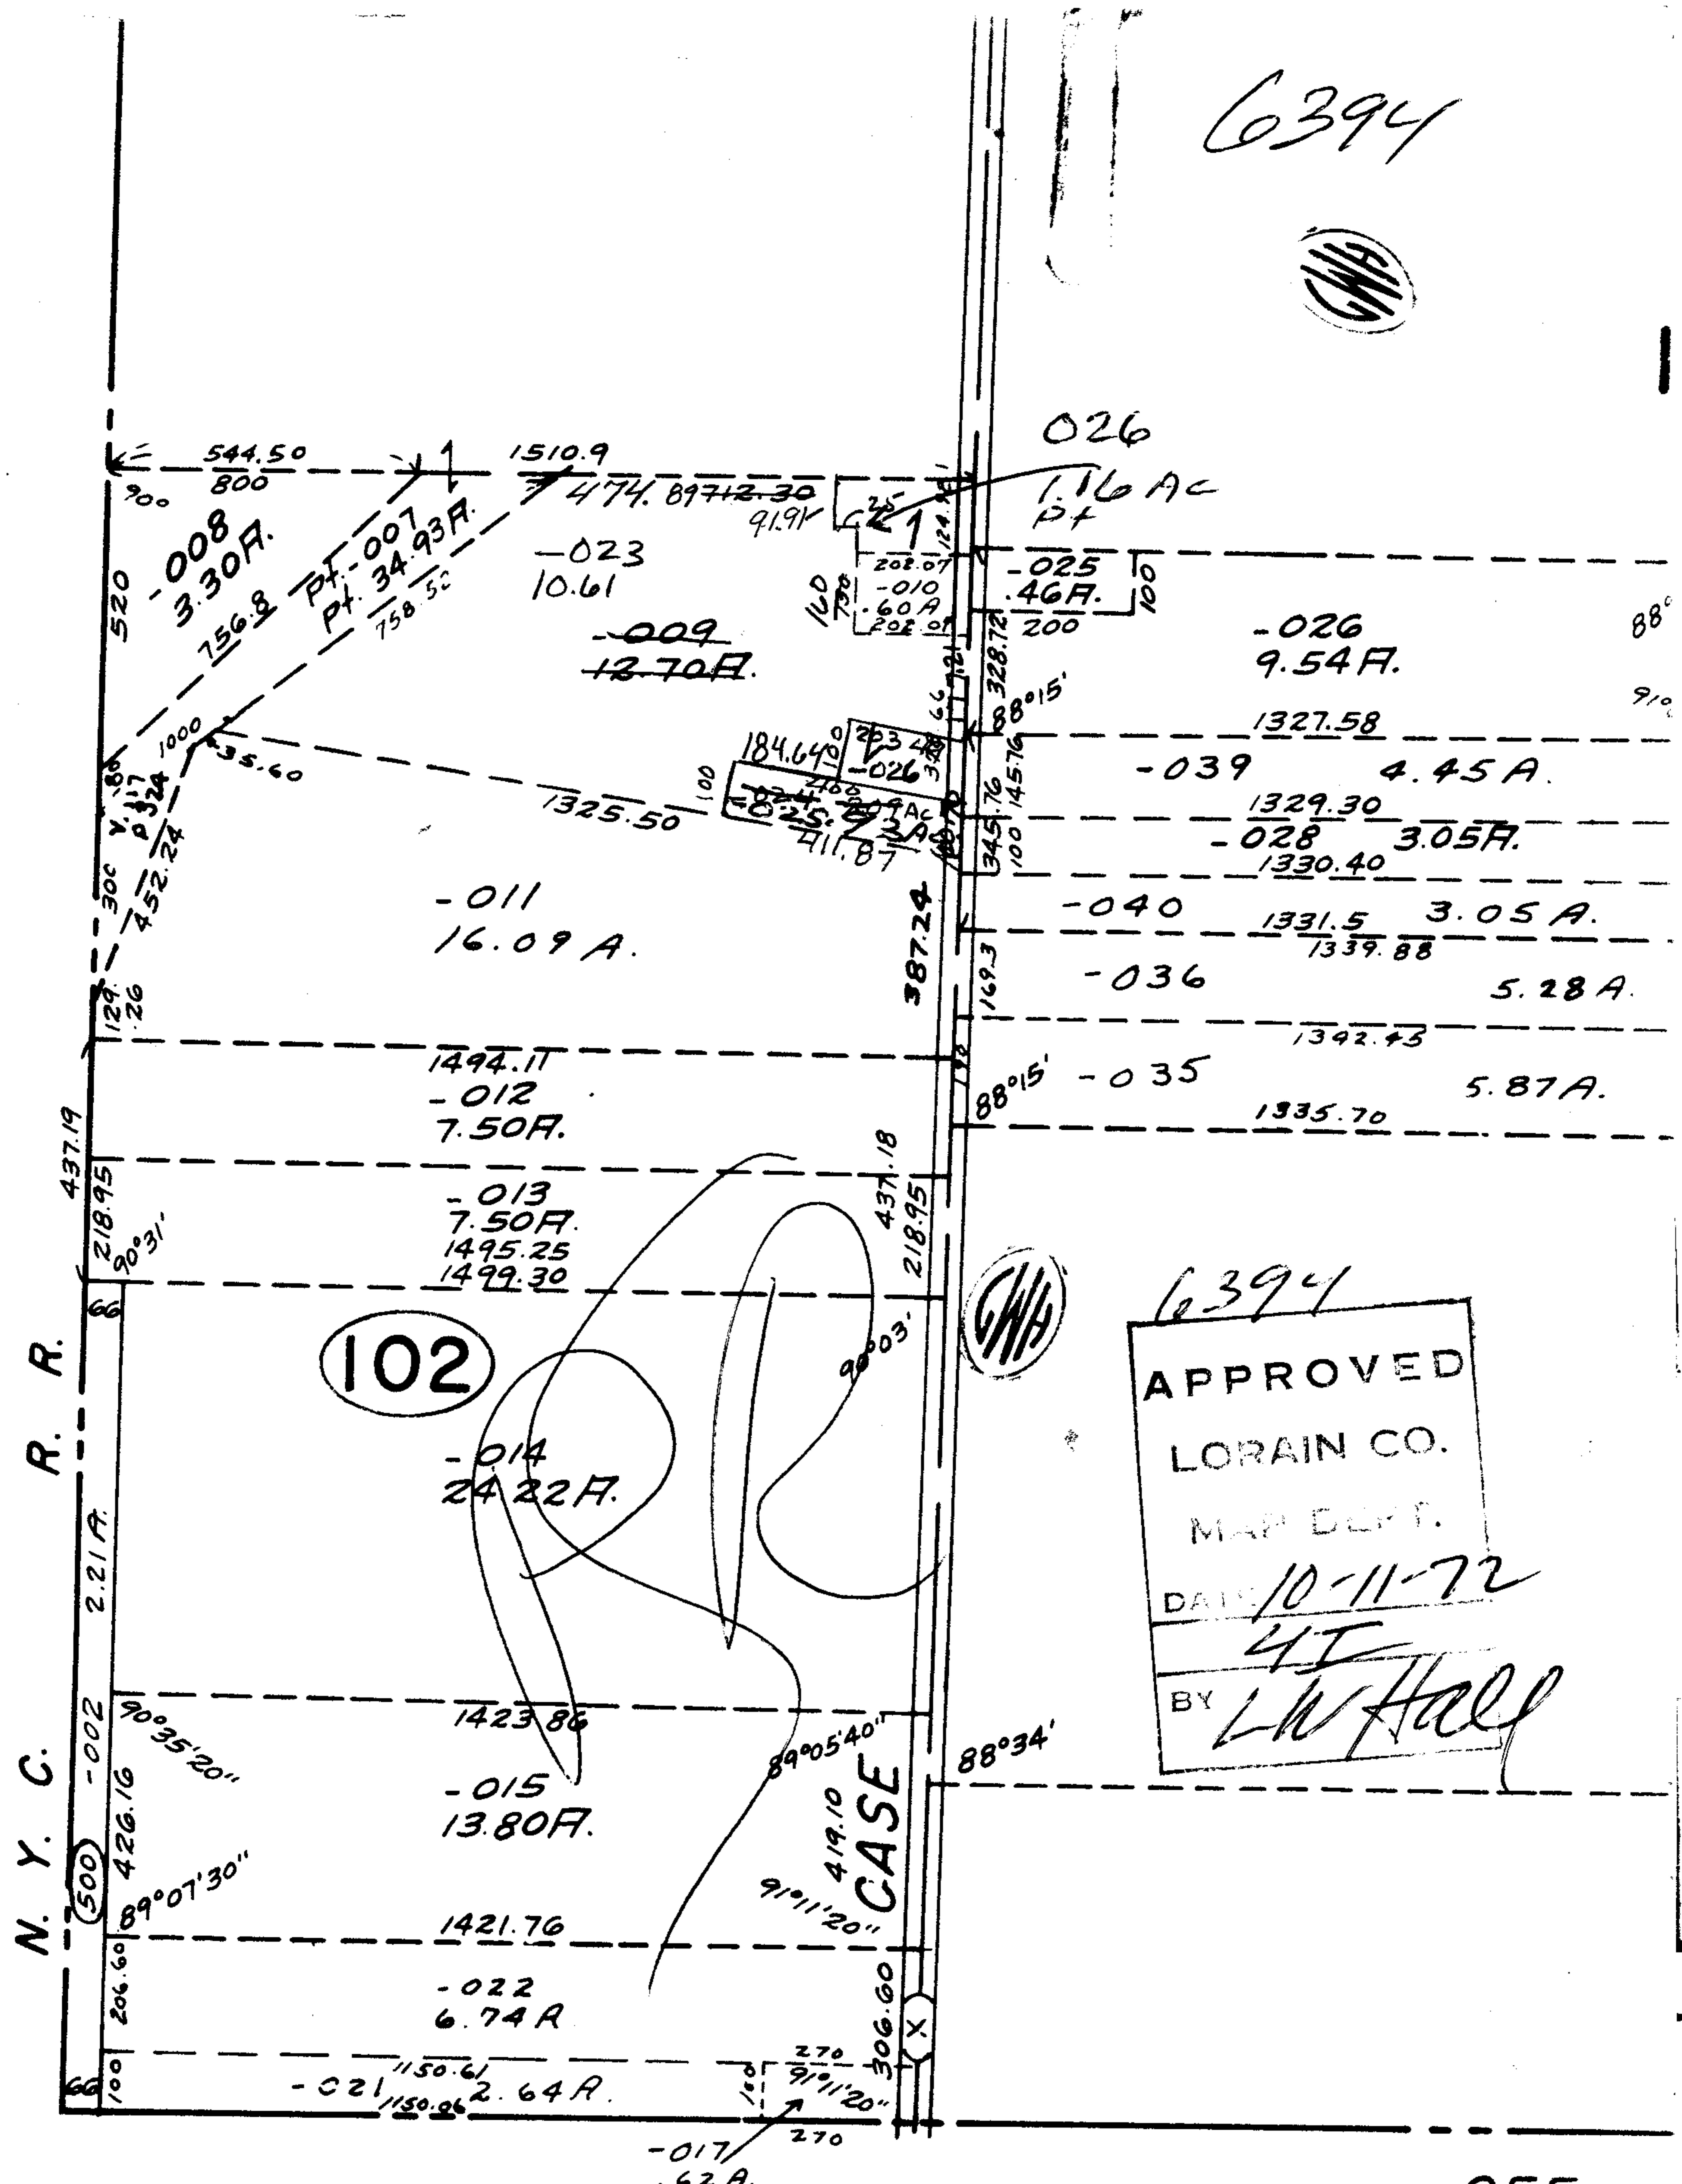

6394

APPROVED  
 LORAIN CO.  
 MAP DEPT.  
 DATE 10-11-72  
 BY *LW Hall*

SEE

*LI*

# AVON VILLAGE